


FASADÉ ~~NOED~~ ^{Sør}

Ales 77

NBle / Lindås kommune

110x120



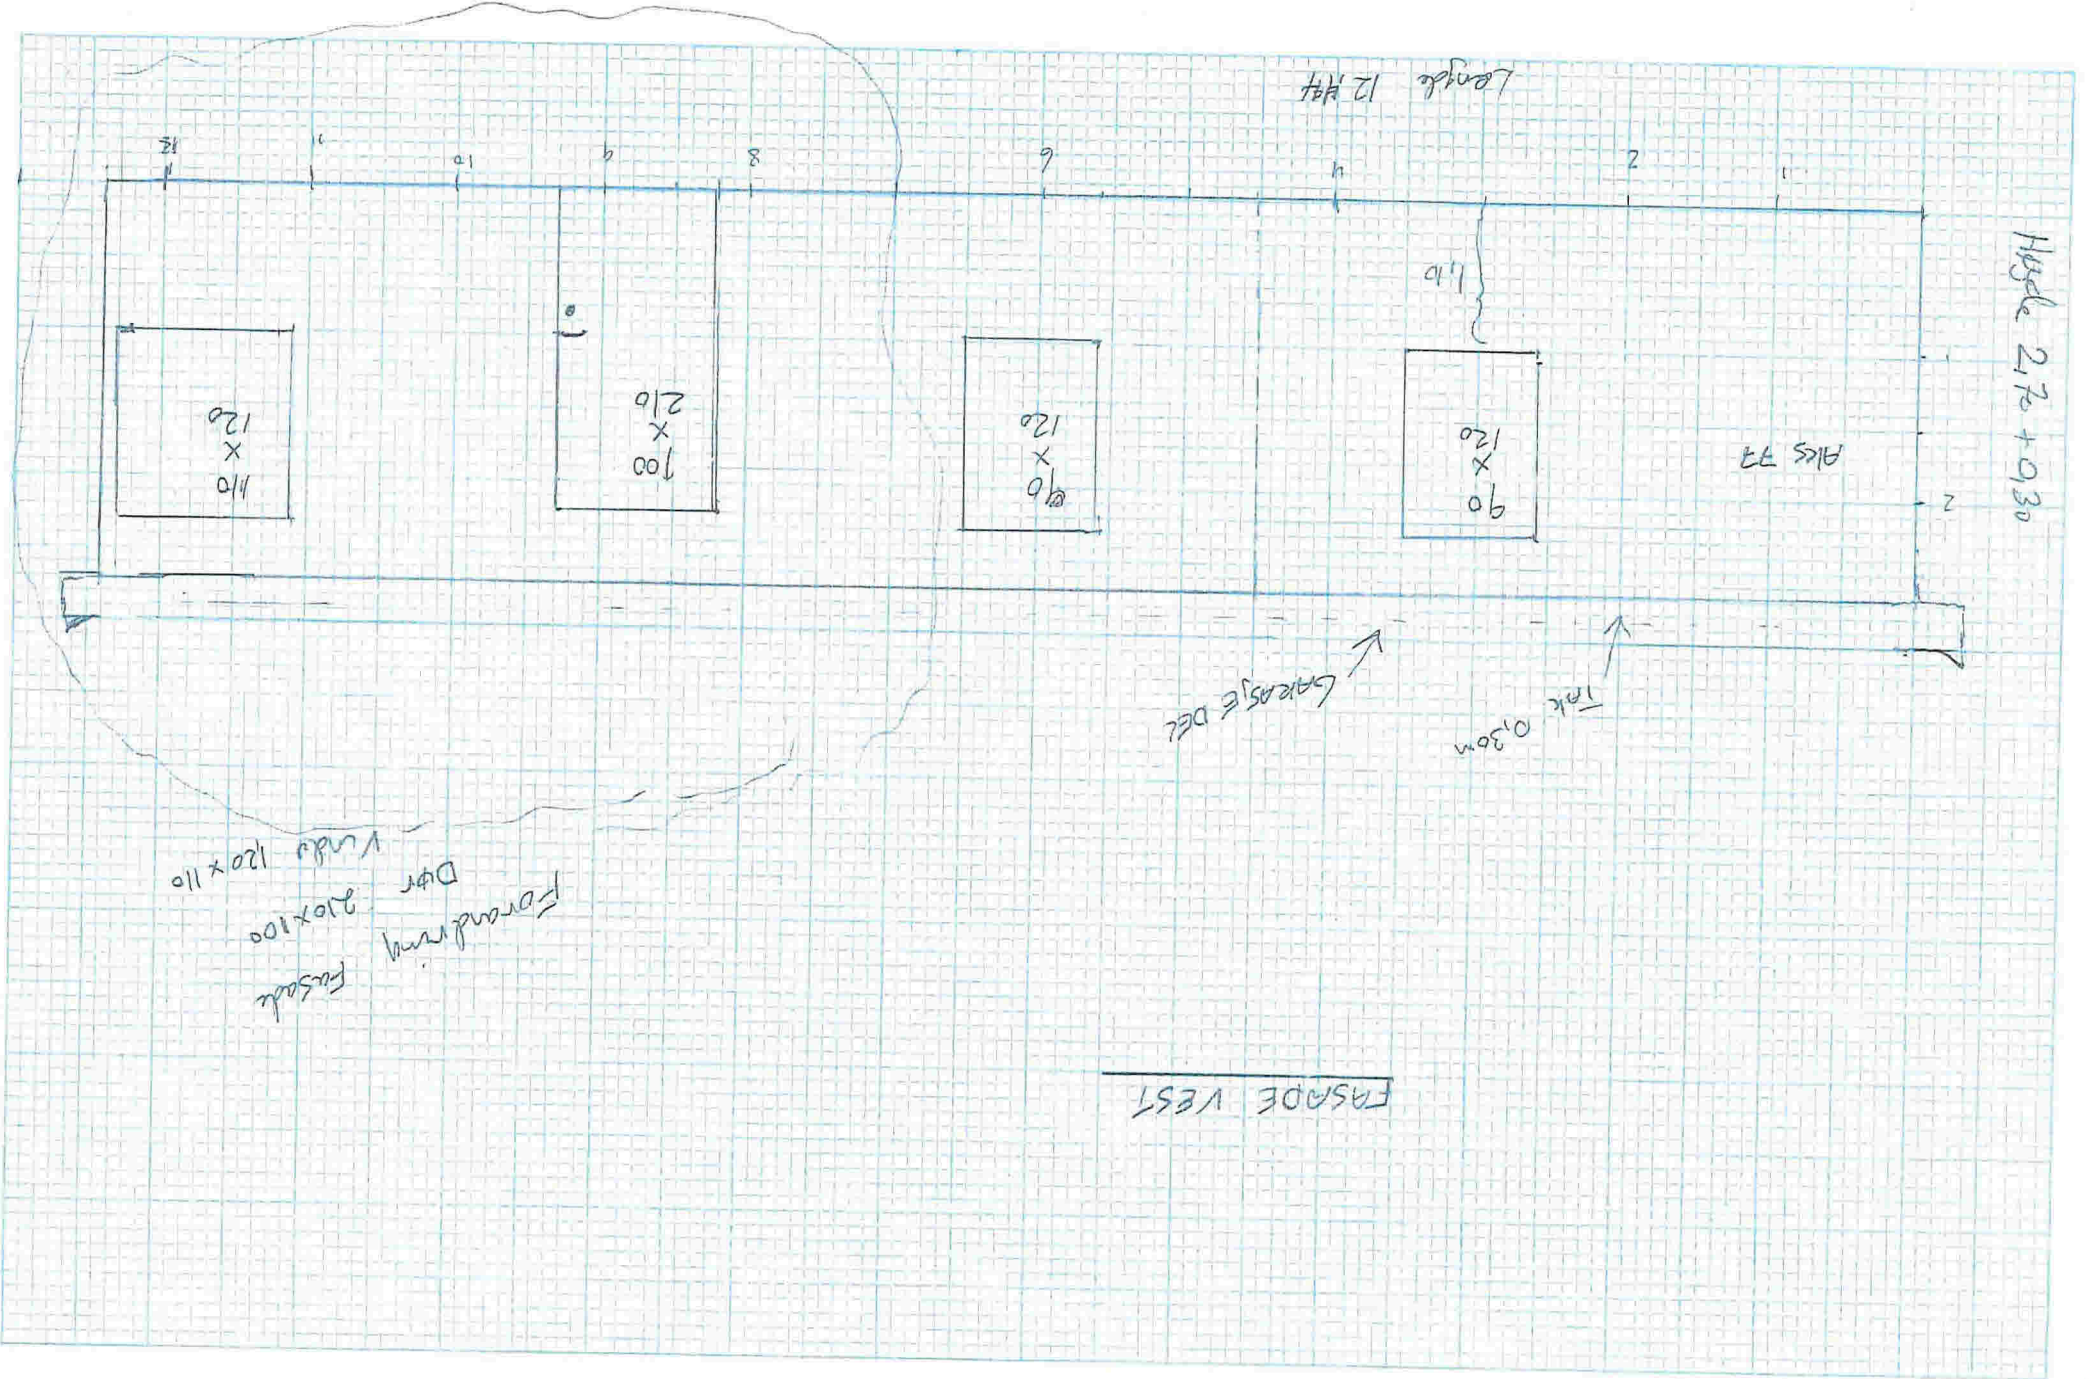








1,10
x
1,20

1,00
x
2,10

1,20
x
1,10

1,20
x
0,90

12

1









FASADE VEST

TAK 30cm

260cm



35

210cm

Vindloes
90x120

516




6150

186cm

33



9,29

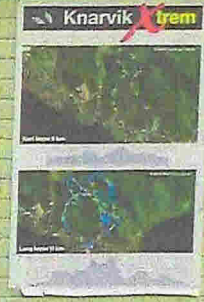

Høyde 2,70cm

LENGDE 12,44

16

FASADE ^{SØR} ~~ØST~~/VES

AKS 70 MBlo



LARASE

90
x
110

ny
dør

100x210

Knarvik Xtrem

110
x
120

110

x

120

110

x

120

BY
FASADE

FASADE ~~SØR~~ ^{SO NORD}

ny Dør
100x210

Ales 77

90x120

90
x
120



FASADE ØST

NBlc / Lindås kommune

Aks 77

