



HOH.

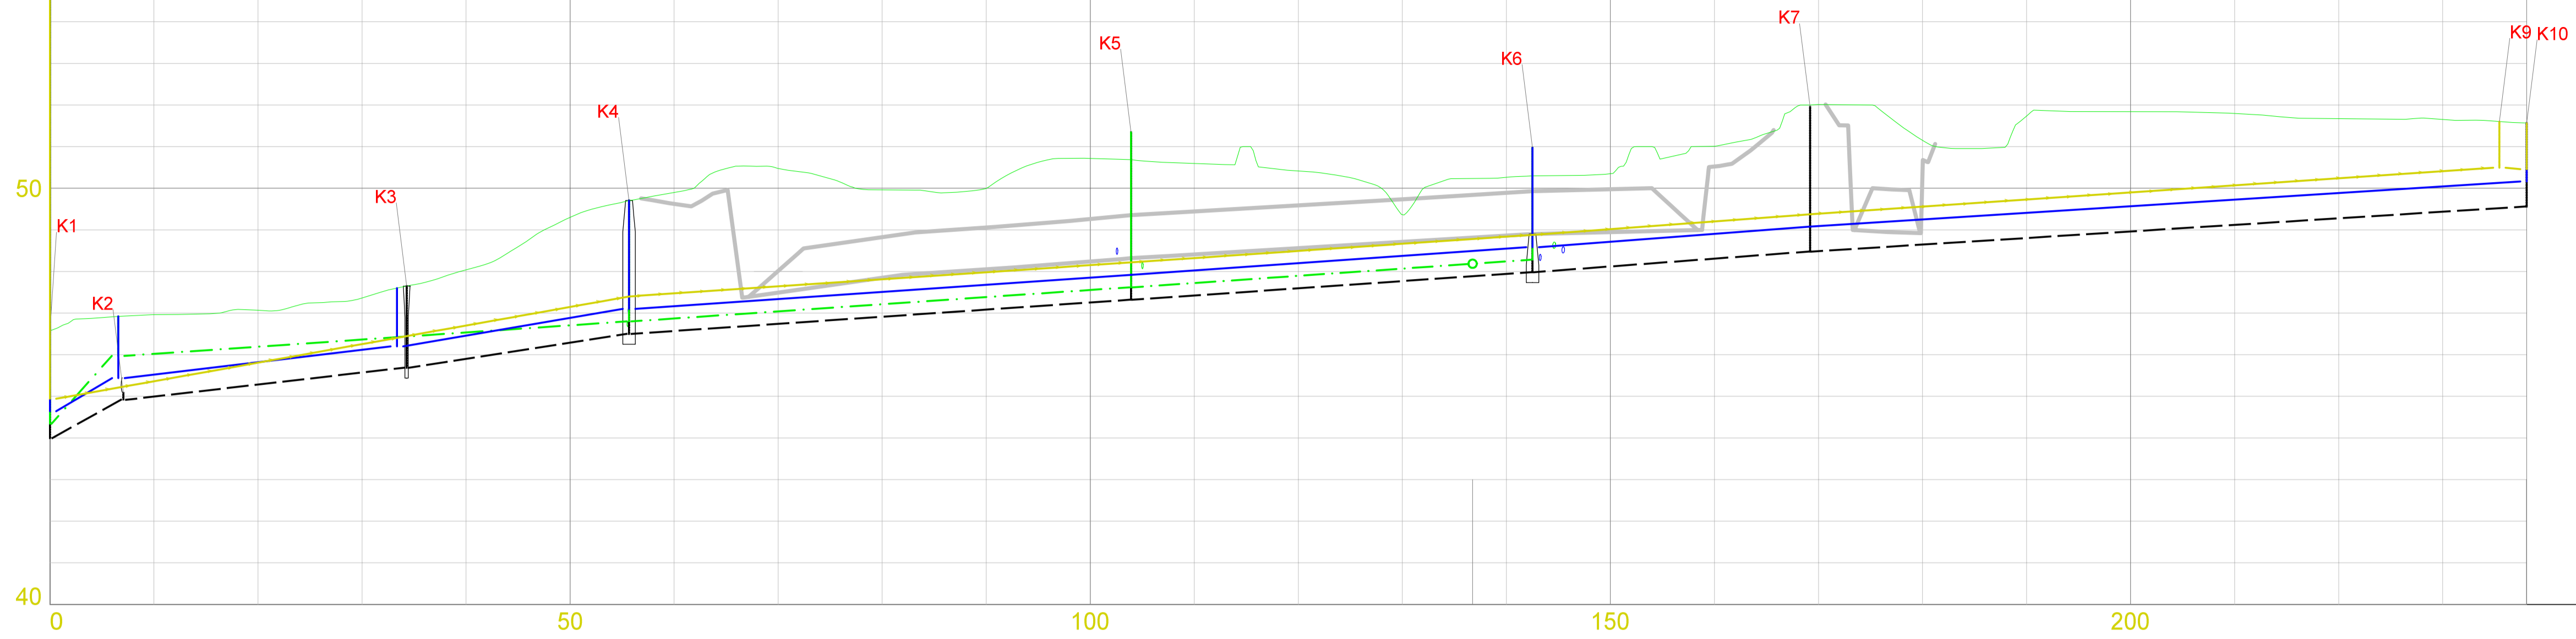

PROFIL NR.

HØYDE EKSISTERENDE TERRENG		46.57	46.96	47.07	47.36	46.04	49.30	48.90	50.48	49.96	50.00	50.72	50.59	50.41	48.37	50.26	50.35	51.01	52.01	51.15	51.73	51.84	51.79	51.67	51.65	51.57	
VANNLEDNING	DIM./TYPE	150			63											110											
	HØYDE UTV. TOPP	44.34	45.44		46.20											48.58											
	FALL	0m	26.8m		46.20											110											
SPILLVANN-LEDNING	DIM./TYPE	160										110															
	HØYDE INNV. BUNN	44.34	45.97		46.80							47.62			48.28												
	FALL	7.1m	27.2m		45.69							47.32			47.98												
OVERVANN-LEDNING	DIM./TYPE	400														110											
	HØYDE INNV. BUNN	44.00	44.92		45.69							47.32			47.98												
	FALL	129.6o/oo	28.4o/oo		37.9o/oo							17.0o/oo			17.2o/oo												
PUMPE-LEDNING	DIM./TYPE				63 PVC																						
	HØYDE UTV. TOPP	44.34			47.40							48.22			48.88												
	FALL		55.7m		47.40							16.9o/oo			38.6m												
				44.1o/oo											17.1o/oo												

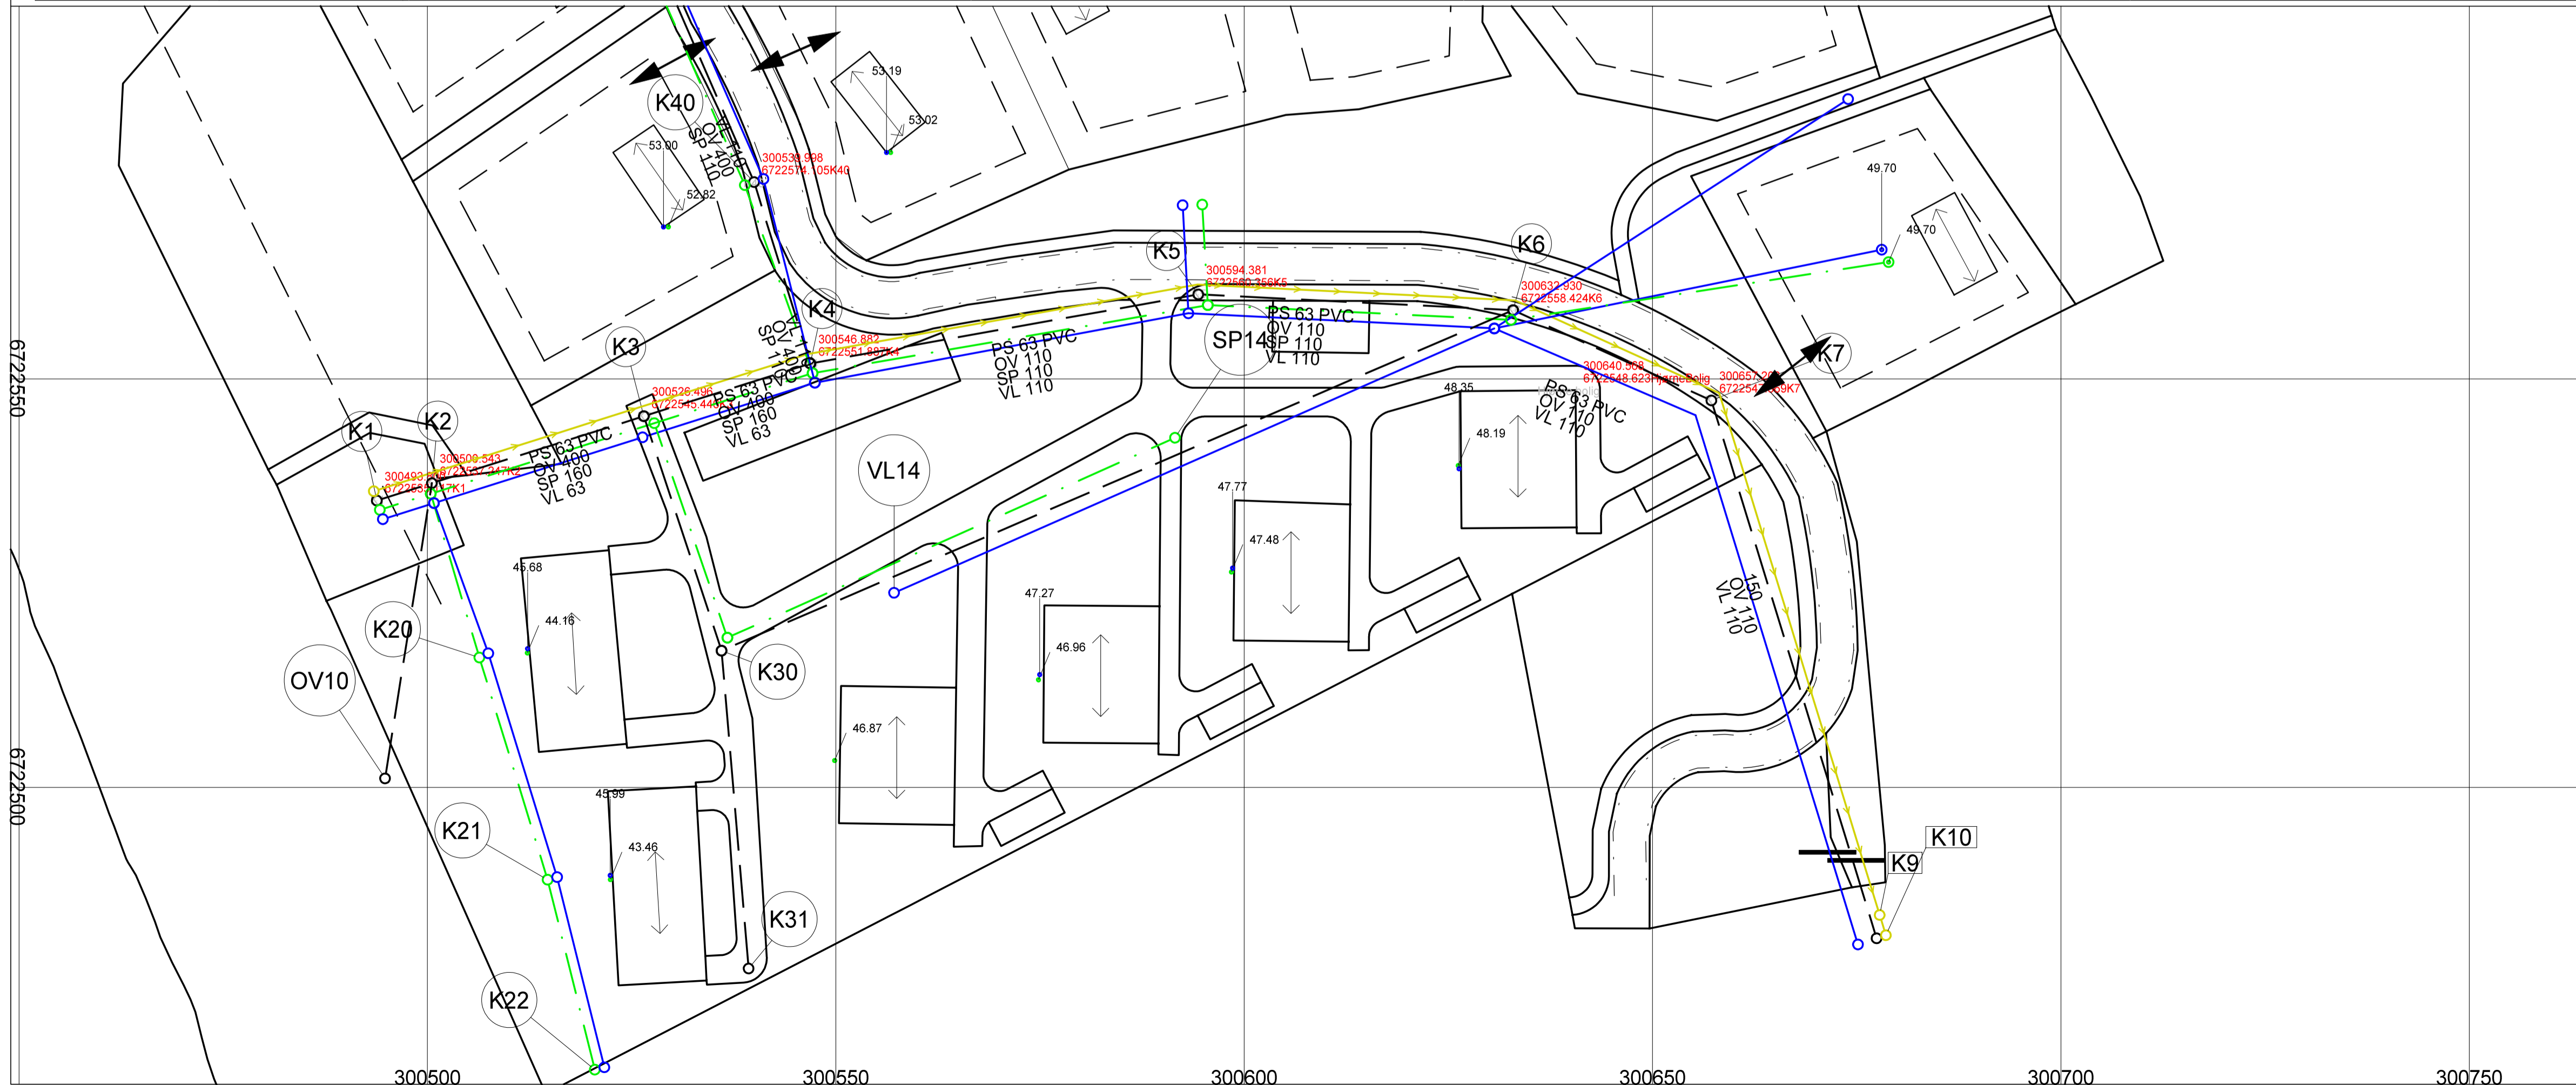

13.06.2014

Hjelmåsen AS			
2004098			
Geir Styve			
14.08.2013		1:400, 1:100	
Lengdeprofiltegning VA			
		210	
		Helleåsen	