



- Rønningsvei
- ET 30
- ① ET 30-LSa
- ② ET 30-Sa

15.2.18
 RB

135/1
 12/100 123/12

SMEDHOLMEN	18.03.2017	HPS
HØVEDHUS	1:100	A3 HPS
PLANER	5100/88	HPS
RAMBØLL	2.100	




- Rønningsvei
- E1 30
- Ⓛ E1 30-CSa

15.2.18
RB

SMEDHOLMEN	8.03.2011	HFS
HOVEDHUS	1:100 A3	HFS
PLANER	5100188	HFS
RAMBØLL	2.100	





VEDLEGG E3

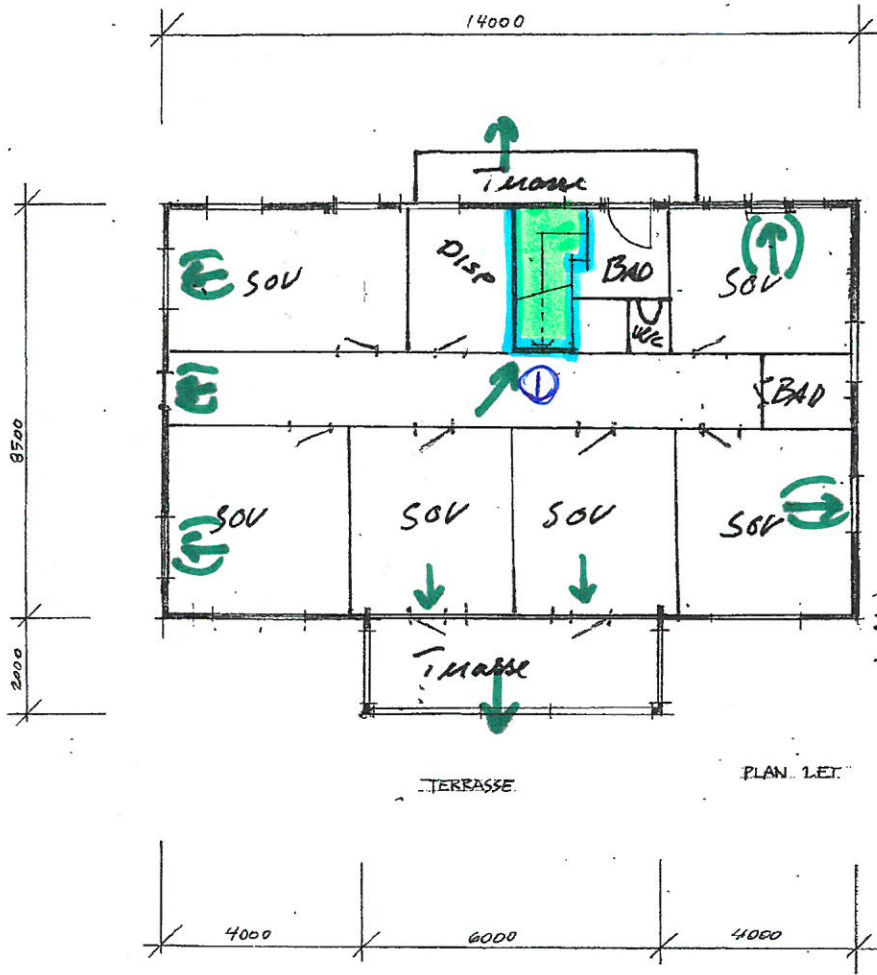

- Rømningsretning
- Rømningsvindu
- Rømningsvei
- ET 30
- ET 30-CSa

15.2.18
 RB

SMEDHOLMEN	1808.2017	HPS
HOVEDHUS	1:100	A3 HPS
PLANER 2	5100188	HPS
RAMBØLL	2.700	

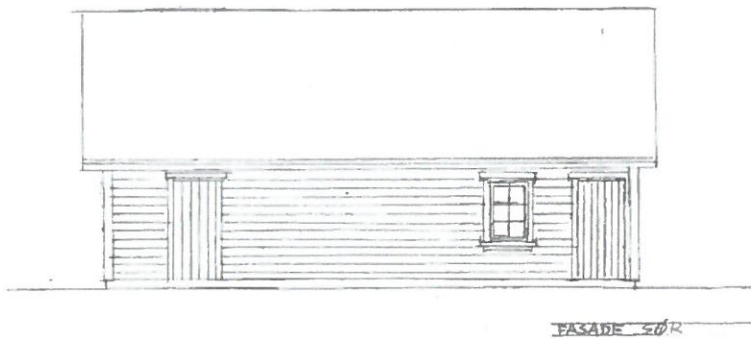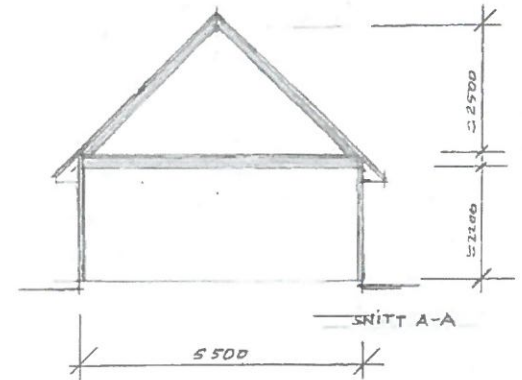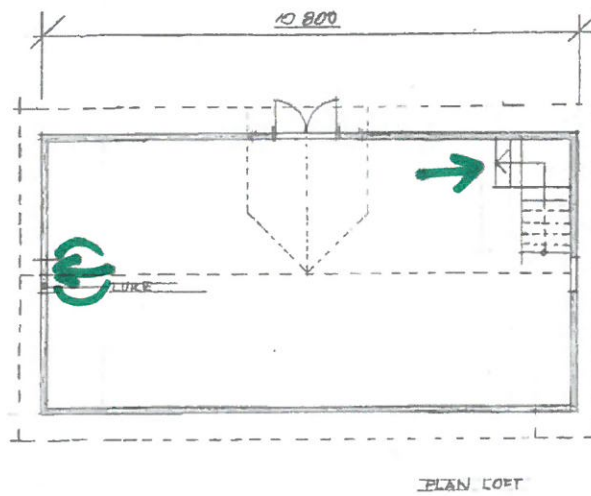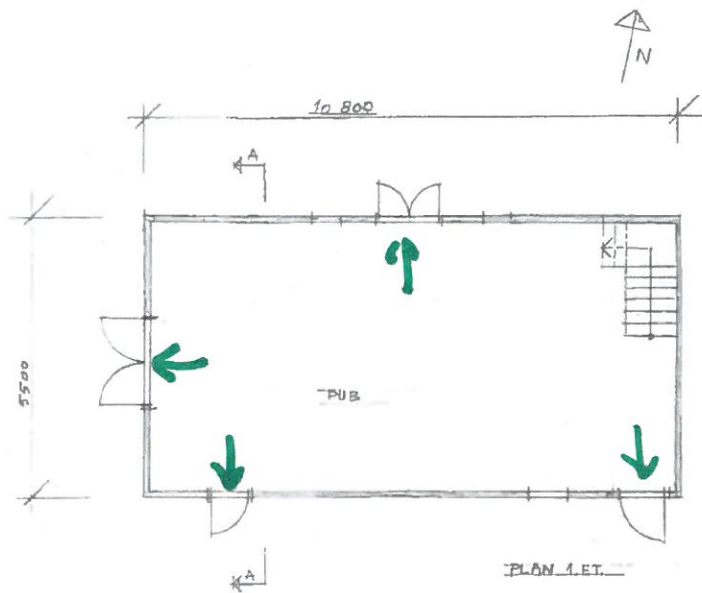

15.2.18


OB

UTMARK

SME HOLMEN

PLAN OG SNITT

Målestokk	Tegnet av	Dato	Revidert av	Dato	Tegningsnummer
1:100	HFS	14.02.2018			2.100
Format					
A3					

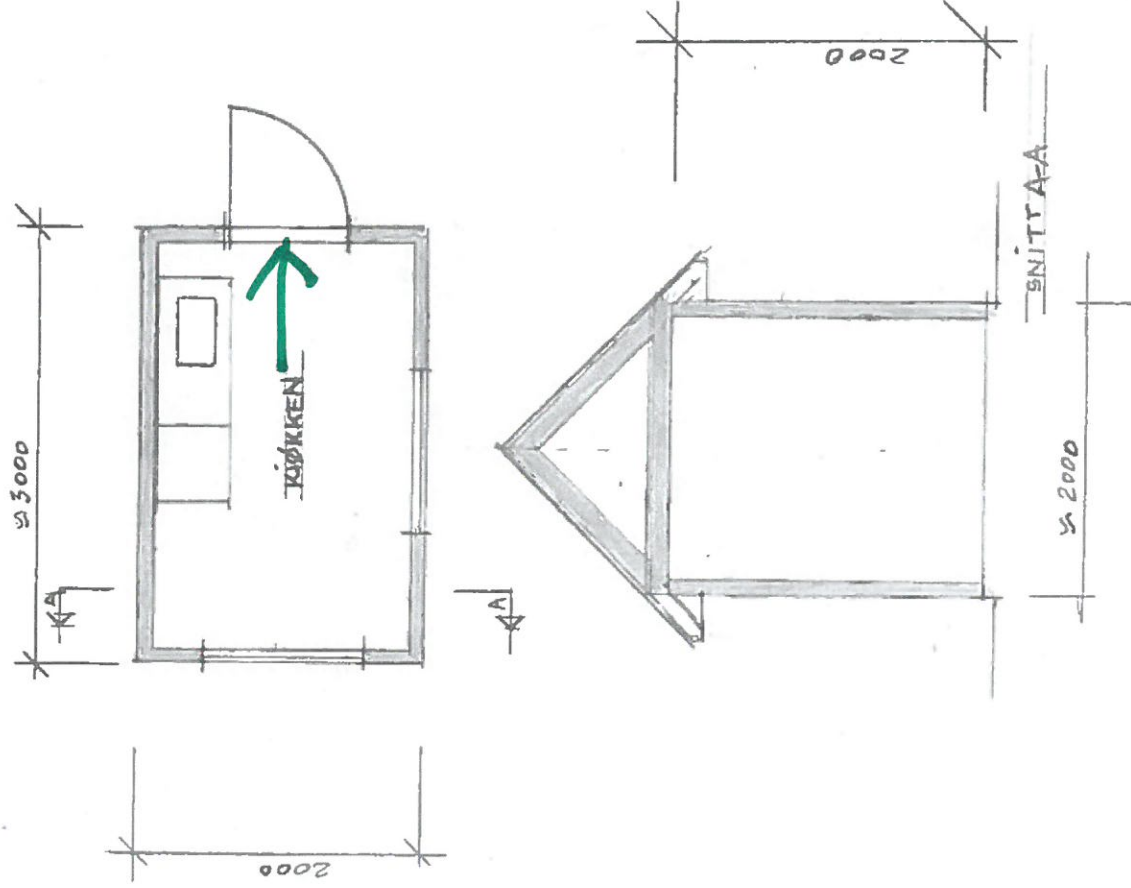

15.2.18
DB

SMERHOLMEN KÖKKENBYGG PLAN OG SNITT	Målestokk 1:50	Tegnet av HFS	Dato 14.02.2018	Revidert av Date	Tegningsnummer 2.101
	Formet A4				