


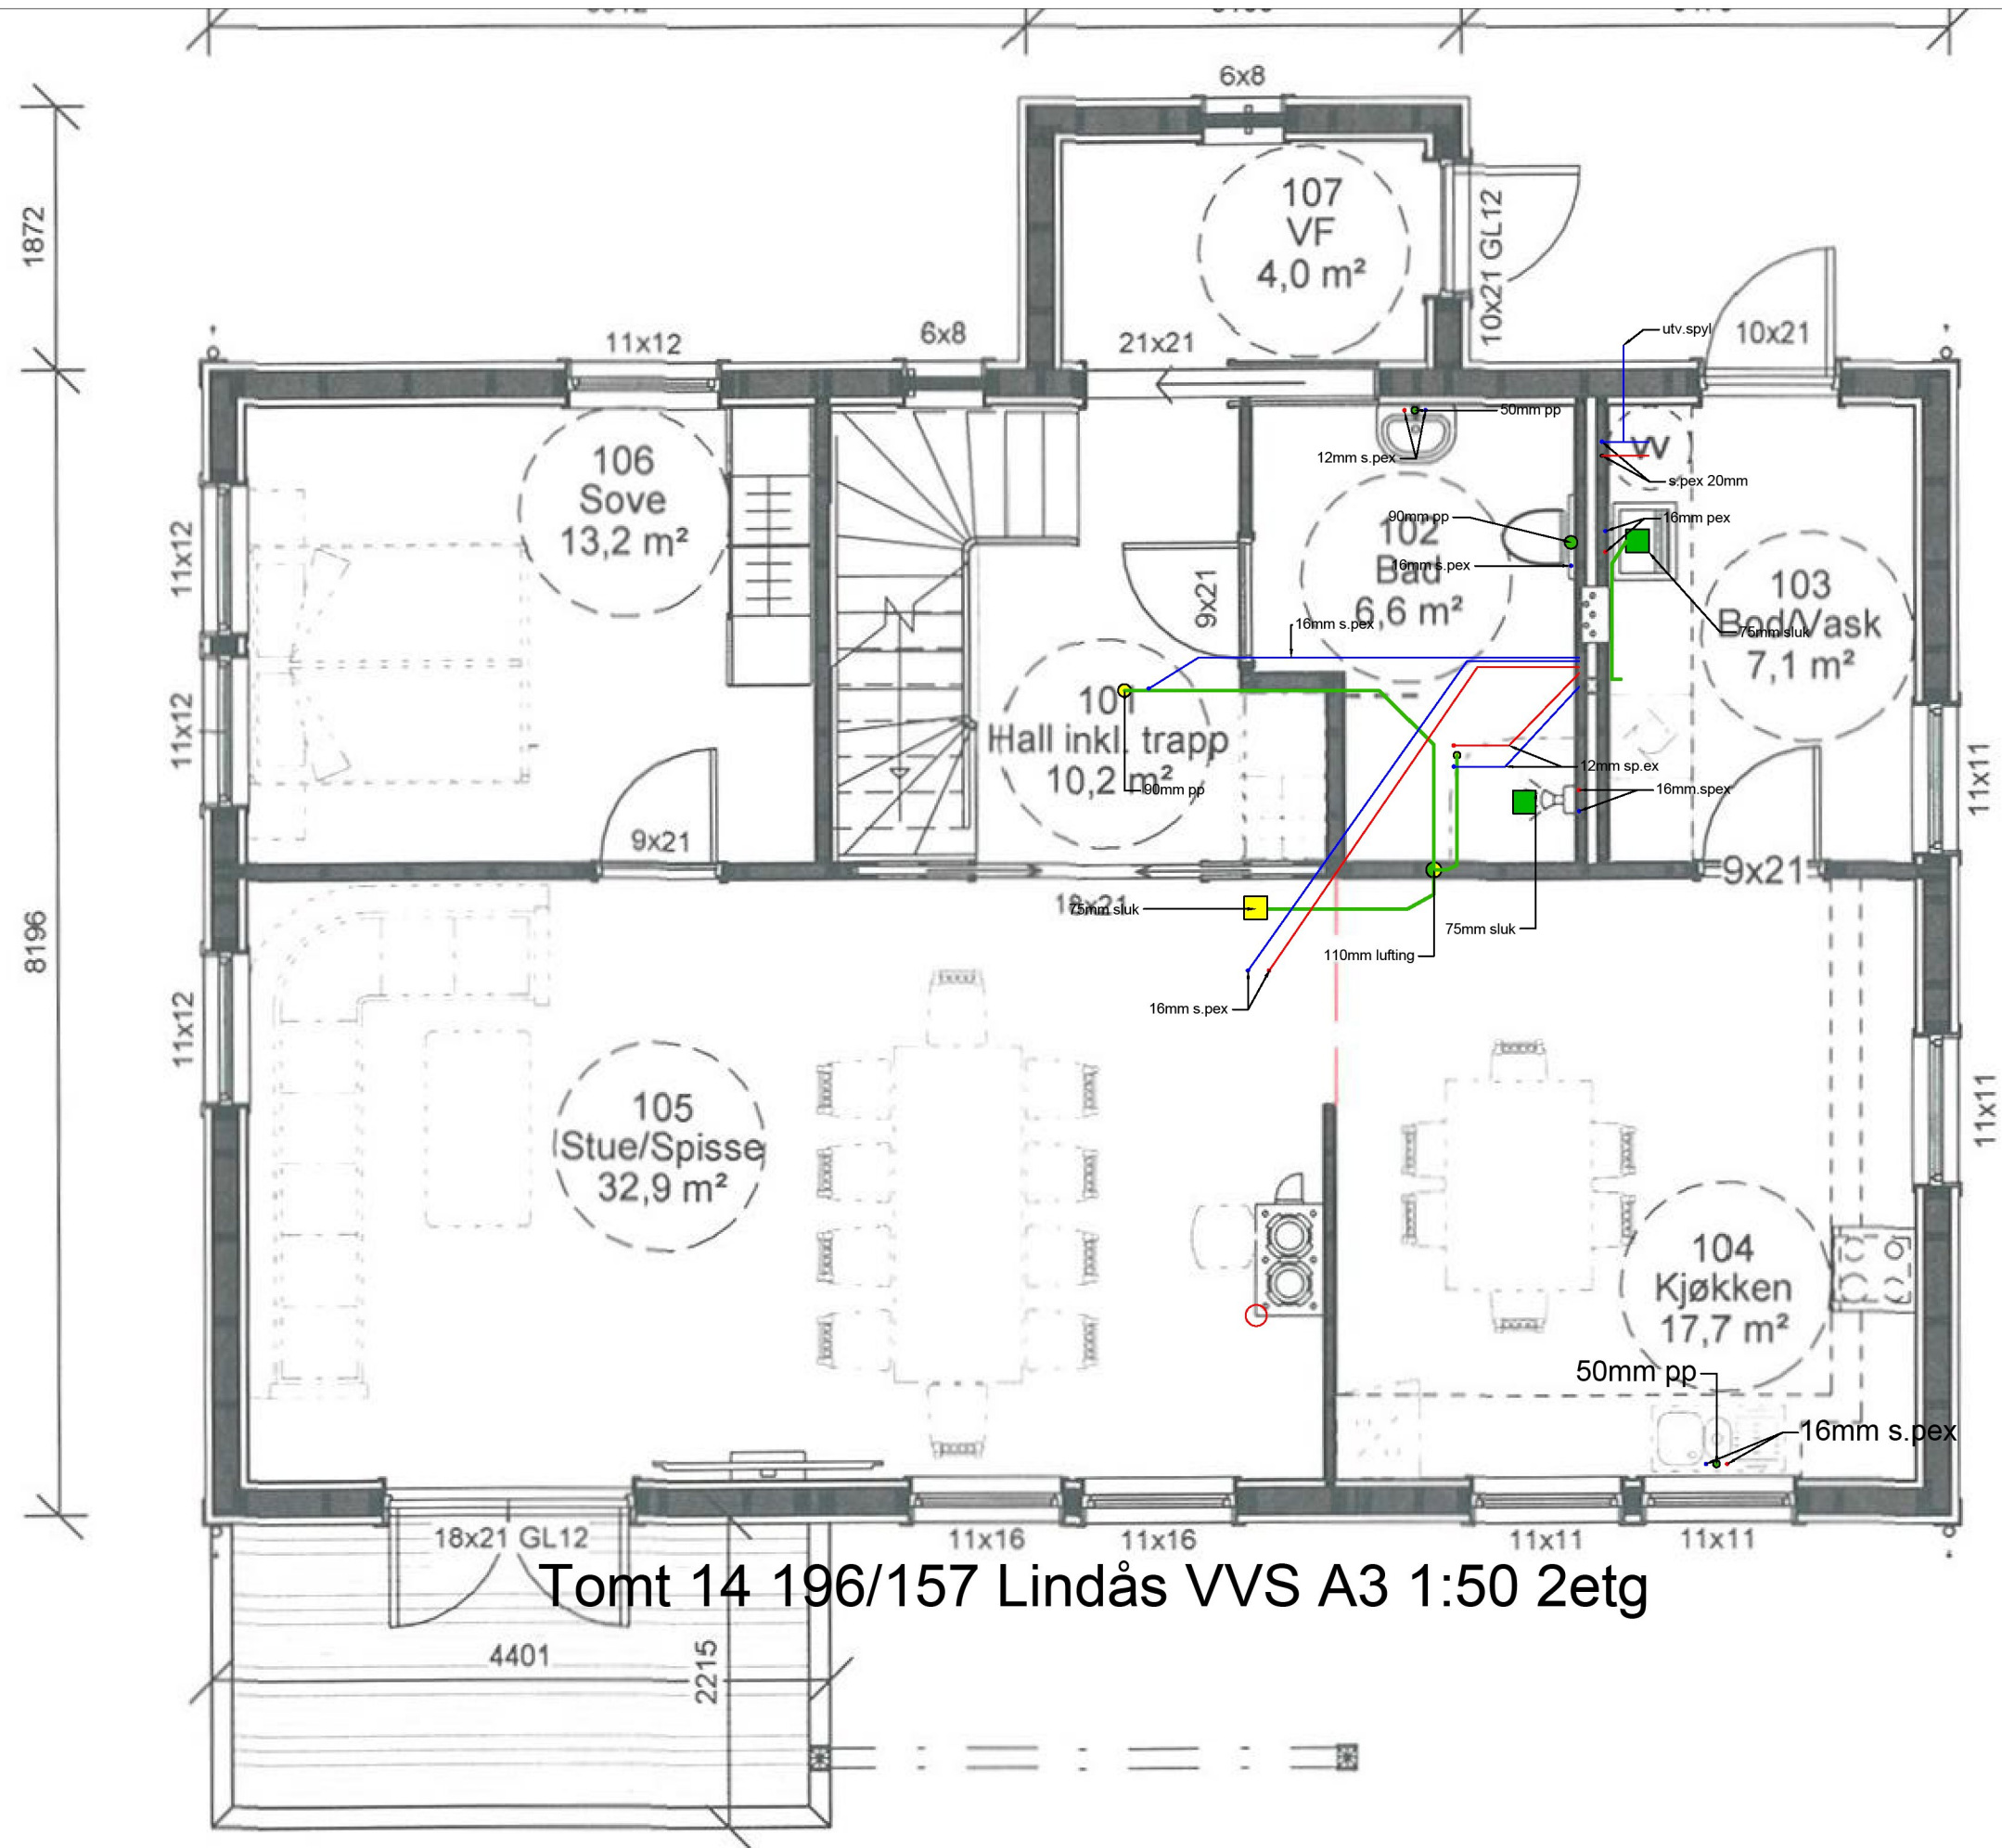

Tomt 14 196/157 Lindås VVS A3 1:50 2etg