




Stendal VVS AS

Blombakken 1 - 5911 ALVERSUND

E-post: sten-vvs@online.no

Org.nr. 980 626 180

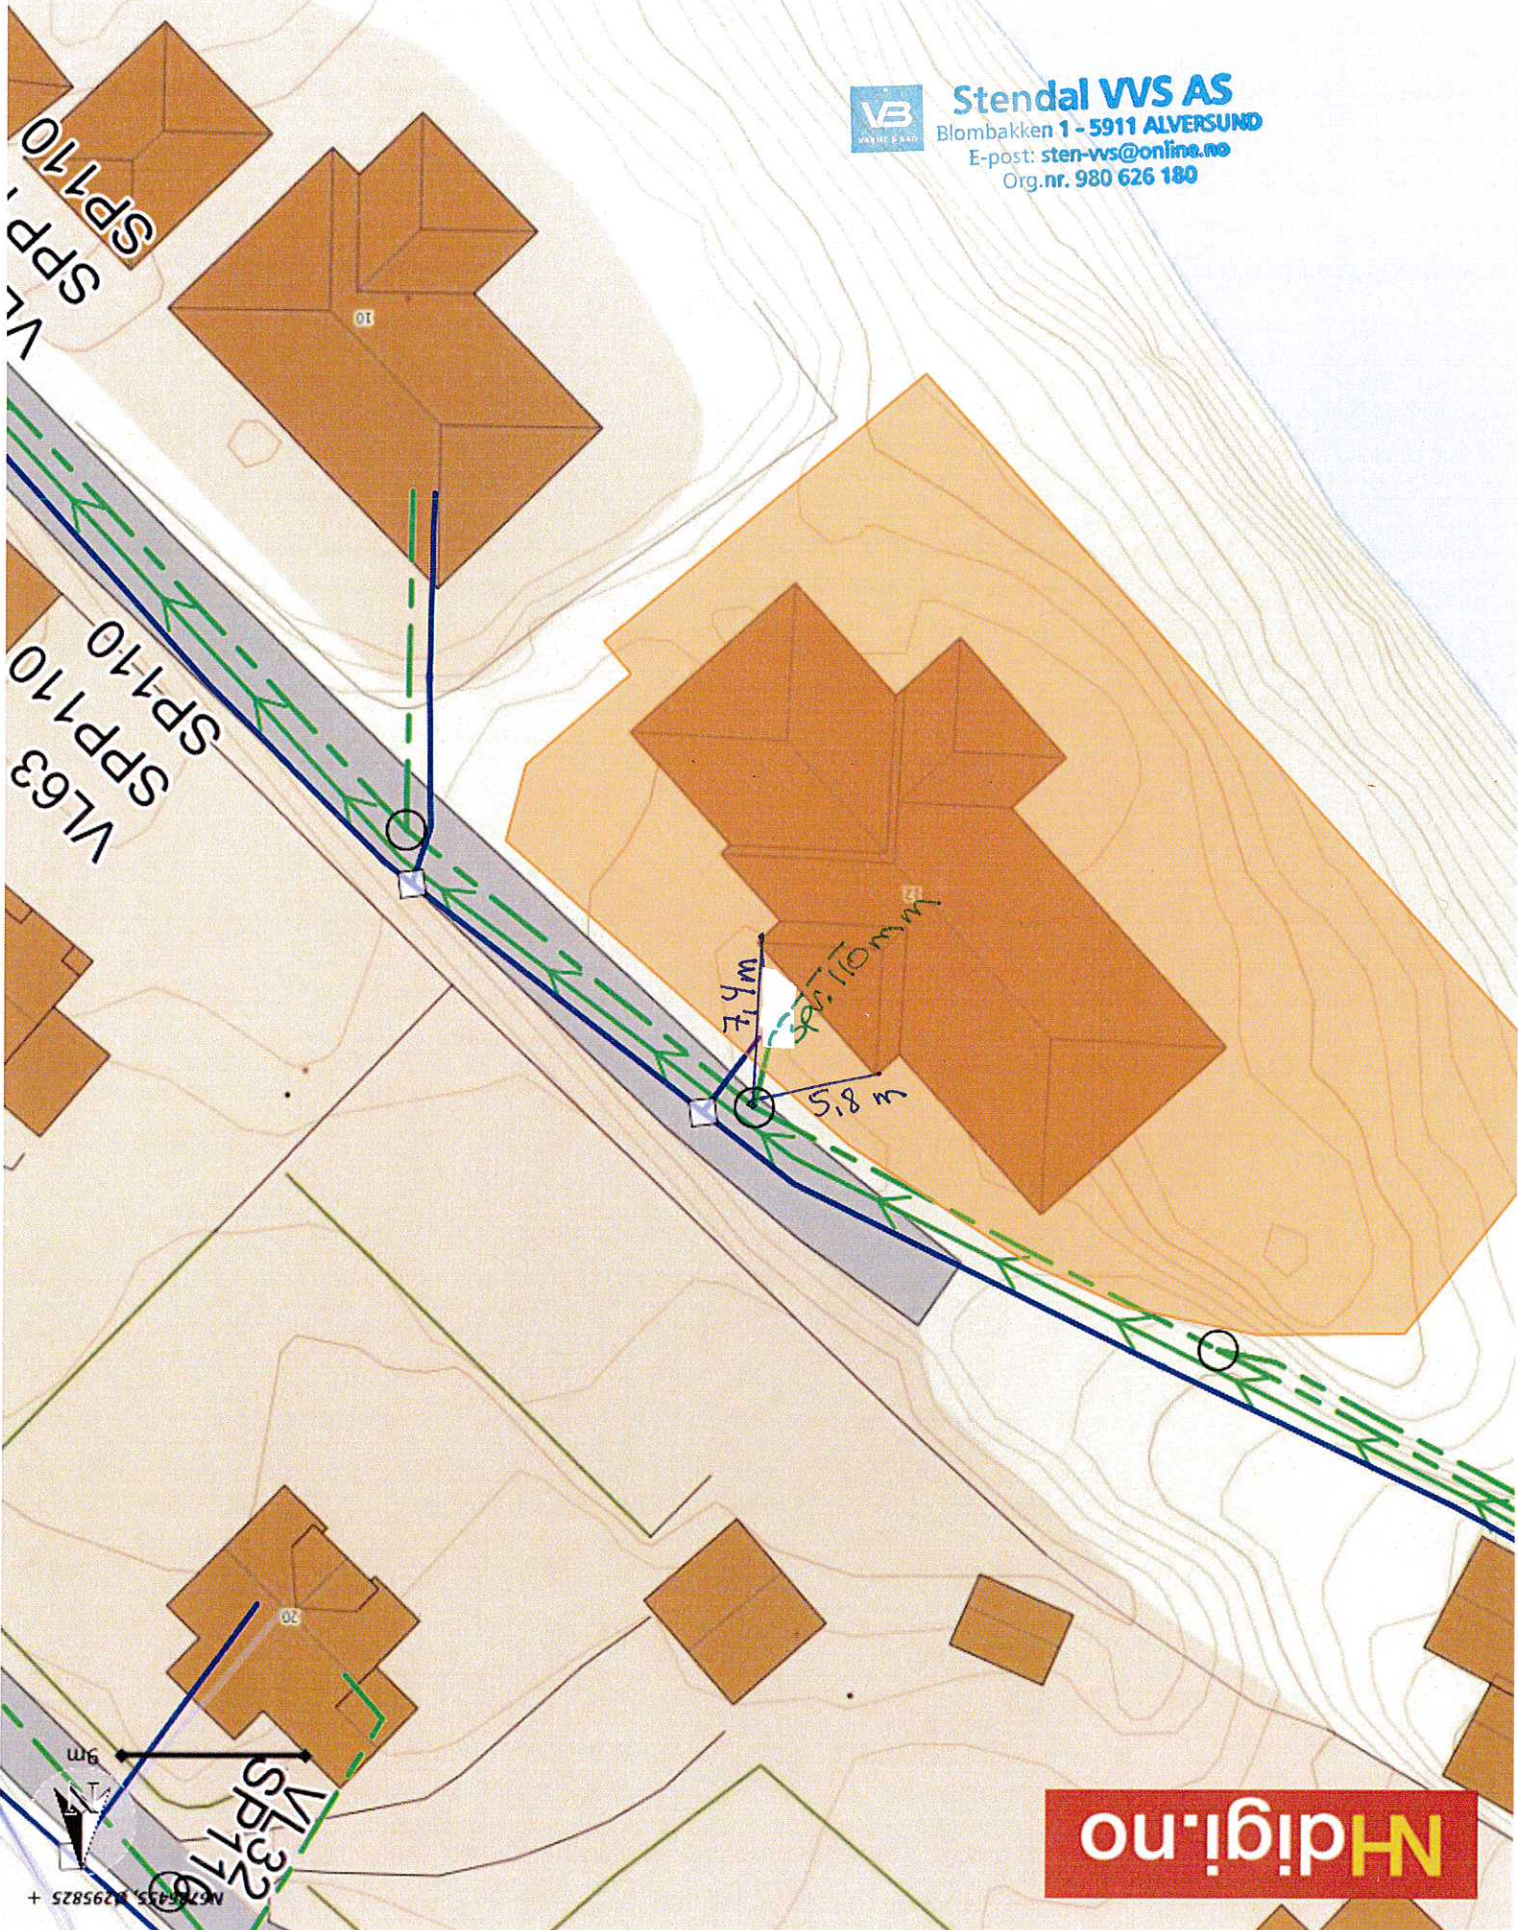



Stendal VVS AS
Blombakken 1 - 5911 ALVERSUND
E-post: sten-vvs@online.no
Org.nr. 980 626 180

