




Lindås, gnr 102 bnr 129, Vabø
Data på innmålt fasadeliv

06.08.2014

17

102/128

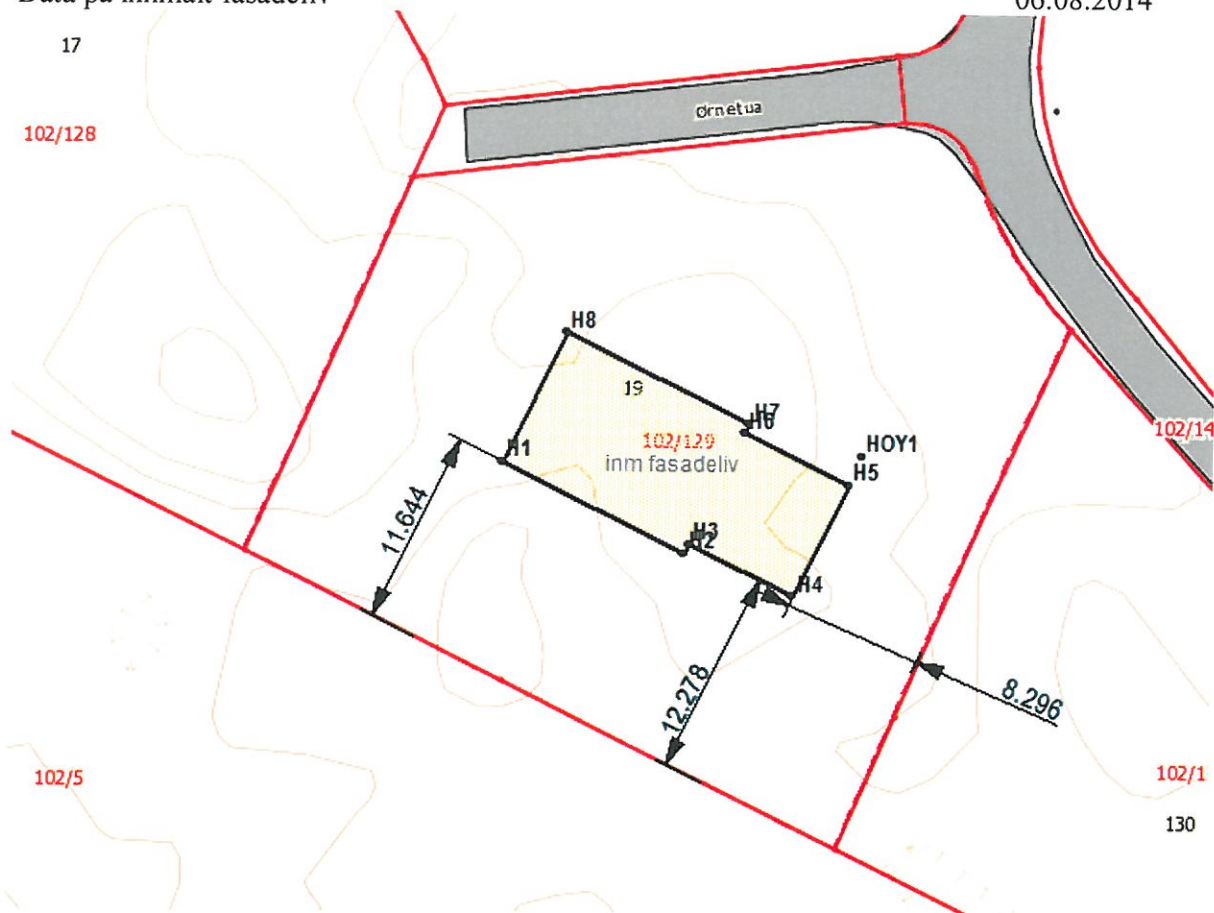

PunktID	N-koord.	Ø-koord.	Høyde
H1	6740190,09	294332,06	
H2	6740184,72	294342,96	
H3	6740185,26	294343,22	
H4	6740182,21	294349,41	
H5	6740188,80	294352,66	
H6	6740191,85	294346,47	
H7	6740192,39	294346,73	
H8	6740197,76	294335,84	
HOY1	6740190,51	294353,45	24,49

Høyde planert: kote +24,49

Vest Oppmåling AS

PB 84, 5293 Lonevåg
Tel 5639 4000 Mob 905 12 583