



FASADE ØST

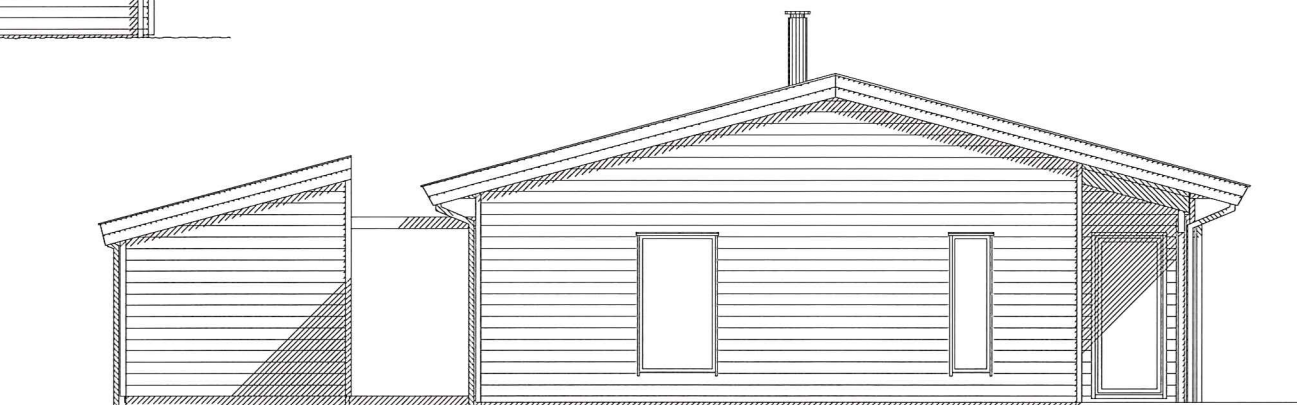


FASADE NORD

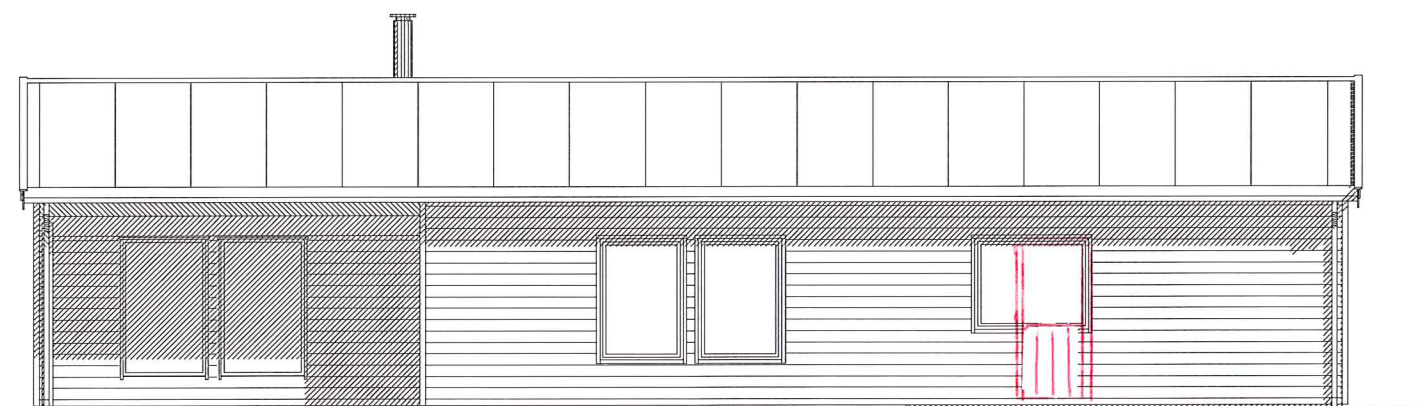

FASADE VEST

N
 Omsøkt vindu 15x12L
 Byttet til Dør 9x21H pluss
 Vindu 6x12L

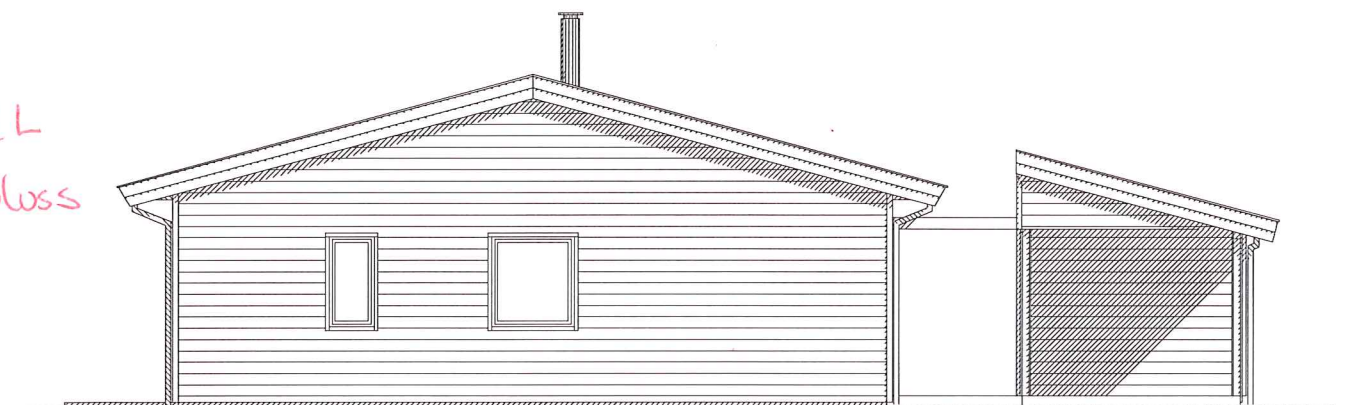

FASADE SØR

Rev.nr.:	Hustype LUX VAR	Tegning	FASADER	Rev.:	Tegn.:	Dato:	Kontr.:
				Tiltakshaver : Bent Arne Rognaldsen			
				Byggeplass : Fjeldsbø			
				Kommune : Lindås			
				Målestokk: 1:100	Dato : 17.10.2011	Arkivnr.: 15334	Nr.
				Arkitekt :			
				Denne tegning tilhører Nordbohus AS. Etterligning kfr. lov om åndsverk av 12.5.1961.			
				Kontr.: BBW			
				Dato: 24.02.2012			
				A05+			



Hustype

LUX VAR

Tegning

FASADER