


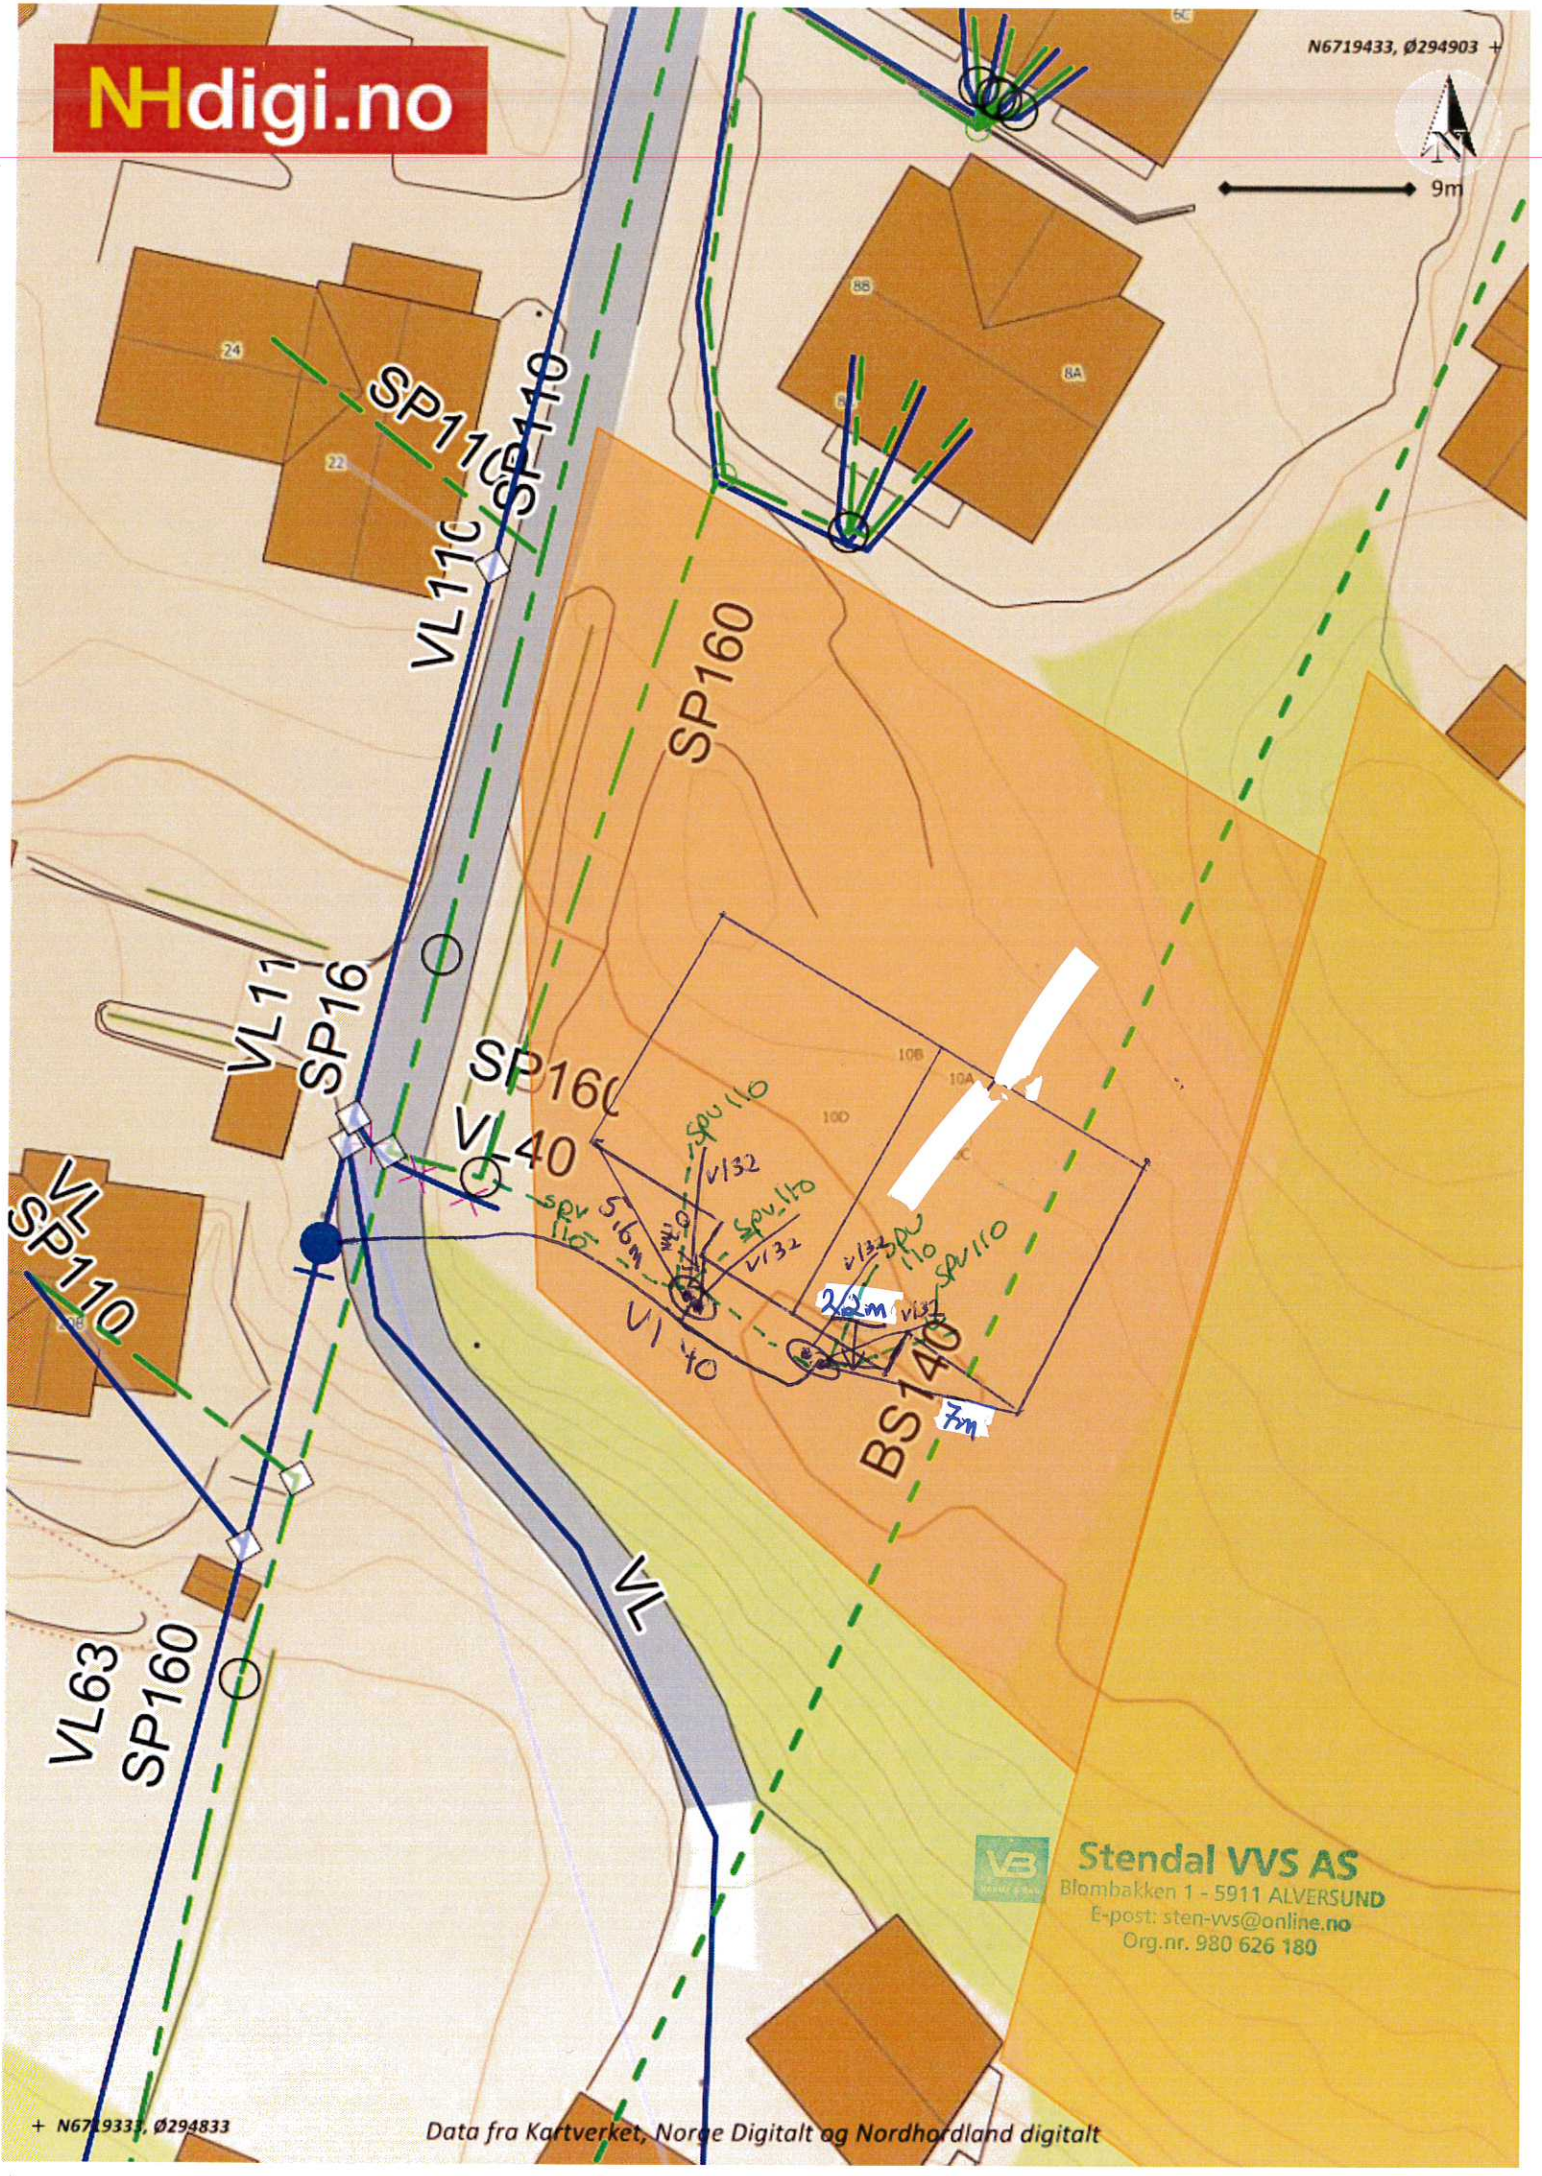

9m



Stendal VVS AS
Blombakken 1 - 5911 ALVERSUND
E-post: sten-vvs@online.no
Org.nr. 980 626 180