

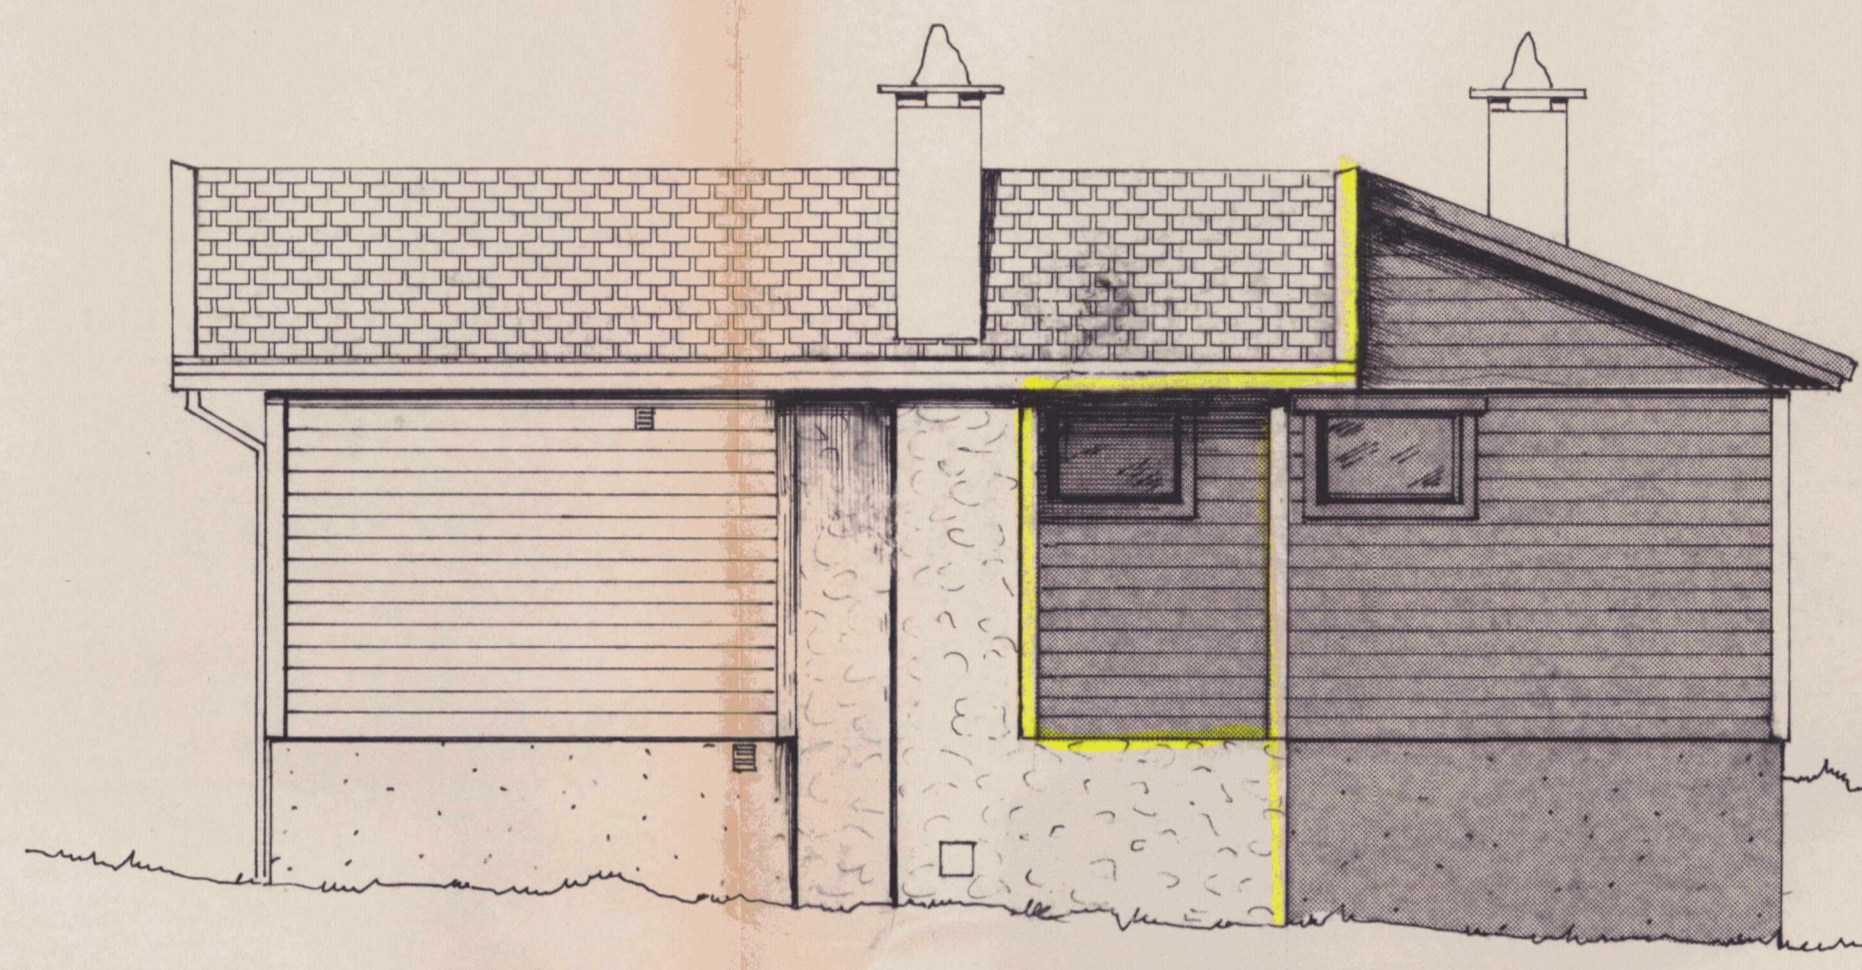


LINDÅS KOMMUNE
TEKNISK ETAT
17. APR. 1937/1890/F.O.
ARKIV NR. 215/06/001


N.B: HANEBJELKE 4-6-8 SYNLIG
TAKSPERR " " "

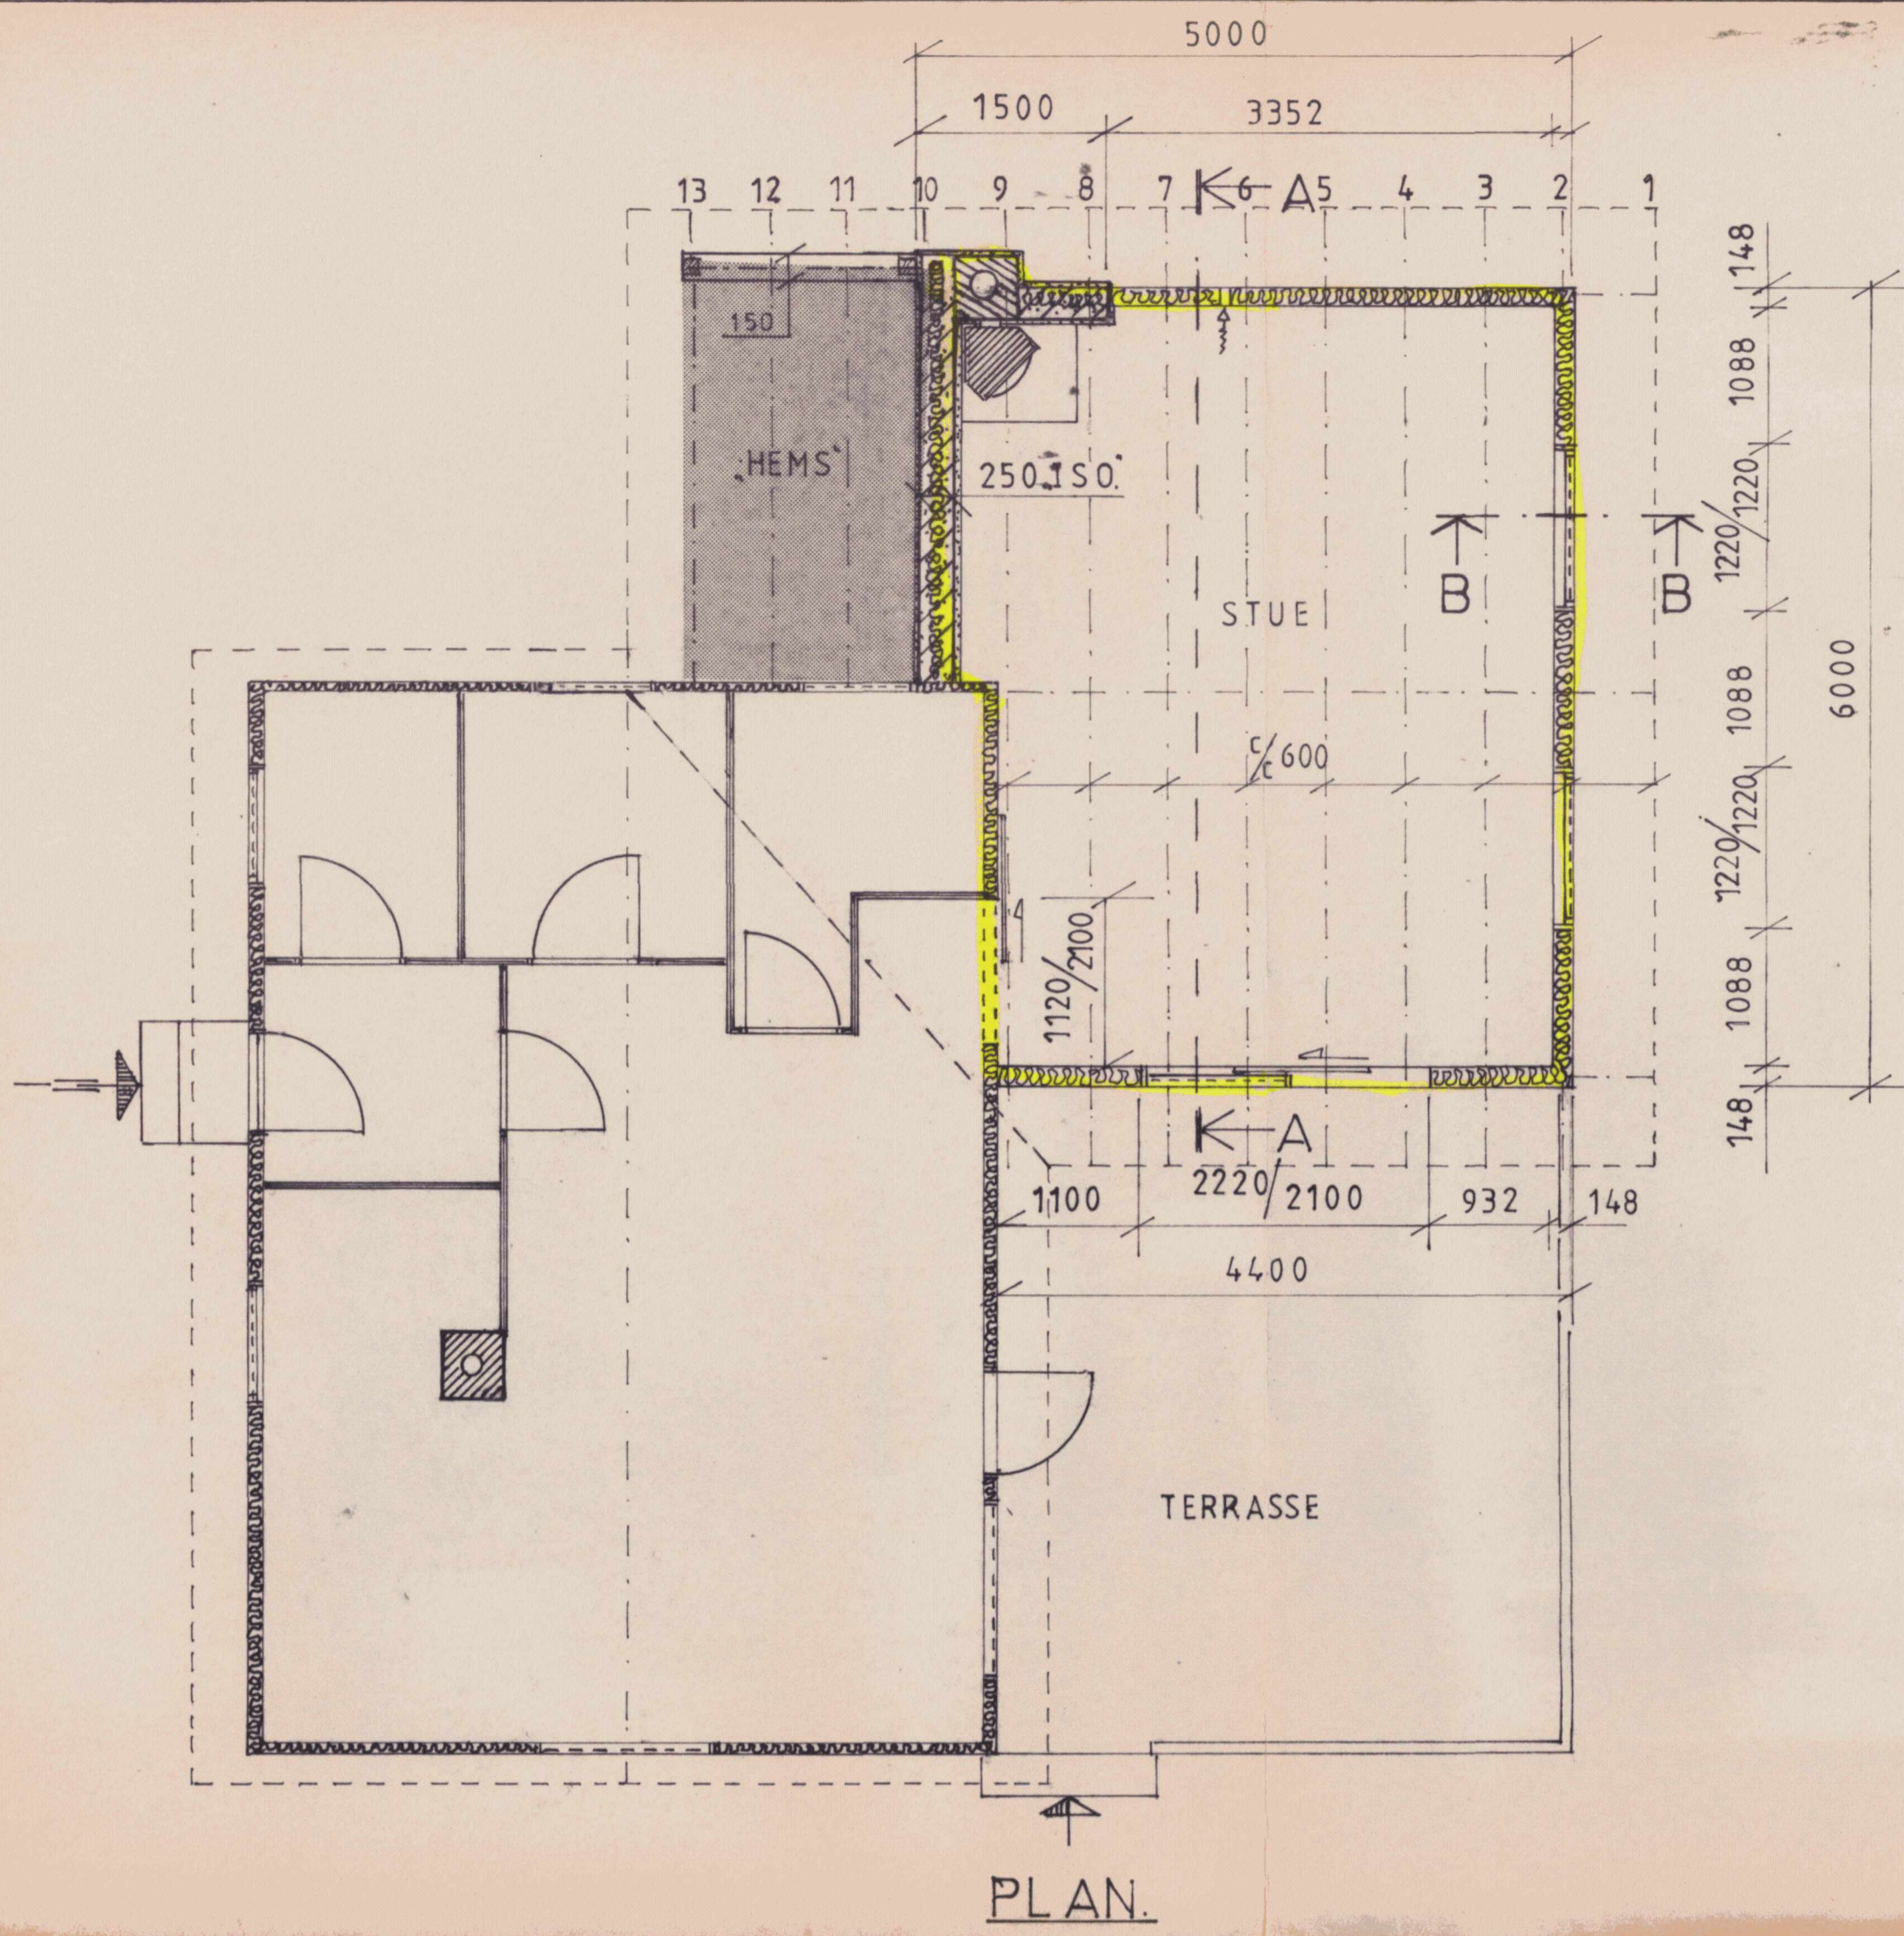


NORD

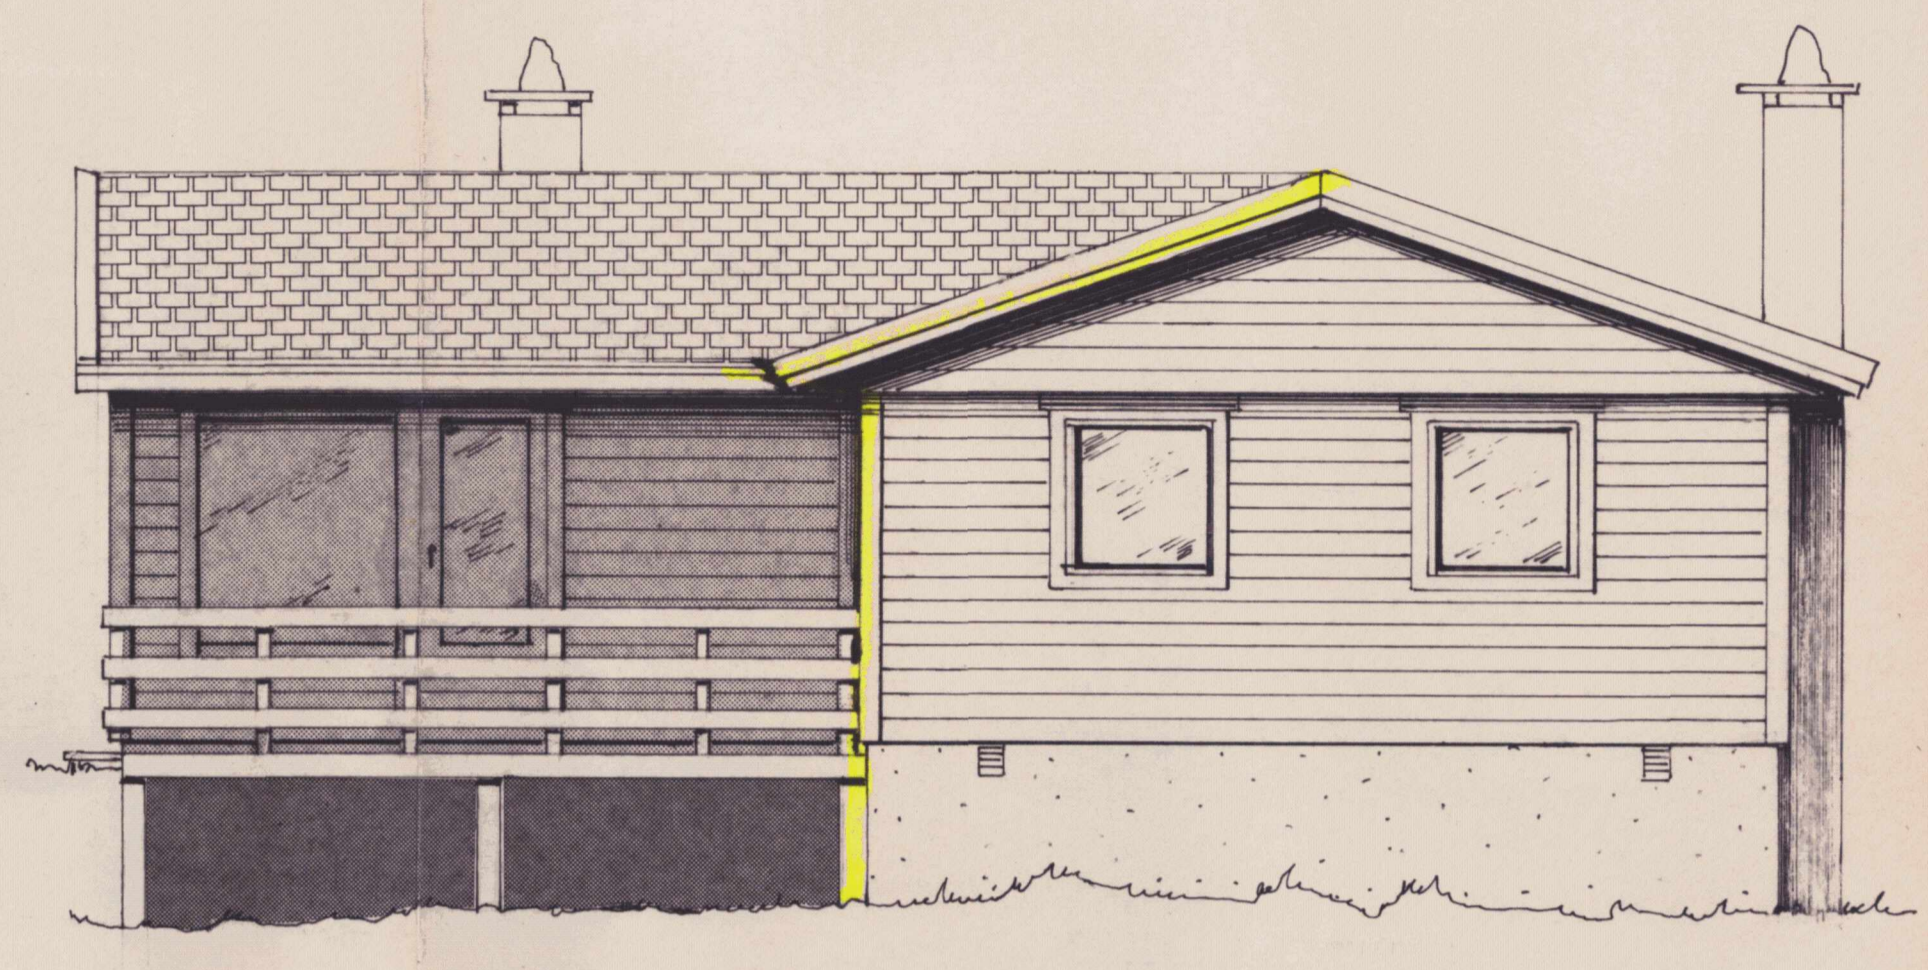


ÖST

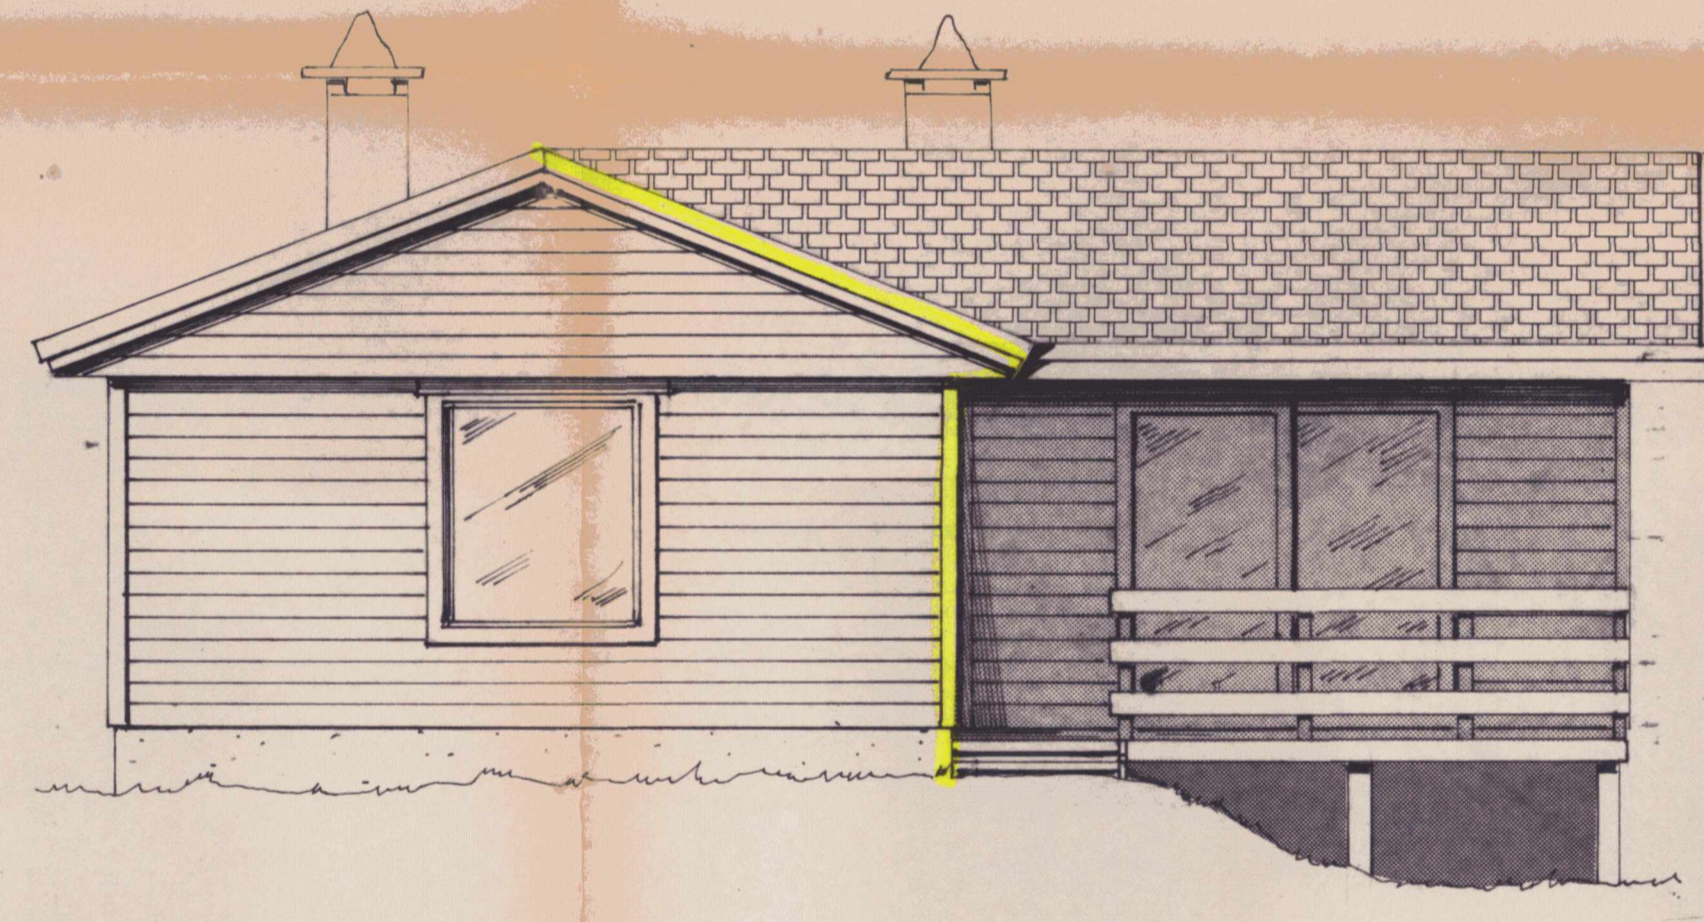


SYD

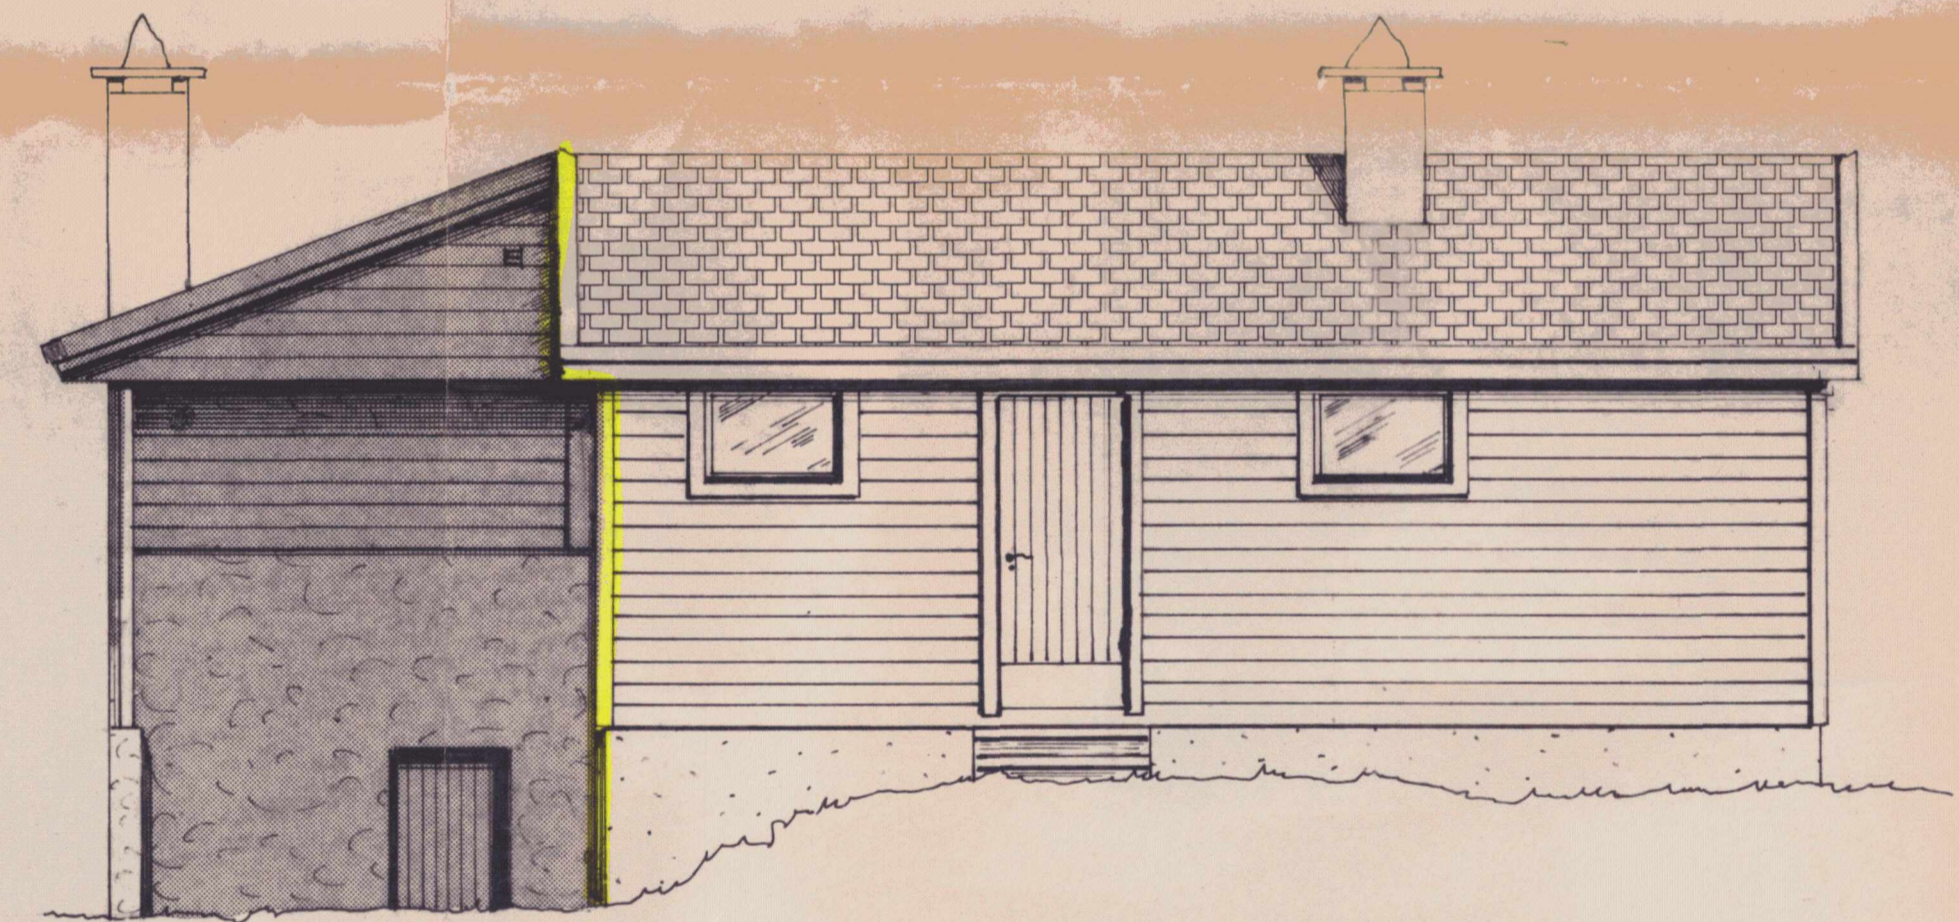


VEST

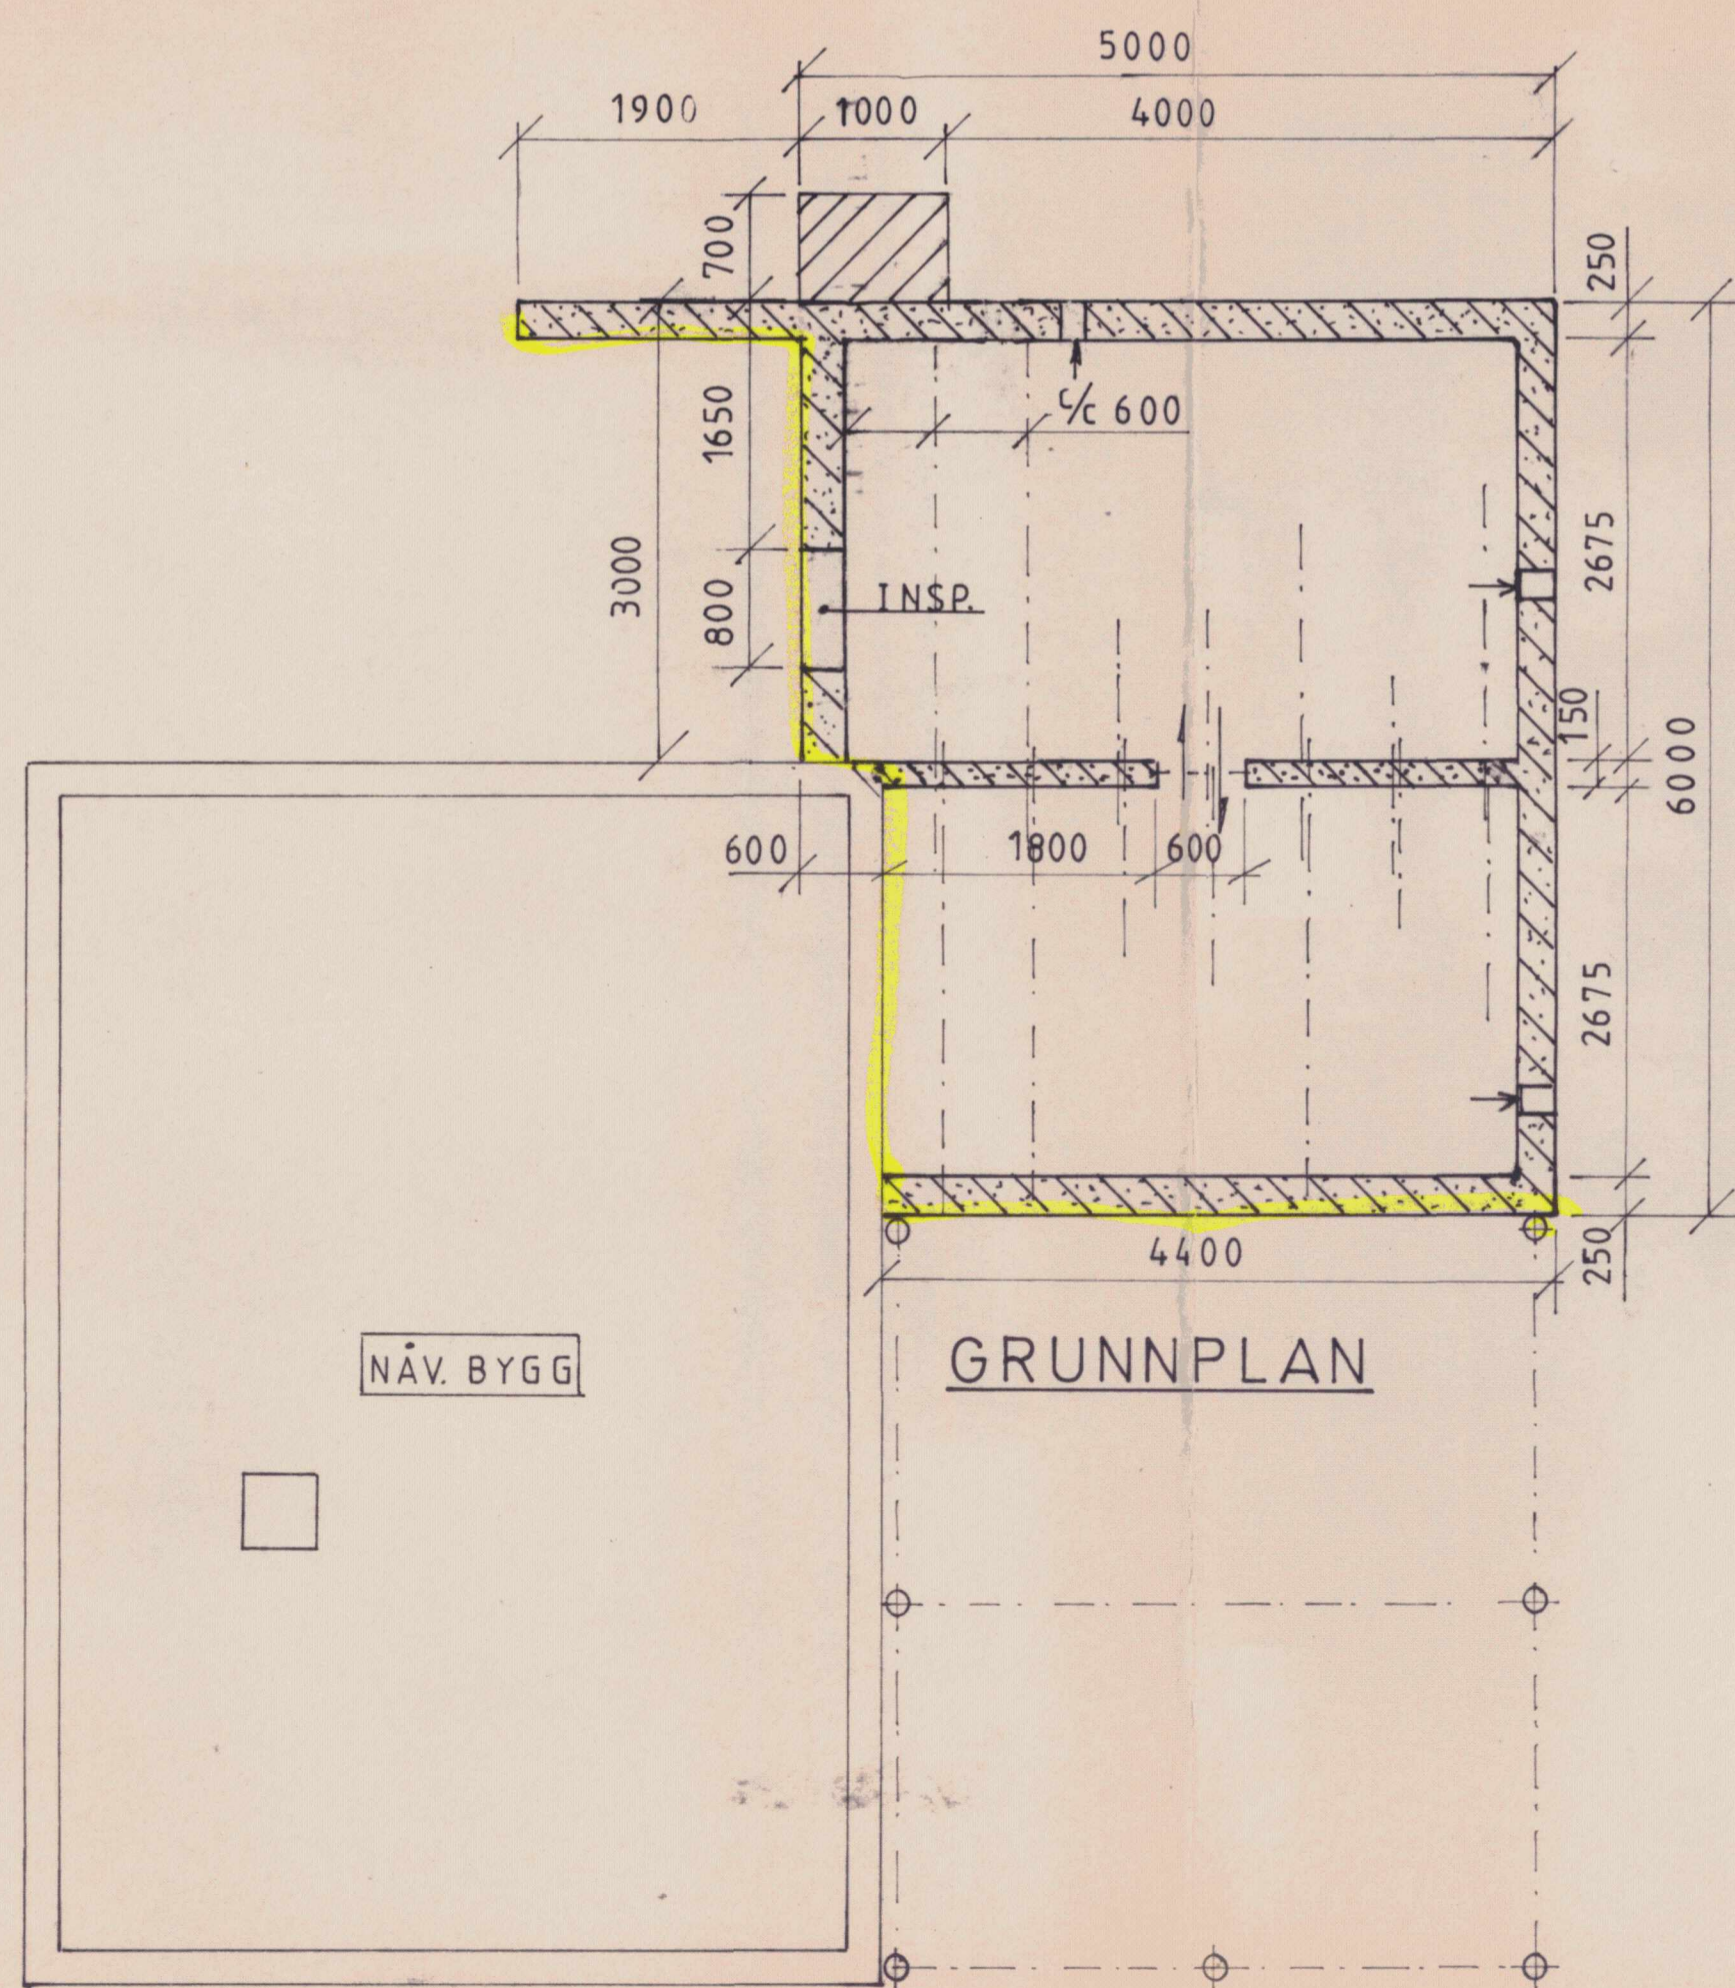

GRUNNPLAN

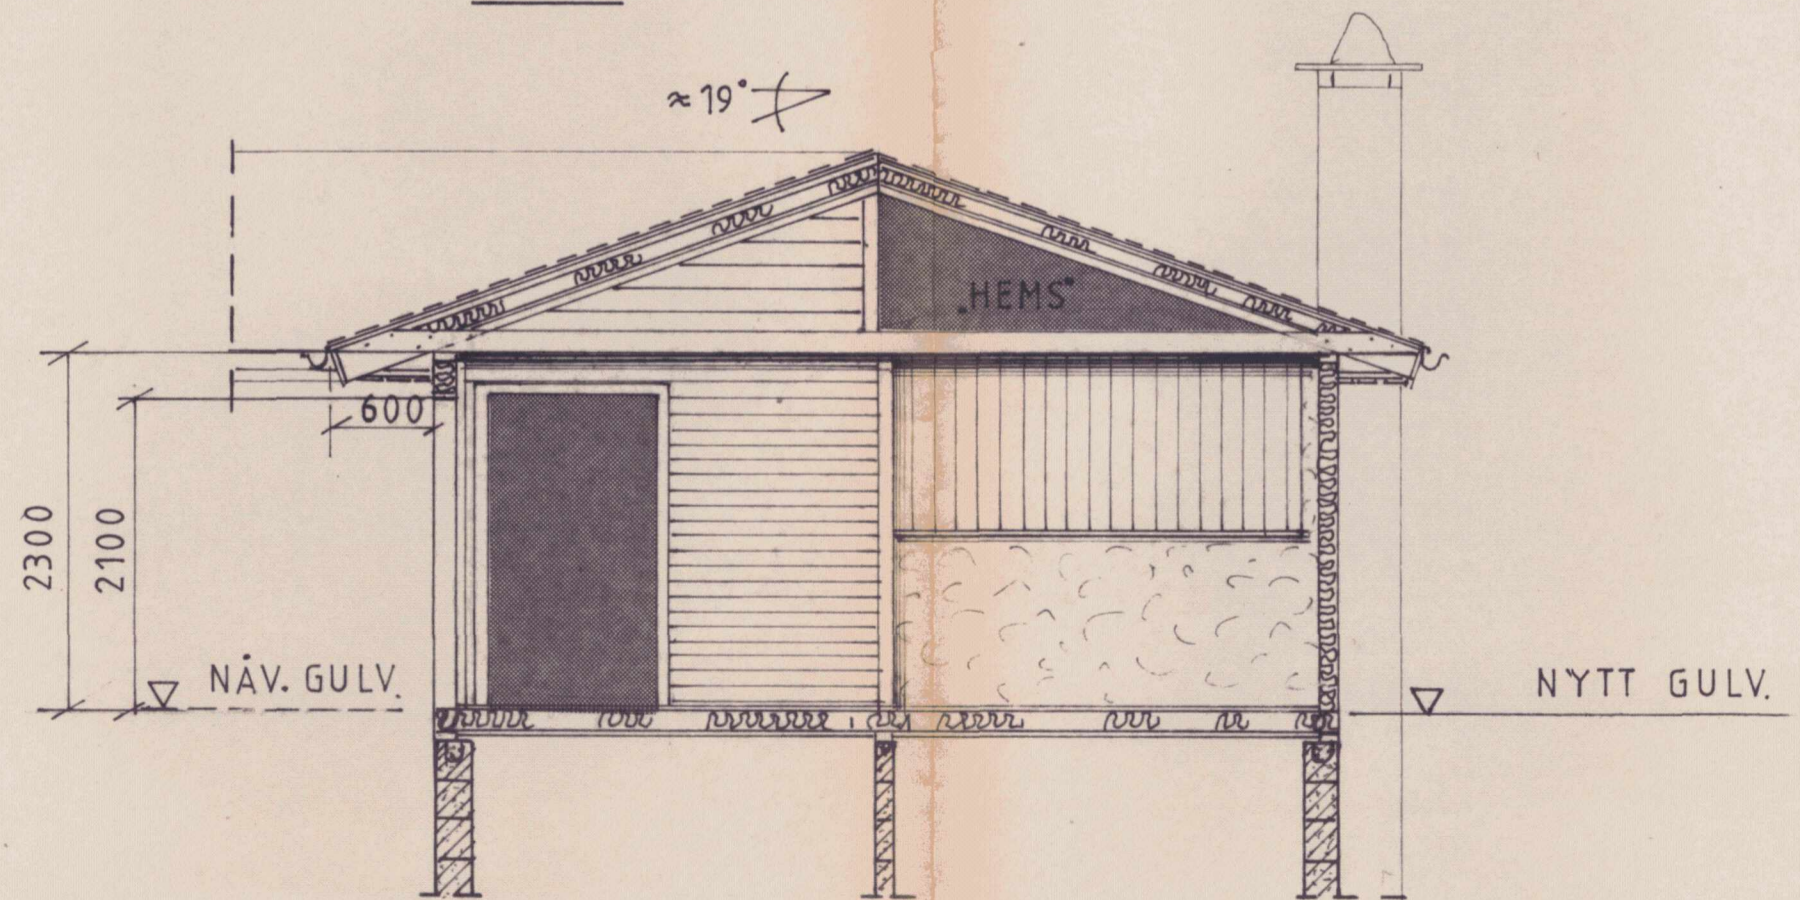

SNITT A-A

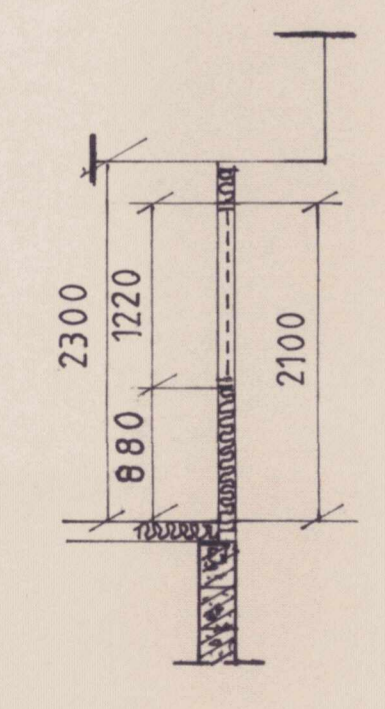

SNITT B-B

DATO:	MÅL: 1:50	G.NR: 215
		B.NR: 61
TILBYGG HYTTE		PLAN
B.R.A: 30,00 m ²		SNITT
FASADER		
ARK. INGVAR LARSEN 5112 ROSSLAND		