

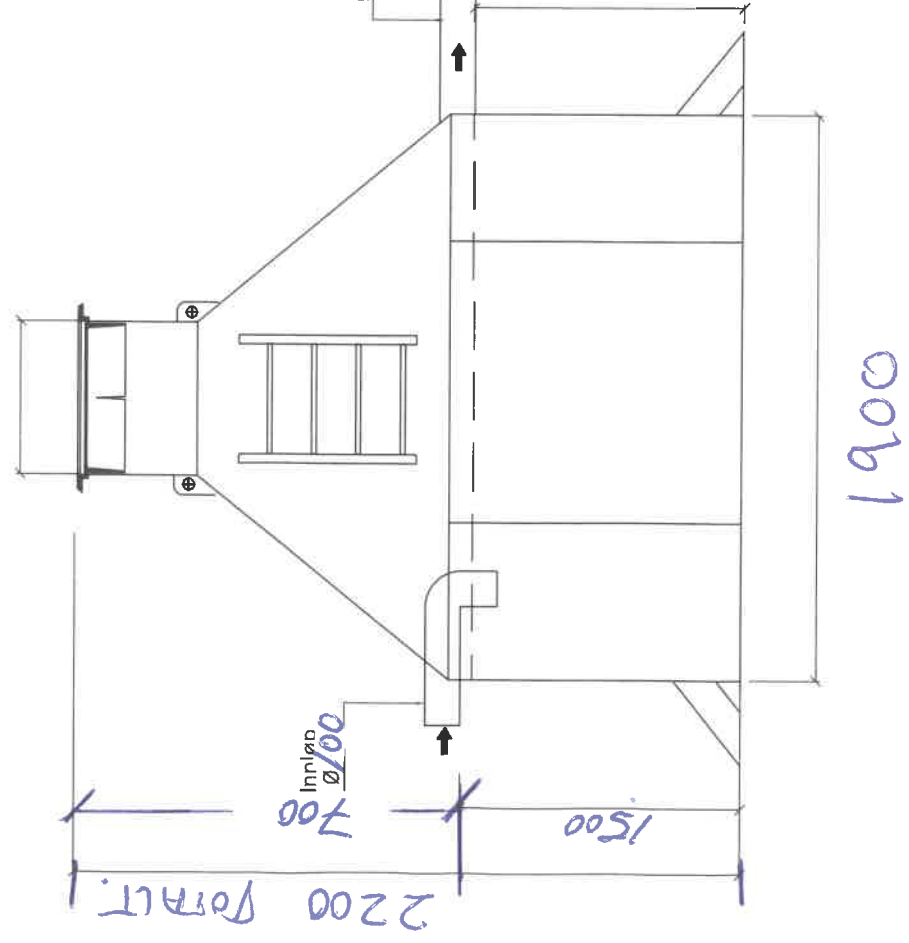
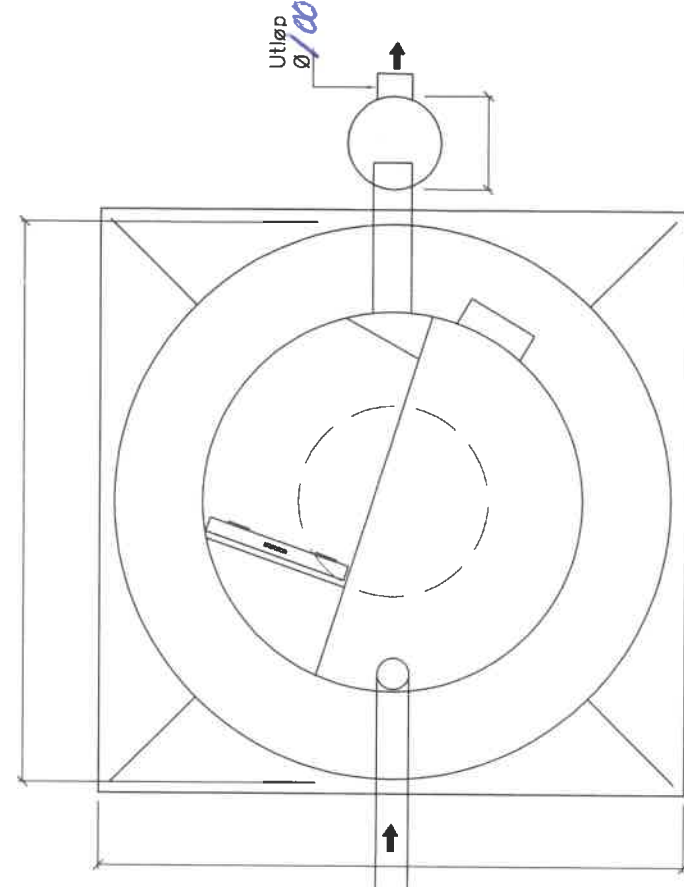


SANDFANG ZS-SR 4

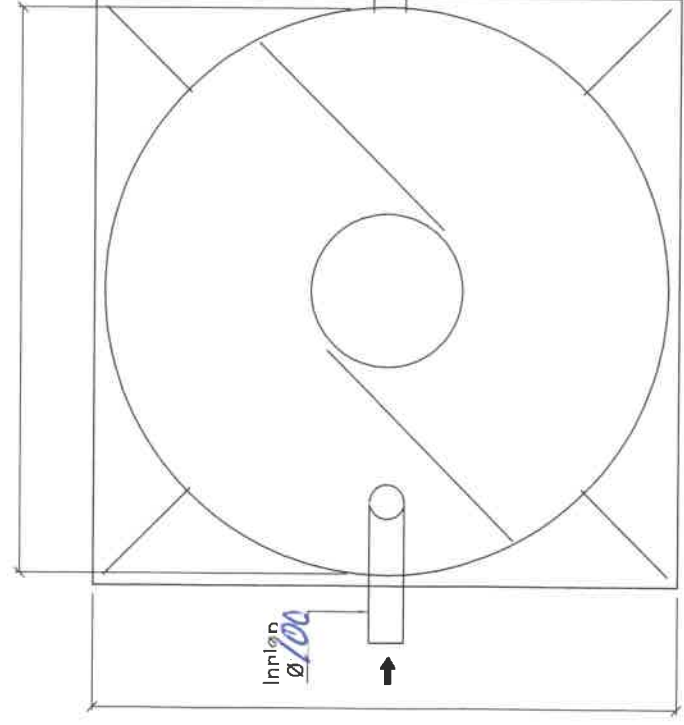

OLJEUTSKILLER UK-SR 4

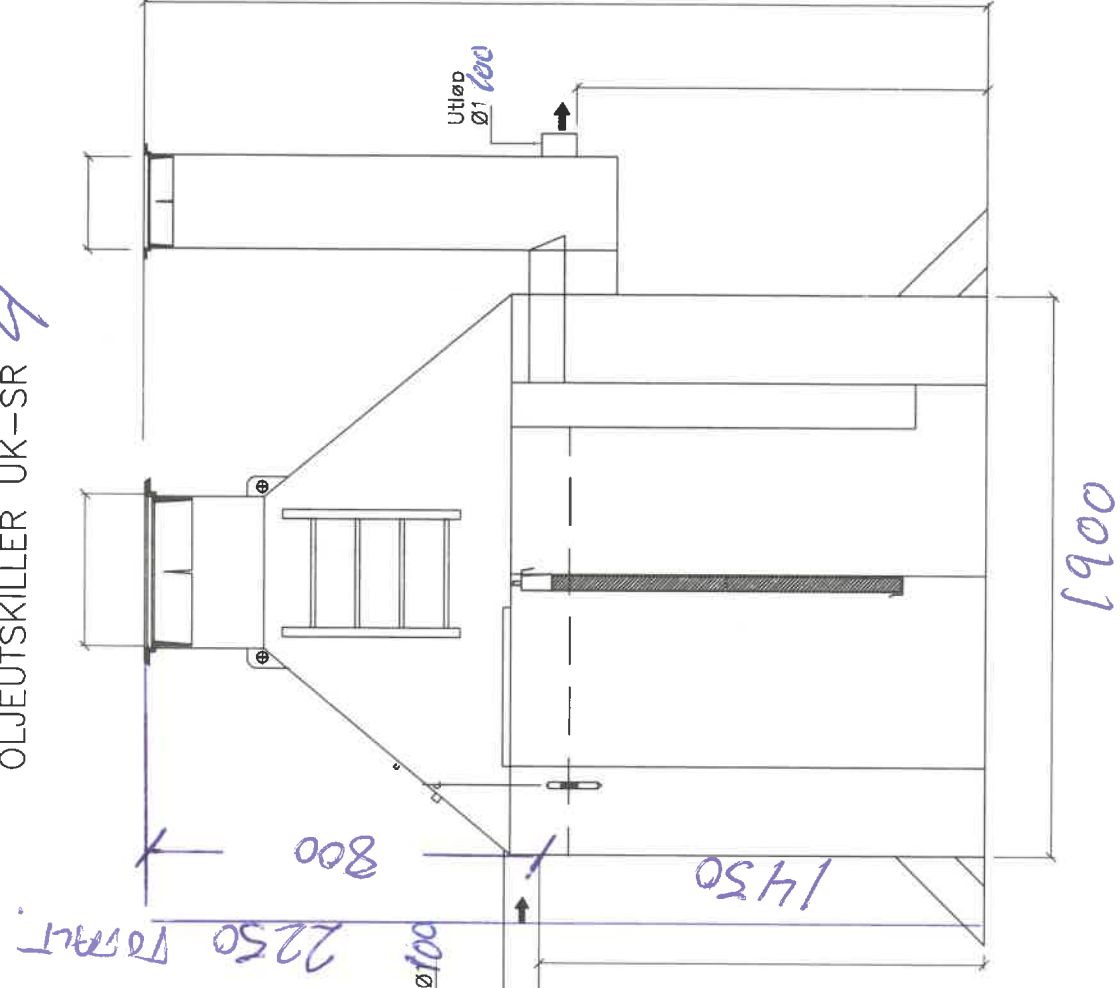

Dato:
23.03.2010

Konstr./tegnet:
R. Henriksen

Godkjent:

Målestokk

Sørkilen 8, 1621 Gressvik
Tlf. 69 36 17 70, Fax. 69 36 17 71
www.odin-maskin.no



Erstatning for:

Erstattet av:

Sandfang type ZS-SR og
oljeutskiller UK-SR

Tegn. nr.: 000-000-00

Henviing:

Beregning: