

stoppekranvann 123/146

Nhdigi.no

N6741701, Ø285803 +



9m

OV150
SP160
VL160

VL
SP160
VL160

SP160
VL110

VL

OV1
SP160
VL16

37B
37A

OV150
SP160
VL160

VL

35



Stendal VVS AS
Blombakken 1 - 5911 ALVERSUND
E-post: sten-vvs@online.no
Org.nr. 980 626 180

+ N6741601, Ø285733

Data fra Kartverket, Norge Digitalt og Nordhordland digitalt

avl opp 123/146

Ndigi.no

N6741701 Ø285803 +



9m

OV151
SP160
VL160

VL
SP160

SP160
VL110



VL

VL

OV1
SP16
VL16

VL


OV150
SP160
VL160

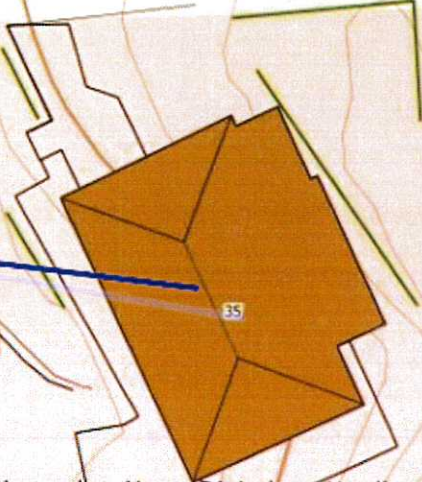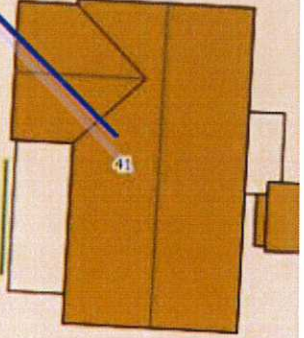

Stendal VVS AS
 Blombakken 1 - 5911 ALVERSUND
 E-post: sten-vvs@online.no
 Org.nr. 980 626 180

+ N6741601, Ø285733

Data fra Kartverket, Norge Digitalt og Nordhordland digitalt

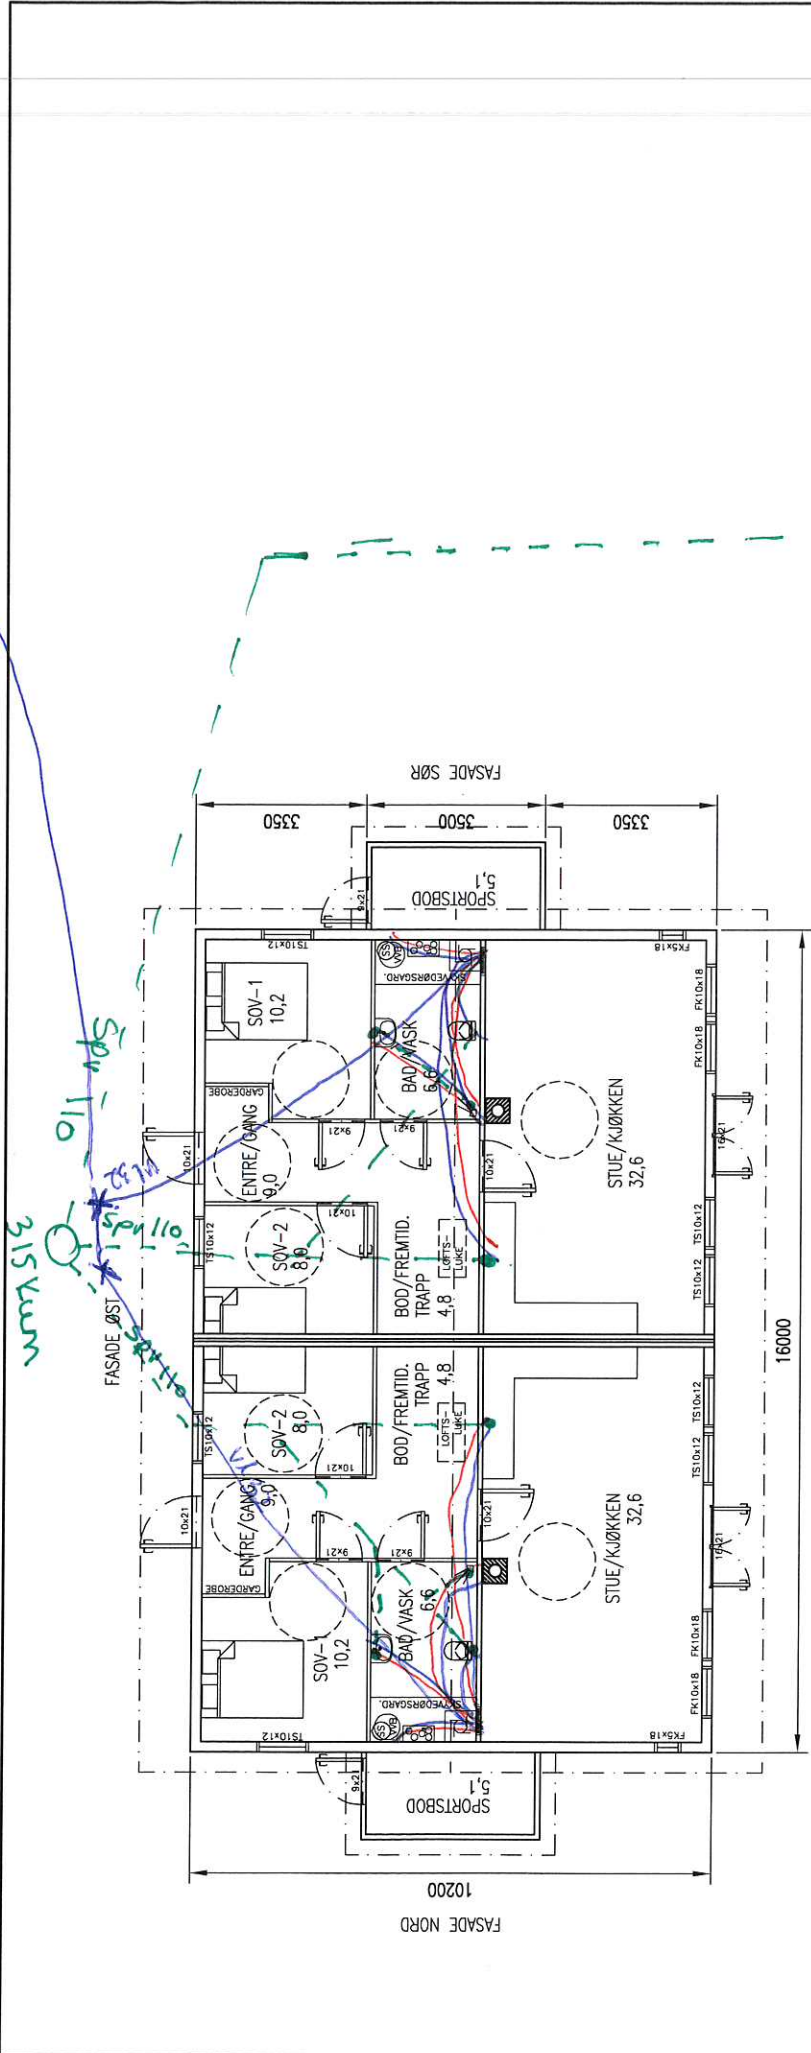

HOVEDPLAN

BYA:	175,1 m2
BRA PR LEILIGHET:	80,1 m2
BRA PR LEILIGHETSLOFT:	49,0 m2
TOTALT BRA INK. FREMTIDIG INNREDET LOFT :	258,2 m2

25/9-18

VB
Stendal WS AS
 Blombakken 1 - 5911 ALVERSUND
 E-post: sten-ws@online.no
 Org.nr. 980 626 180

DATE/SIGN	NOTE: * PART OF DRAWING MAY NOT BE SHOWN IN SCALE * DO NOT TAKE MEASURES ON DRAWING * ONLY RELAY ON GIVE DIMENSIONS	REVISION/DATE:	ACCORDING TO INTERNATIONAL LAWS, THIS DRAWING IS THE PROPERTY OF ARKOCONSULT AS. THE DRAWING CAN NOT BE USED, MADE PUBLIC OR HANDED OVER TO A THIRD PART WITHOUT OUR WRITTEN CONSENT. ANY INFRINGEMENT WILL LEAD TO LEGAL PROCEEDINGS.
DESCRIPTION	BOLIG & EIENDOM AS RISASJØEN, 123/145 2 MANNNS BOLIG PLAN	PROJECT NO.: 2014104	SCALE: 1:100 DRAWN: LAH CHECKED:
		DRAWING NO.: 20714104A01	FORMAT: A3 DATE: 15.04.2014 DATE:

Arkoconsult
 ARKOCONSULT AS, Postboks 103, 5291 Vølestr. f.
 Tel.: 56390003 - Fax: 56191130 - Mob.: 93241511
 Mail: post@arkoconsult.no - Org.nr.: 997089782 MVA