




Lindås, gnr 212 bnr 133,
Data på innmålt fasadeliv

26.03.2018

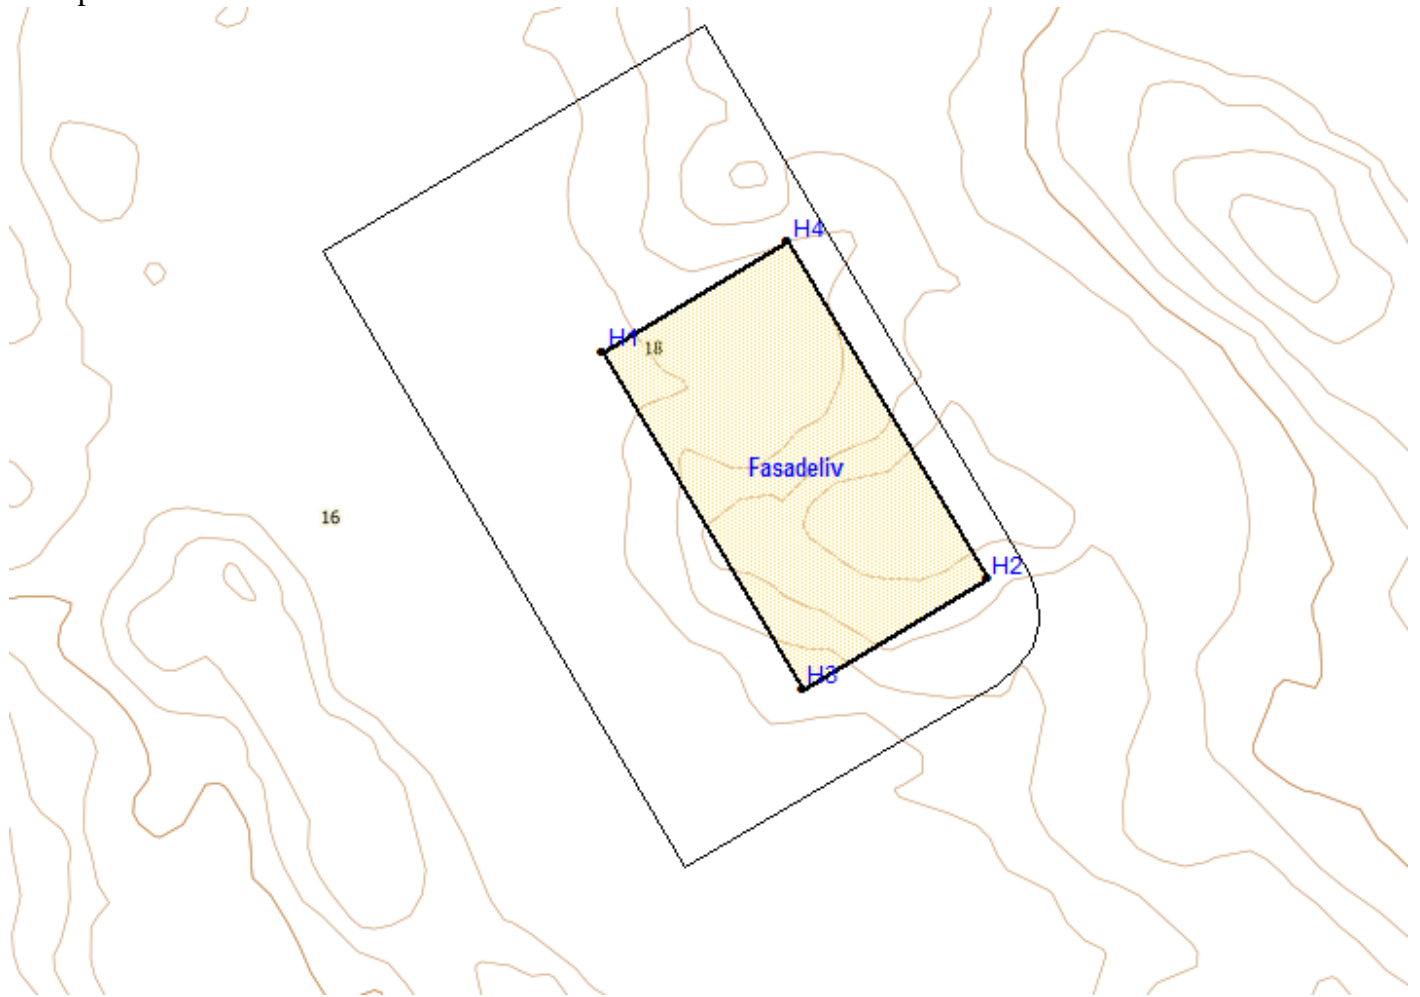

PunktID	N-koord.	Ø-koord.	Høyde
H1	6725141,63	303009,03	18,15
H2	6725117,84	303049,44	
H3	6725106,29	303029,99	
H4	6725153,17	303028,47	