


HOR. KURV.	
BREDDEUTV.	
VEIBANE H.	-0.24 52.75 -7.87 53.27 -8.99 53.79 -10.26 54.32 -11.01 54.84 -11.40 55.36 -11.27 55.89 -10.62 56.41 -11.10 56.93 -10.92 57.46 -10.74 57.98 -10.50 58.50 -8.80 59.03 -5.93 59.55 -3.60 60.07 -2.20 60.60 -0.51 60.92
SKJ./FYLL.	

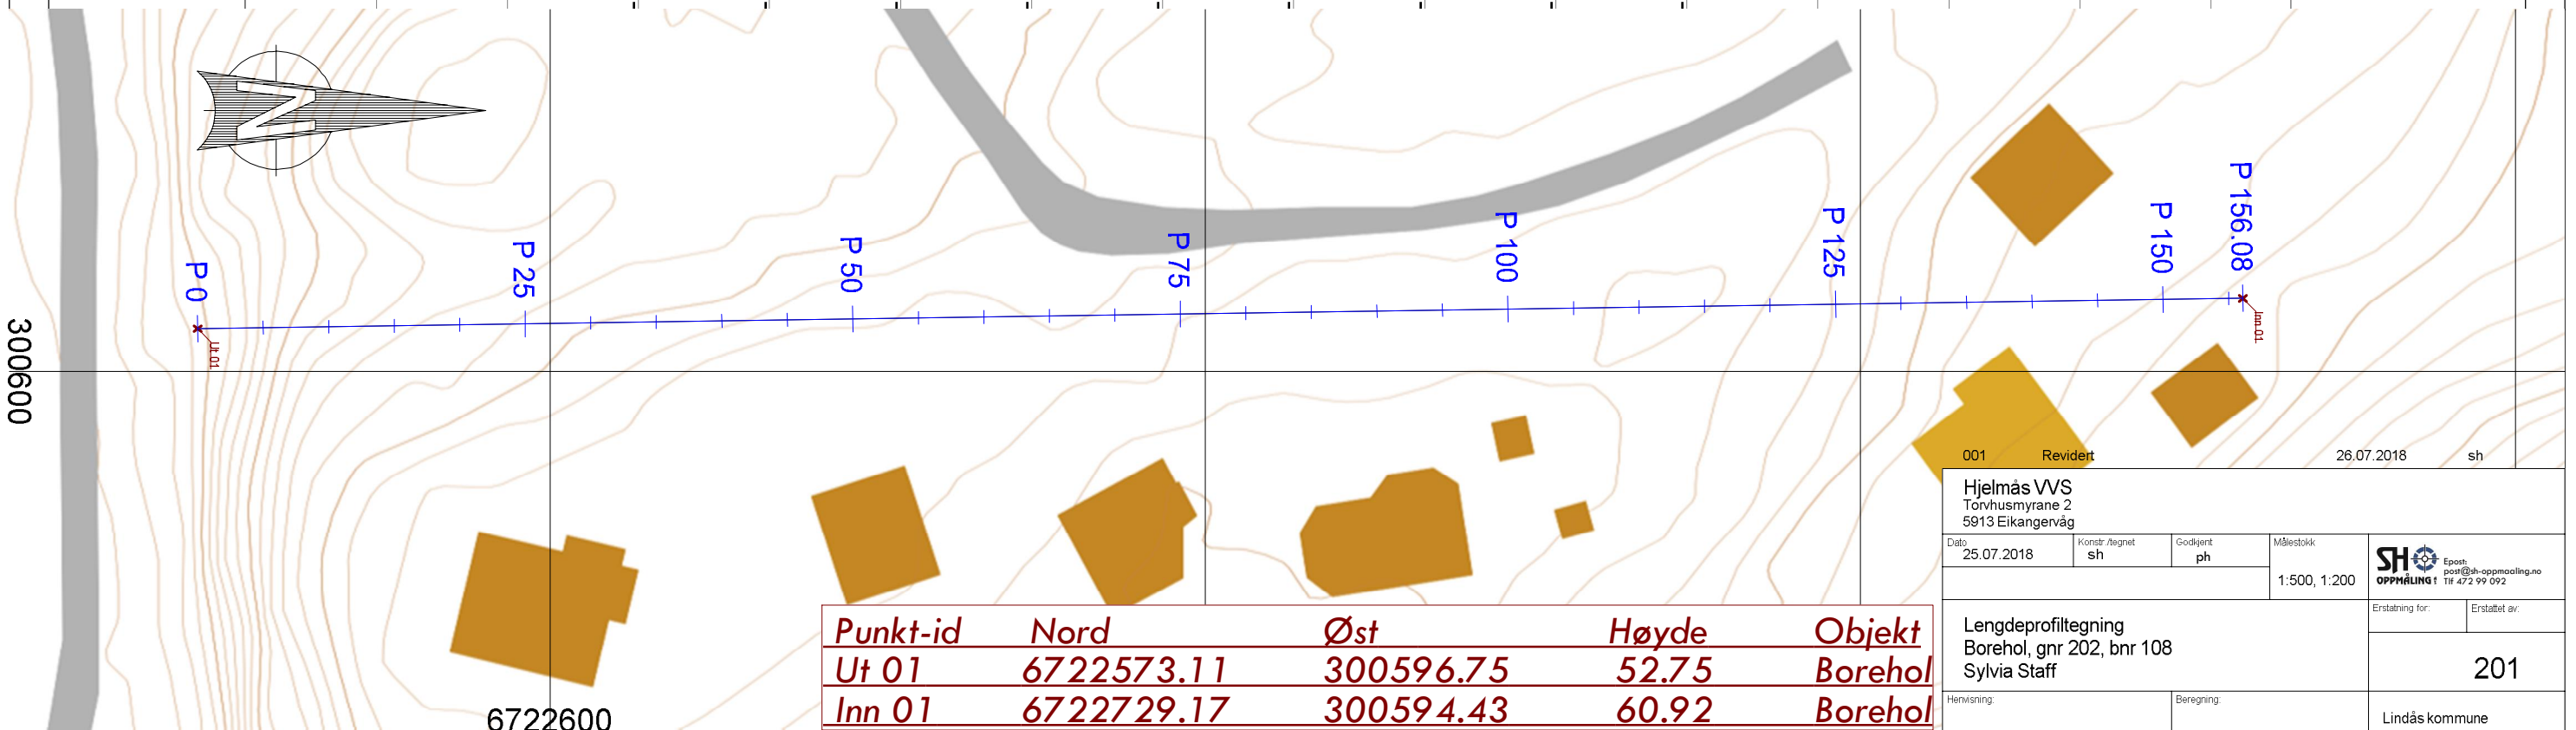

Punkt-id	Nord	Øst	Høyde	Objekt
Ut 01	6722573.11	300596.75	52.75	Borehol
Inn 01	6722729.17	300594.43	60.92	Borehol

Hjelmås VVS Torvhusmyrane 2 5913 Eikangervåg				26.07.2018 sh	
Dato	Konstr./Ægnet	Godkjent	Målestokk	SH OPPMÅLING 1	
25.07.2018	sh	ph	1:500, 1:200	Epost: post@sh-oppmaling.no Tlf: 472 99 092	
Lengdeprofiltegning Borehol, gnr 202, bnr 108 Sylvia Staff				Erstatning for:	Erstatet av:
				201	
Henvisning:			Beregning:	Lindås kommune	