




Lindås, gnr 239 bnr 125, Eknes  
Data på innmålt fasadeliv

05.10.2017

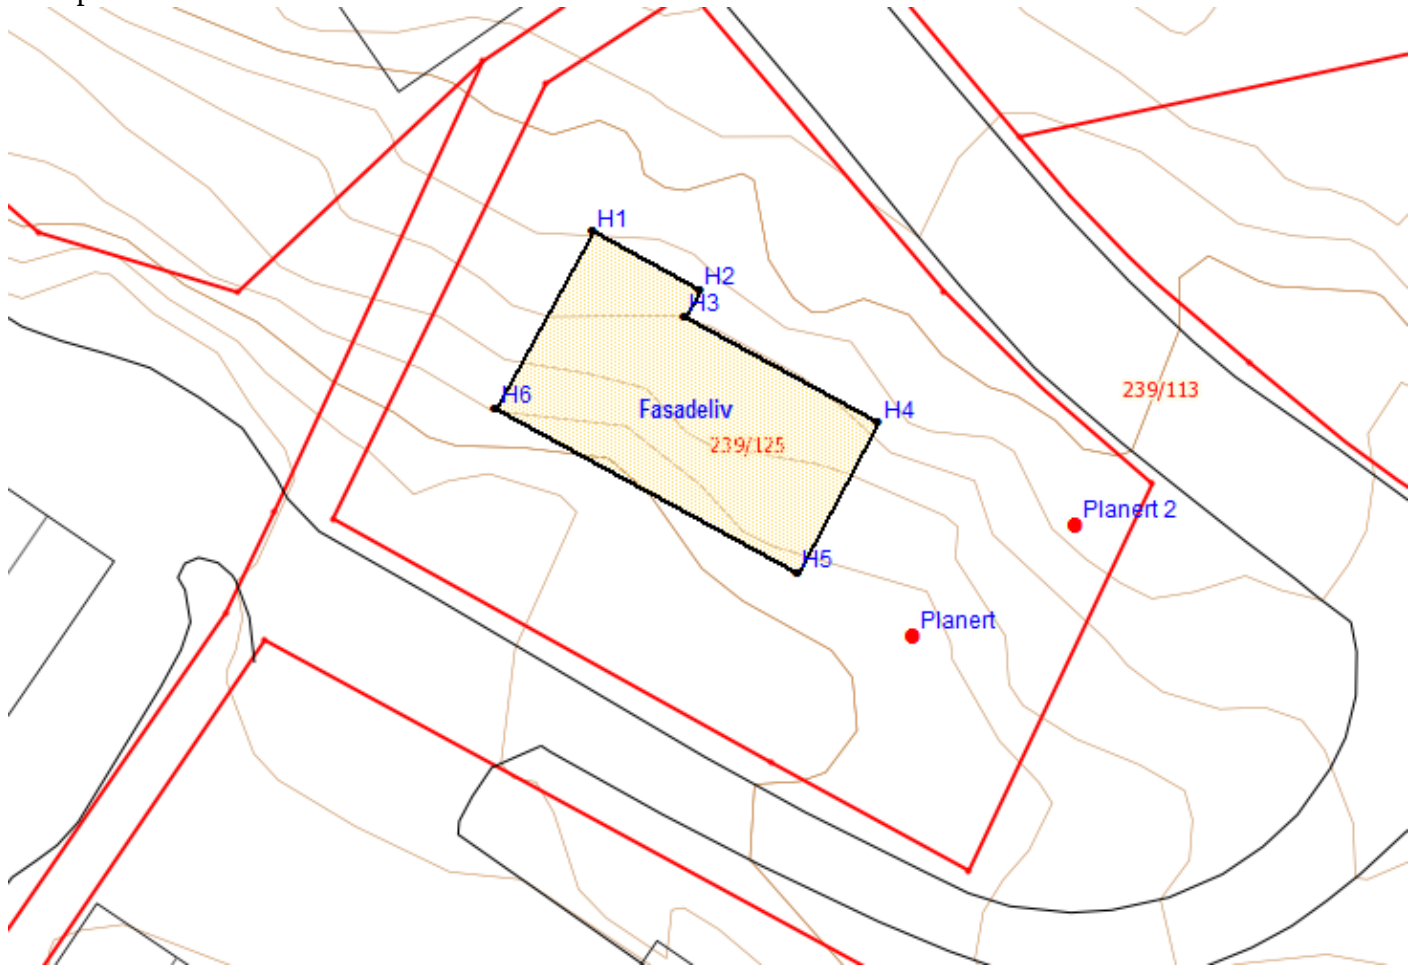

PunktID	N-koord.	Ø-koord.	Høyde
H1	6723772,53	305439,61	
H2	6723770,25	305443,78	
H3	6723769,20	305443,20	
H4	6723765,06	305450,77	
H5	6723759,21	305447,57	
H6	6723765,63	305435,83	
Planert	6723756,72	305452,11	15,04
Planert 2	6723761,05	305458,41	17,59