



FASADE VEST



FASADE SØR

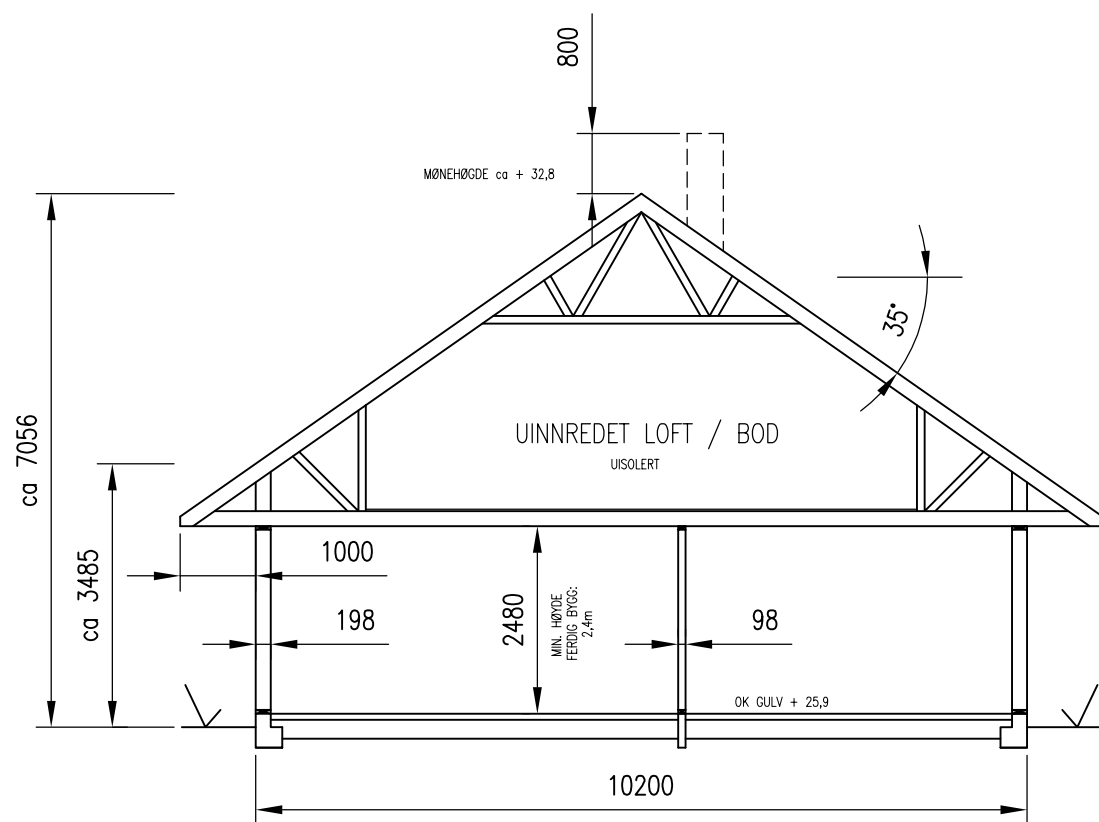

TYPISK SNITT

A	ENDRET HØGDEPLASSERING IHT. INNMÅLING	30.11.18/PKT	DATE/SIGN	NOTE! * PART OF DRAWING MAY NOT BE SHOWN IN SCALE * DO NOT TAKE MEASURES ON DRAWING * ONLY RELAY ON GIVE DIMENSIONS	ACCORDING TO INTERNATIONAL LAWS, THIS DRAWING IS THE PROPERTY OF ARKOCONSULT AS. THE DRAWING CAN NOT BE USED, MADE PUBLIC OR HANDED OVER TO A THIRD PART WITHOUT OUR WRITTEN CONSENT. ANY INFRINGEMENT WILL LEAD TO LEGAL PROCEEDINGS.
		REV. DESCRIPTION	BOLIG & EIENDOM AS RISASJØEN, 123/146	REVISION/DATE: A/30.11.18	PROJECT NO.: 2014103
			2 MANNES BOLIG FASADER OG SNITT	DRAWING NO.: 20714103A03	
				SCALE: 1:100	FORMAT: A3
			ARKOCONSULT AS, Postboks 103, 5291 Valest.f. Tel.: 56390003 - Fax.: 56191130 - Mob.: 93241511 Mail: post@arkoconsult.no - Org.nr.: 997089782 MVA	DRAWN: LAH	DATE: 15.04.2014
				CHECKED: PKT	DATE: 12.02.16