


Lindås VVS N.T AS
13.12-18

108/609 Lindås Kommune



9m

108/6

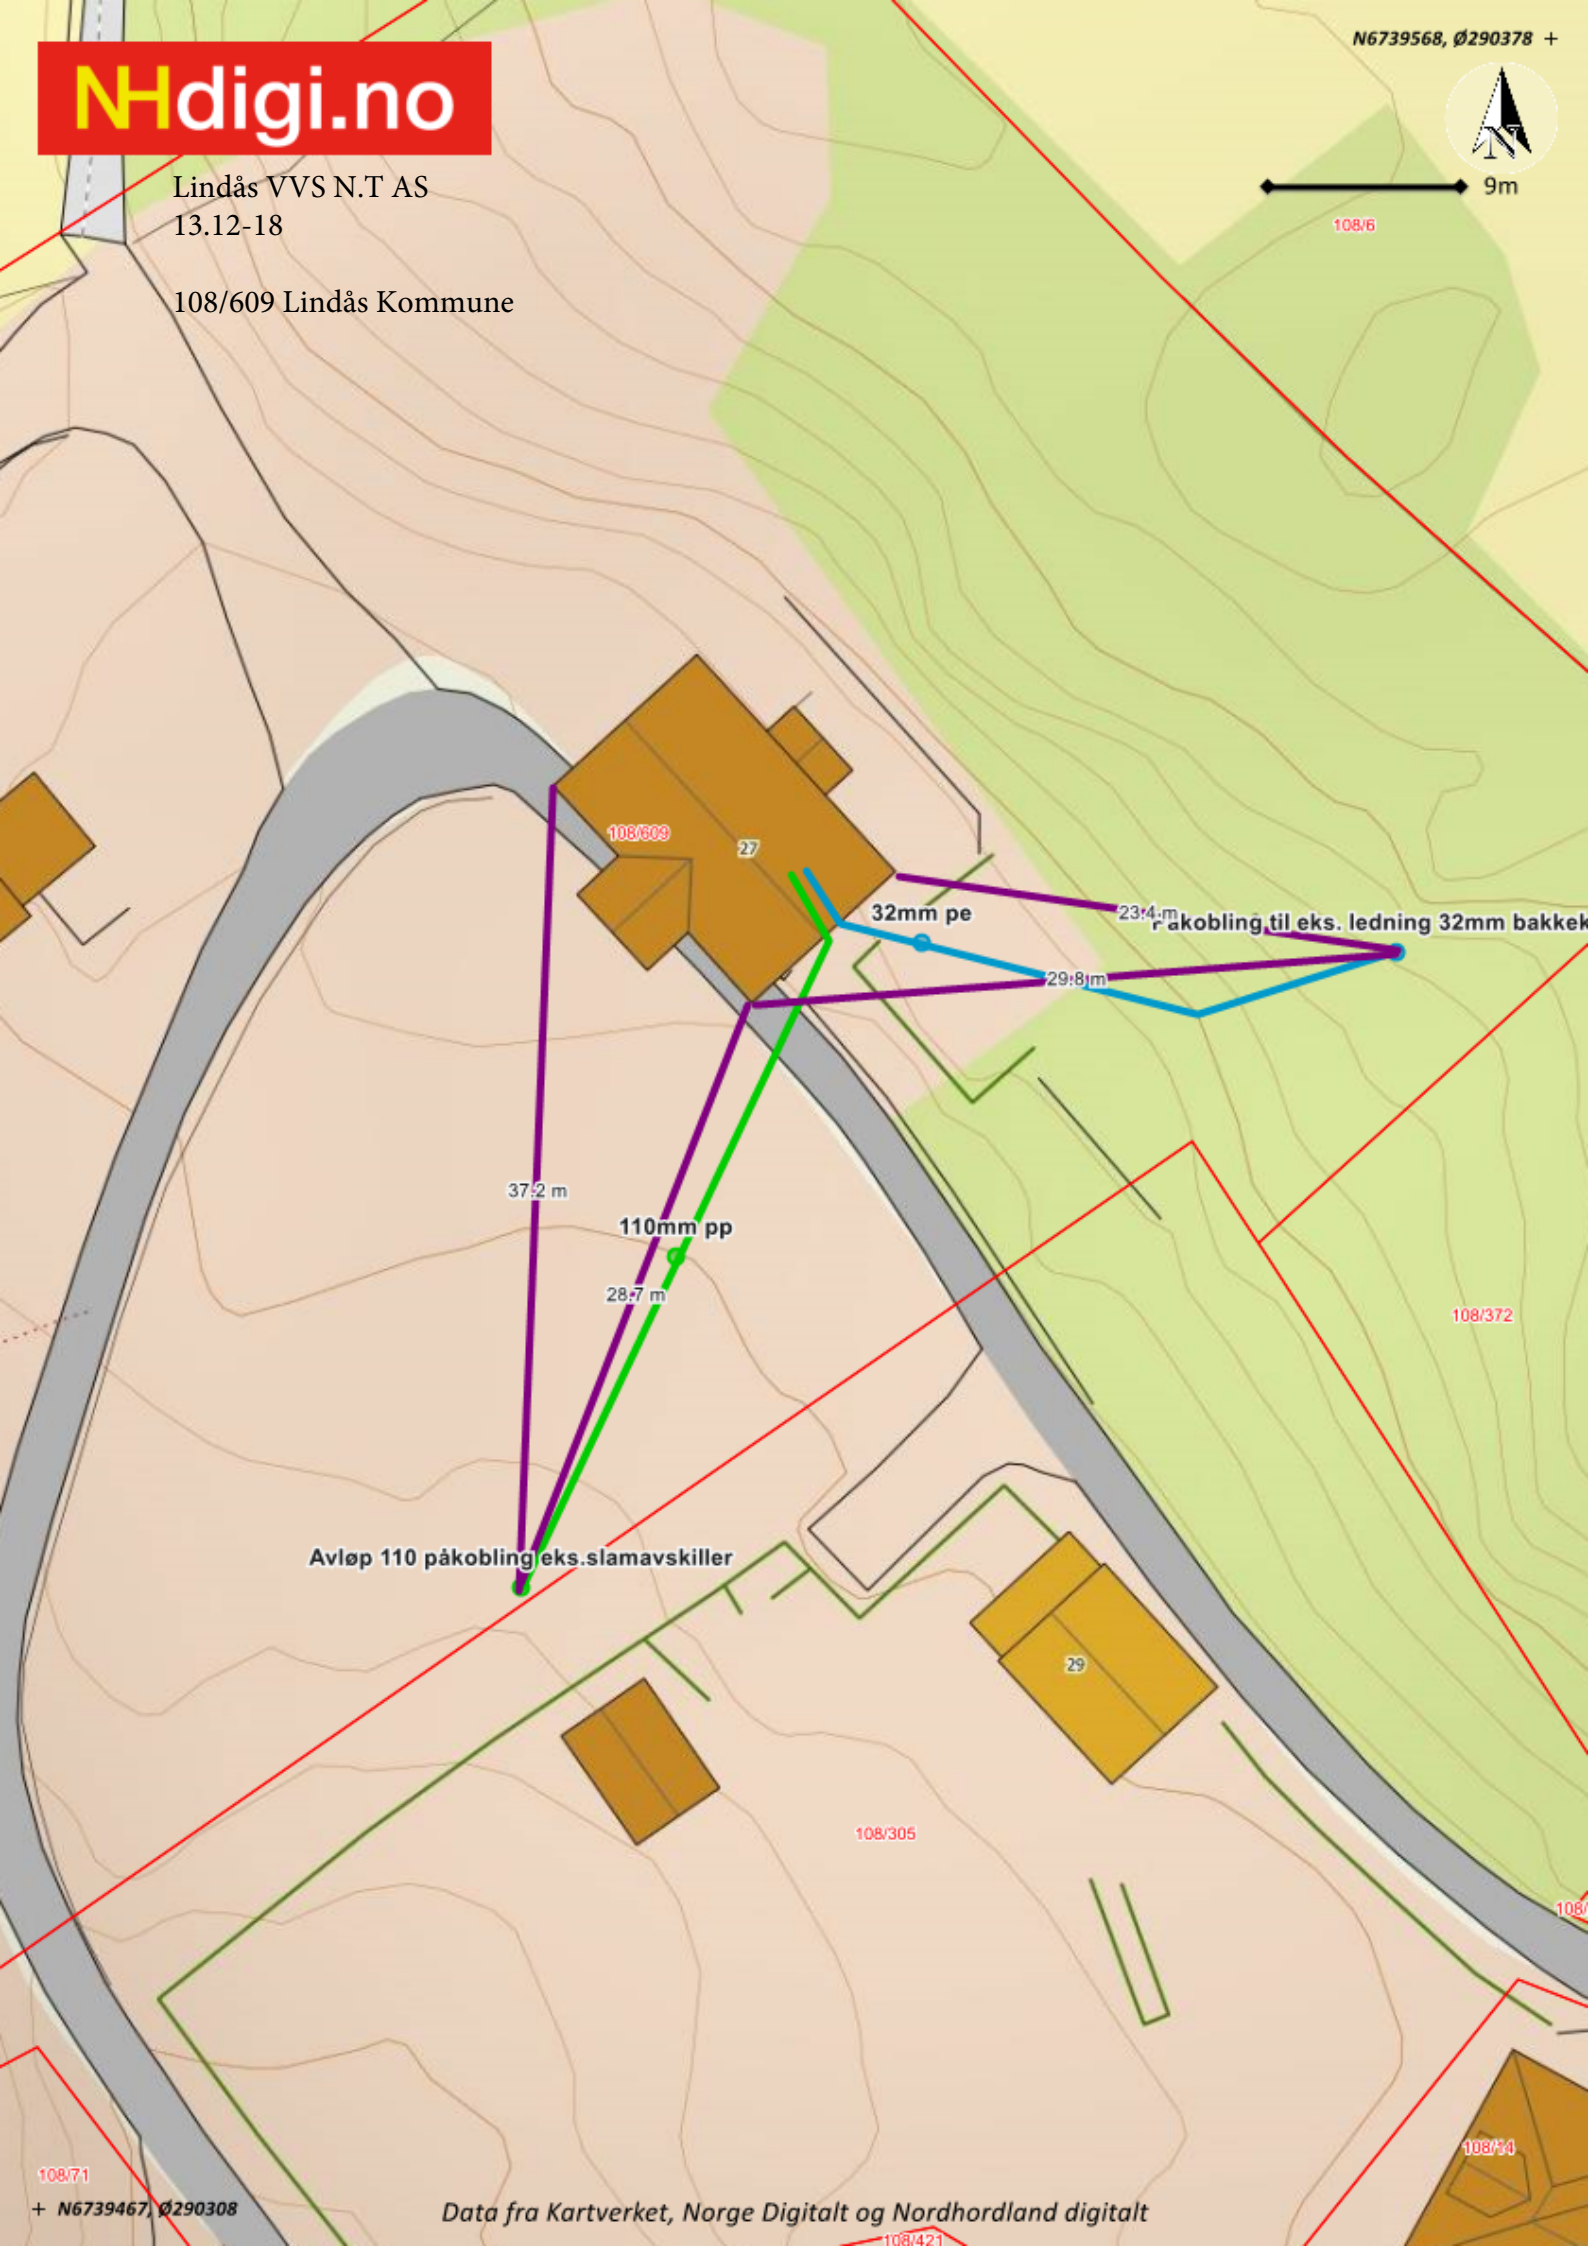

108/609

27

32mm pe

23.4 m

Påkobling til eks. ledning 32mm bakke

29.8 m

37.2 m

110mm pp

28.7 m

Avløp 110 påkobling eks. slamavskiller

108/372

29

108/305

108/71

+ N6739467, Ø290308

108/421

108/34