


D-1

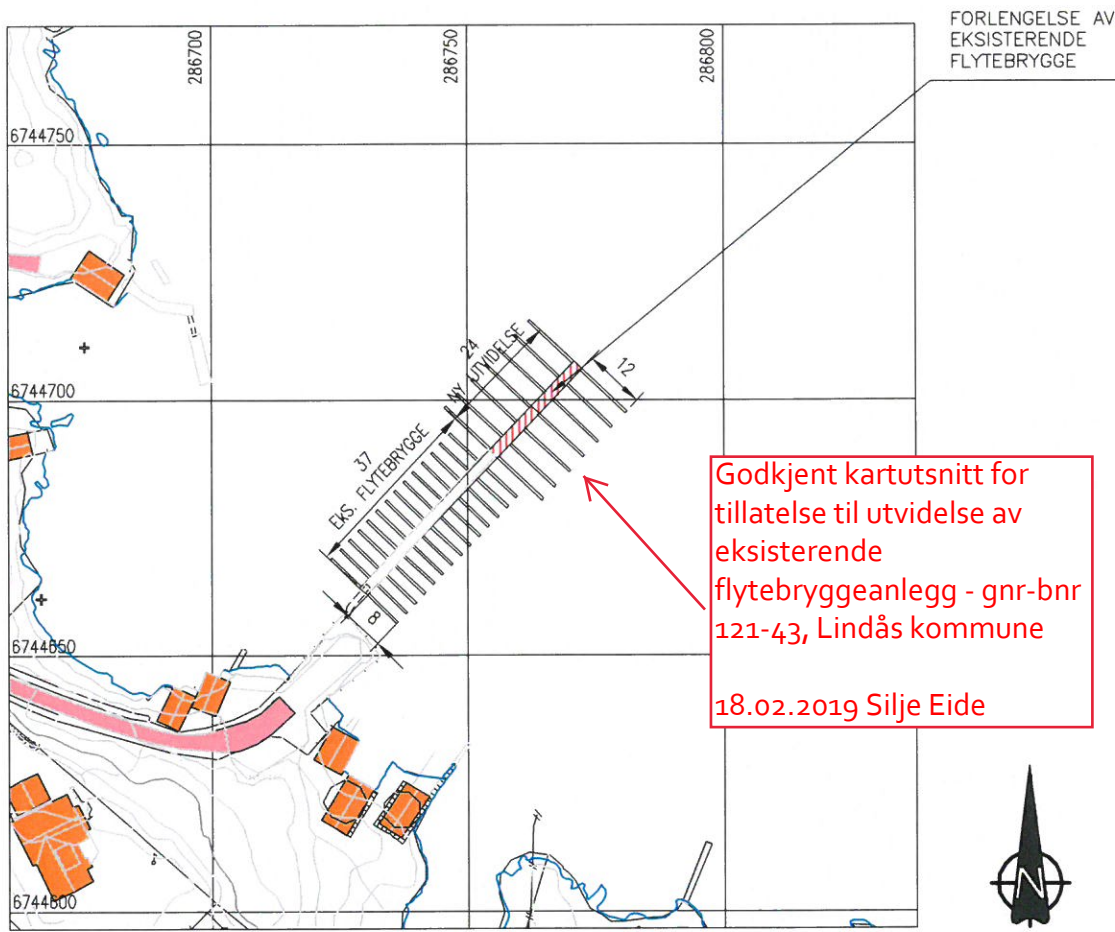

SITUASJONSPLAN
GNR.121 BNR.43, KNARVIGARDEN, LINDÅS KOMMUNE

A	OPPDATERT KARTUNDERLAG	07.06.2018/PKT DATE/SIGN	NOTE! * PART OF DRAWING MAY NOT BE SHOWN IN SCALE * DO NOT TAKE MEASURES ON DRAWING * ONLY RELAY ON GIVE DIMENSIONS	ACCORDING TO INTERNATIONAL LAWS, THIS DRAWING IS THE PROPERTY OF ARKOCONSULT AS. THE DRAWING CAN NOT BE USED, MADE PUBLIC OR HANDED OVER TO A THIRD PART WITHOUT OUR WRITTEN CONSENT. ANY INFRINGEMENT WILL LEAD TO LEGAL PROCEEDINGS.
	REV. / DESCRIPTION		KNARVIK NORD BÅTLAG GBNR. 121/43 LINDÅS KOMMUNE	REVISION/DATE: A/07.06.18 PROJECT NO.: 2015191
			SITAUSJONSPLAN UTVIDING FLYTEBRYGGE	DRAWING NO.: 63815191A01
			 ARKOCONSULT AS, Postboks 103, 5291 Valesf.f. Tel.: 56390003 - Fax: 56191130 - Mob.: 93241511 Mail: post@arkoconsult.no - Org.nr.: 997089782 MVA	SCALE: 1:1000 DRAWN: PKT CHECKED: