

Situasjonskart -


217/78



Dato: 12-03-2019

Målestokk: 1:500



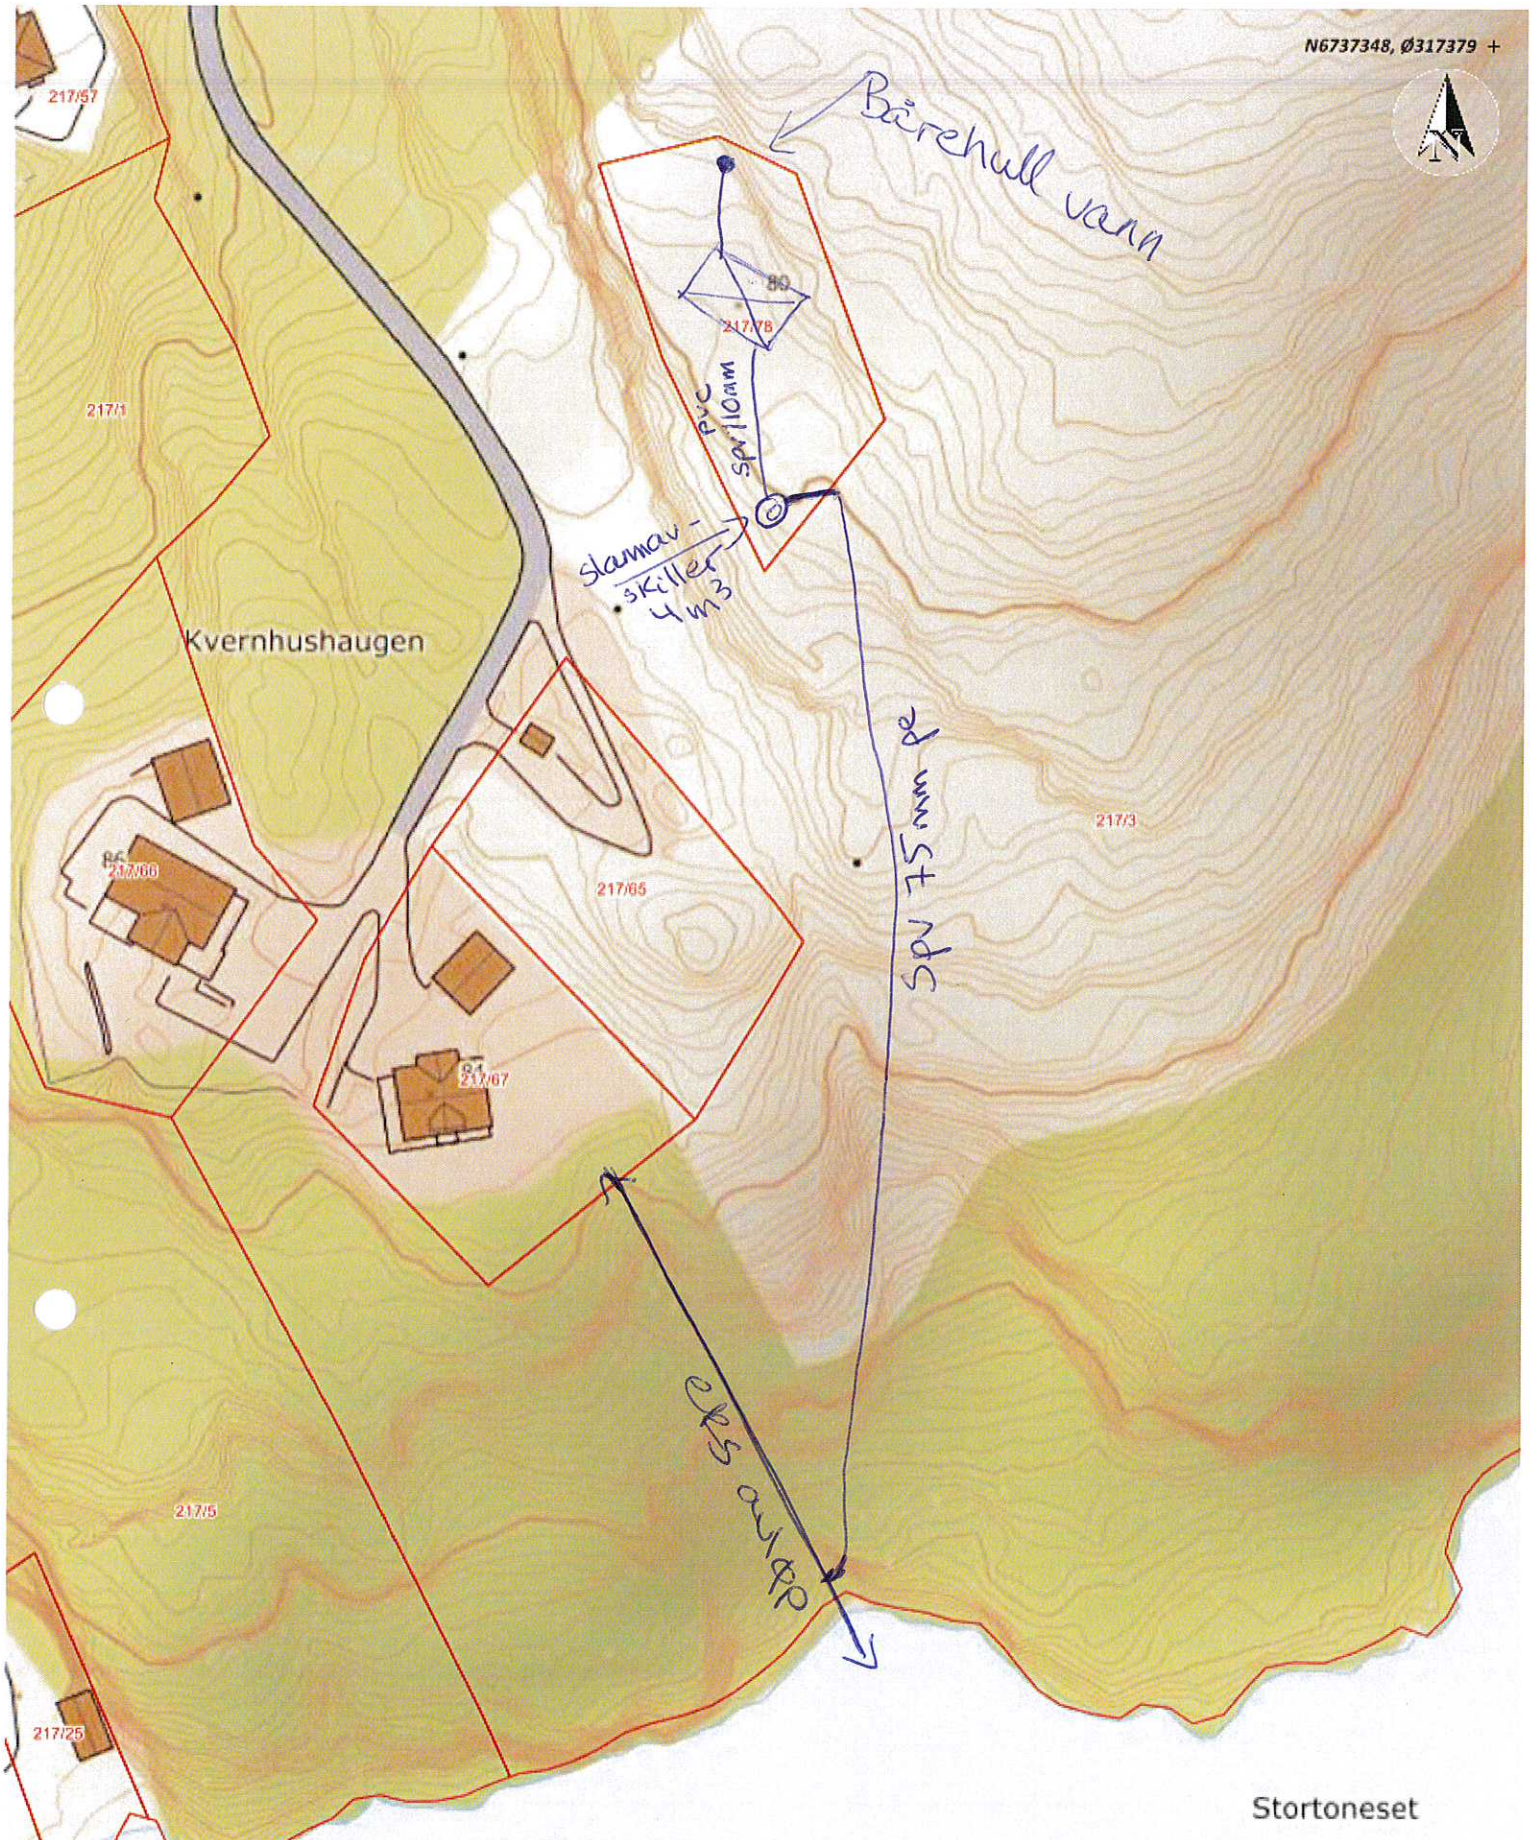

Stortoneset

Situasjonskart -

217/78



Dato: 12-03-2019

Målestokk: 1:1 000

30m