
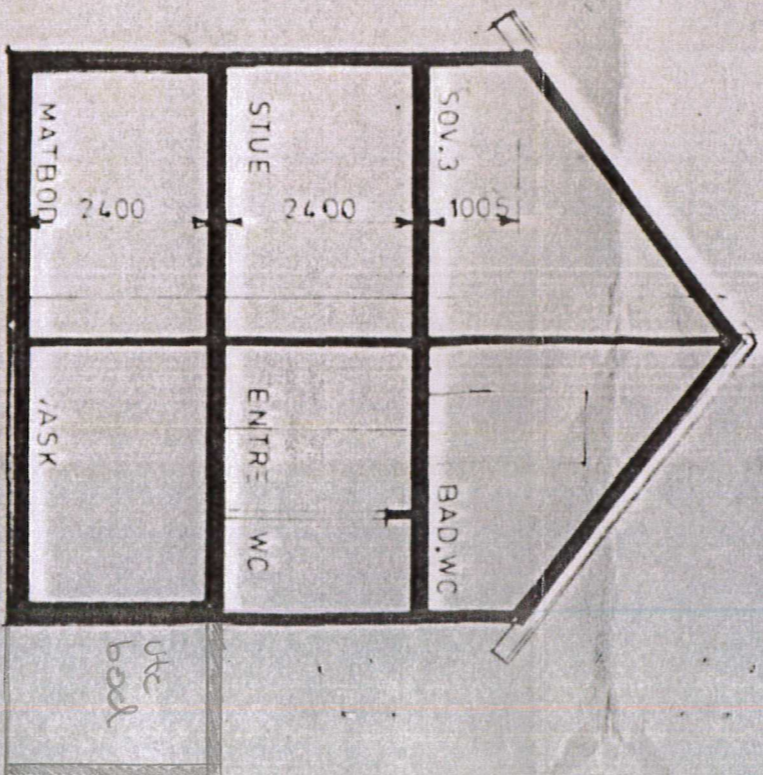
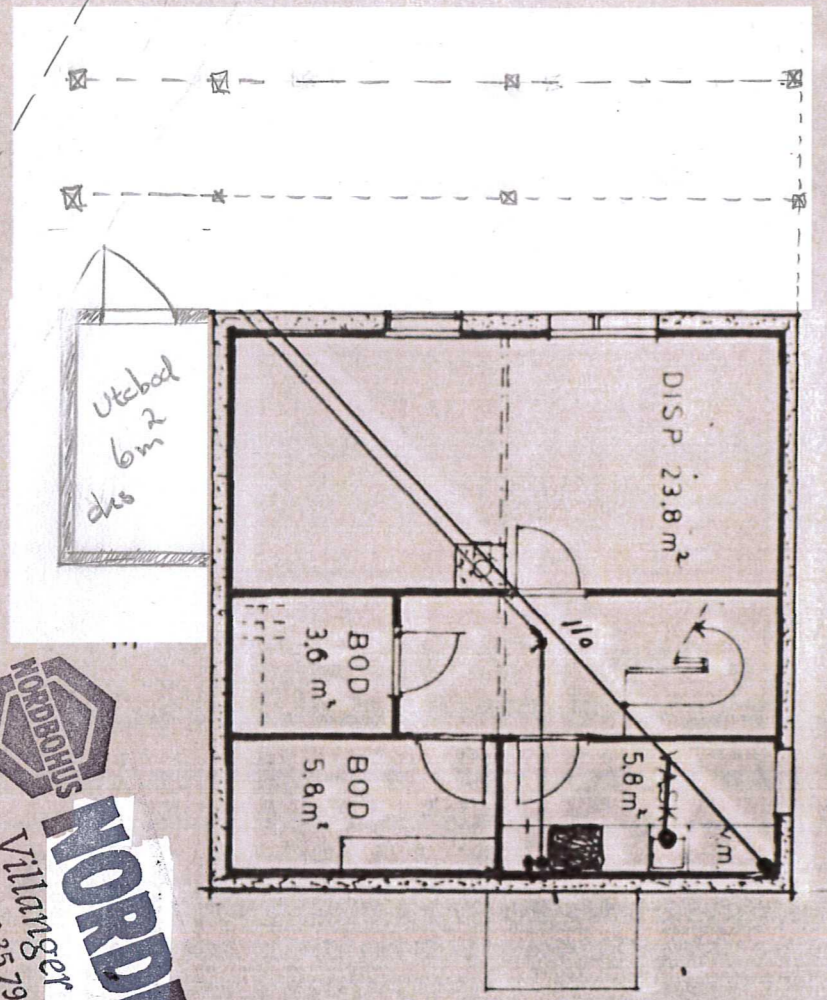
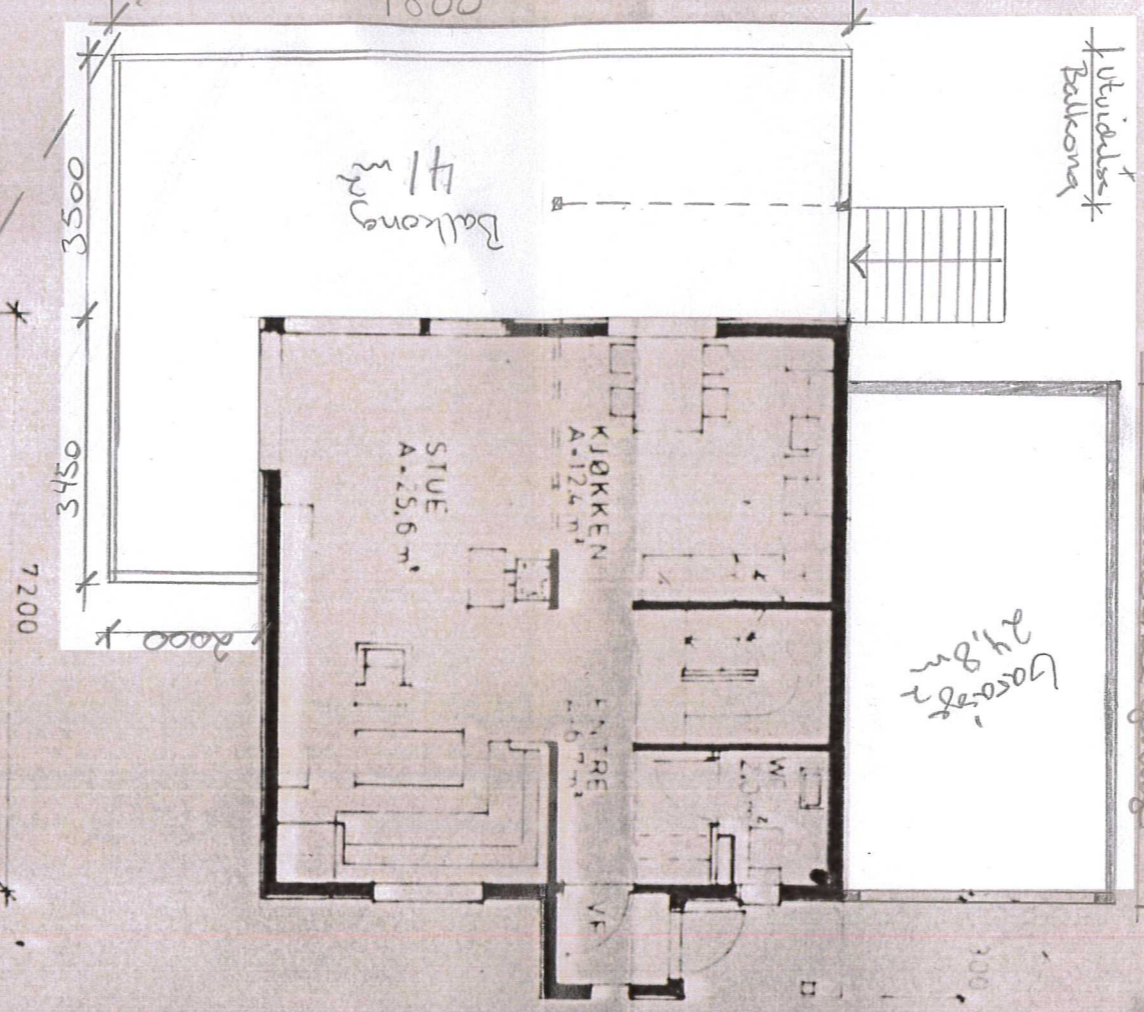


Plan, snitt og (ballong utvidelse)

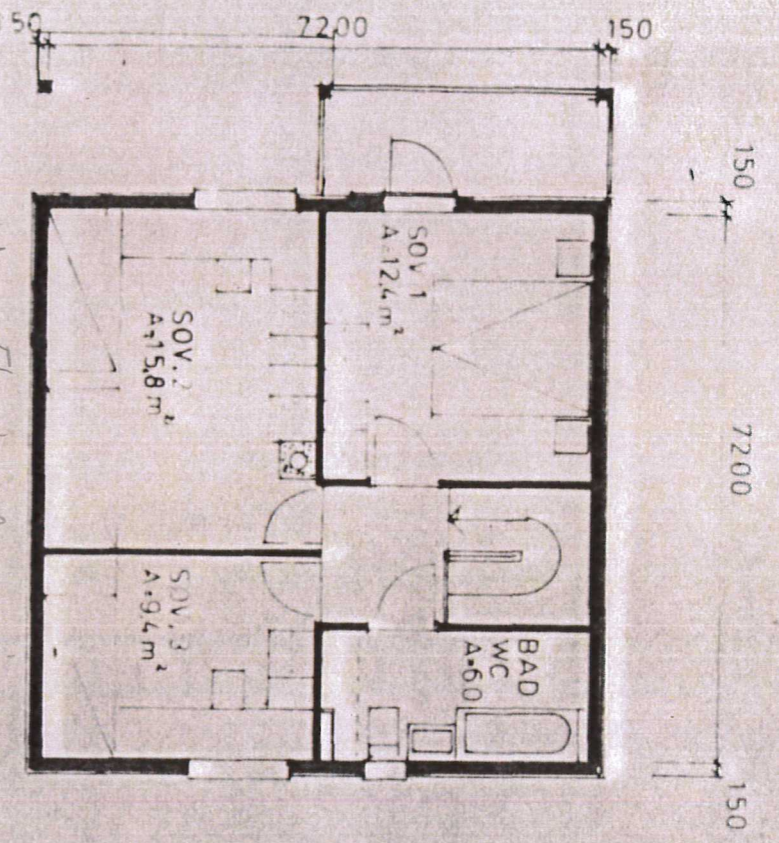

HUS TYPE A

	BRA	FAKTOR	BA
1. LETASJE	53,6	1,0	53,6
2. ---	518	0,7	36,3
U. ---	490	0,5	24,5
SUM	1544		114,4

**NORDBOHUS**  
Vilanger & Sønner AS  
Tlf.: 56 35 79 70 - Fax: 56 35 79 71  
www.nordbohus.no

1:100 14.05.19