
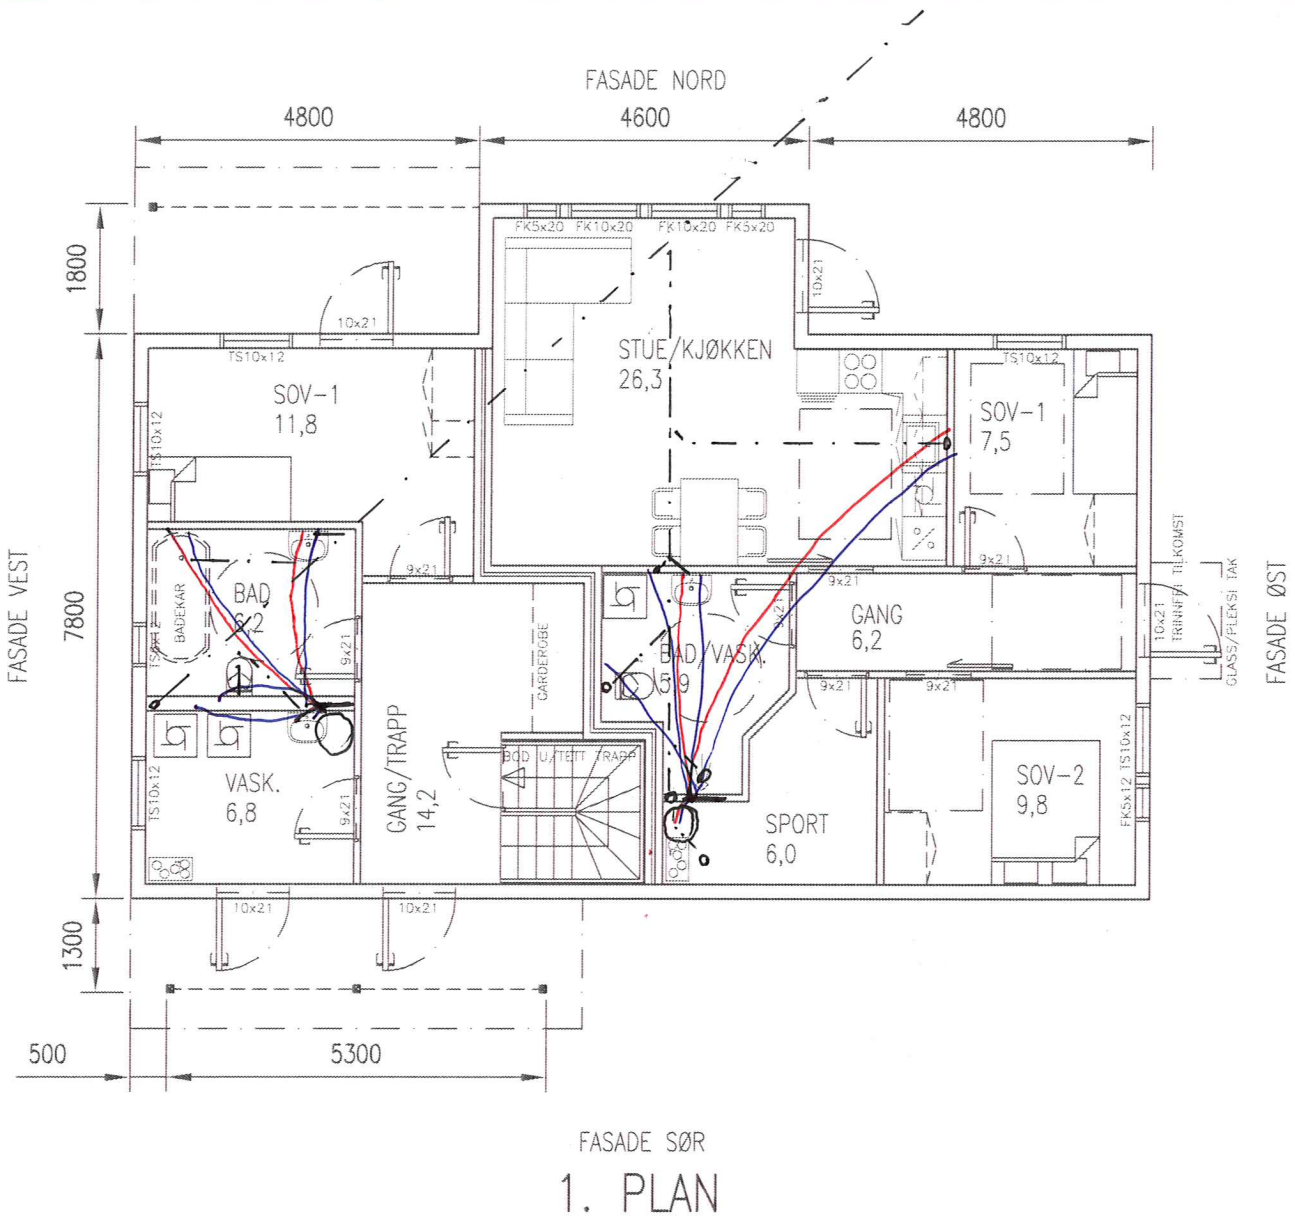


SITUASJONSPLAN
GNR.141, BNR.80, LINDÅS KOMMUNE

OK GULV 1. PLAN: KOTE +59,5


FOR TERRENGPROFILER, SE TEGNING 50519134A11 OG 12.

| | | | | |
|---|--------------------------------|--|--|---|
| A | 06.06.19/LAH | NOTE! * PART OF DRAWING MAY NOT BE SHOWN IN SCALE * DO NOT TAKE MEASURES ON DRAWING * ONLY RELAY ON GIVE DIMENSIONS | ACCORDING TO INTERNATIONAL LAWS, THIS DRAWING IS THE PROPERTY OF ARKOCONSULT AS. THE DRAWING CAN NOT BE USED, MADE PUBLIC OR HANDED OVER TO A THIRD PART WITHOUT OUR WRITTEN CONSENT. ANY INFRINGEMENT WILL LEAD TO LEGAL PROCEEDINGS. | |
| | DATE/SIGN | ASBJØRN OG JAZEL G. KAARSTAD | REVISION/DATE: A/06.06.19 | |
| | MUR PROFIL REV. DESCRIPTION | NY ENEBOLIG M/UTLEIGE | PROJECT NO.: 2019134 | |
| | | GBNR. 141/80, LINDÅS SITUASJONSPLAN | DRAWING NO.: 50519134A10 | |
| | |  ARKOCONSULT AS, Postboks 103, 5291 Valest.f. Tel.: 56390003 - Fax.: 56191130 - Mob.: 93241511 Mail: post@arkoconsult.no - Org.nr.: 918269665 MVA | | SCALE: 1:500 FORMAT: A3 DRAWN: LAH DATE: 04.06.19 CHECKED: OH DATE: 05.06.19 |



SPORTSBOD TIL HOVEDDEL I NY GARASJE,
EGNE TEGNINGER FOR GARASJE

| | |
|-----------------------|---------------------|
| BYA: | 134,2m ² |
| BRA 1. PLAN INNV.: | 109,1m ² |
| BRA UMLEIE DEL: | 65,0m ² |
| BRA HOVEDDEL 1. PLAN: | 41,4m ² |
| BRA 2. PLAN INNV.: | 109,1m ² |
| BRA TAKOVERBYGG: | 13,1m ² |
| BRA TIL SAMMEN: | 231,3m ² |

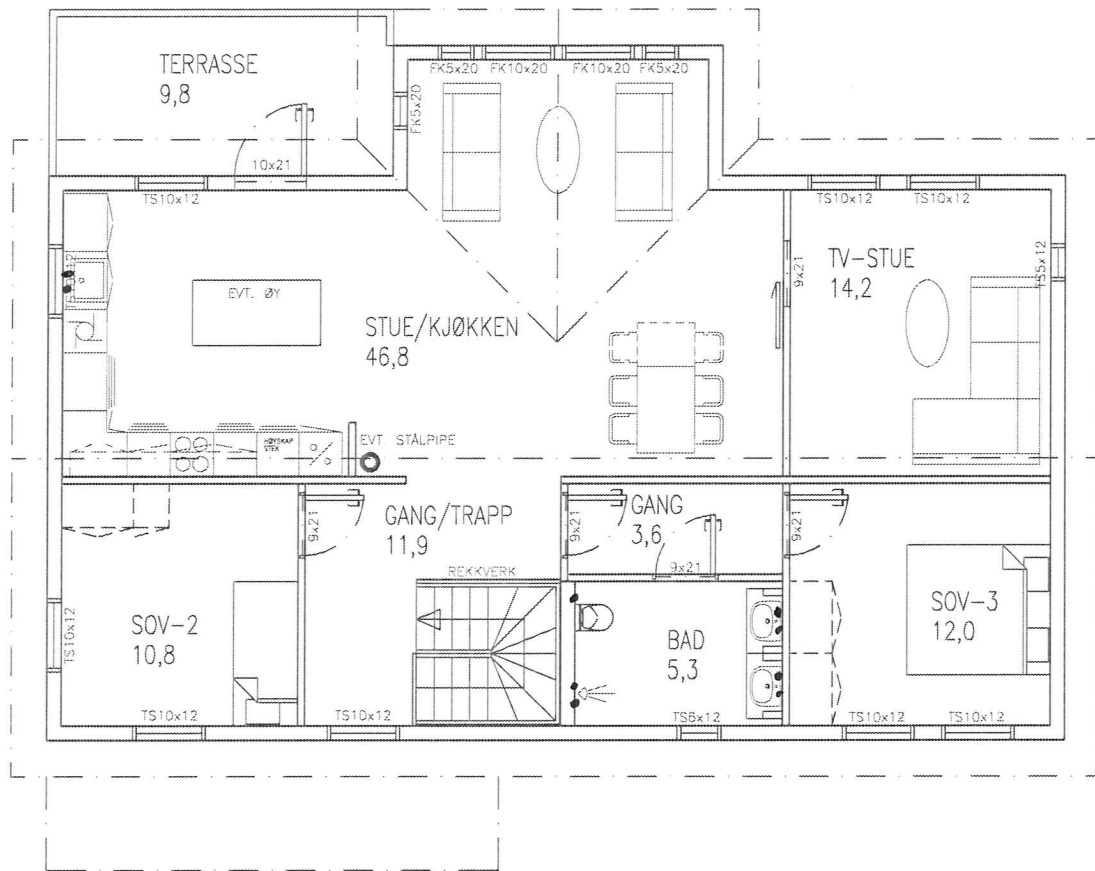

2. PLAN