


D1

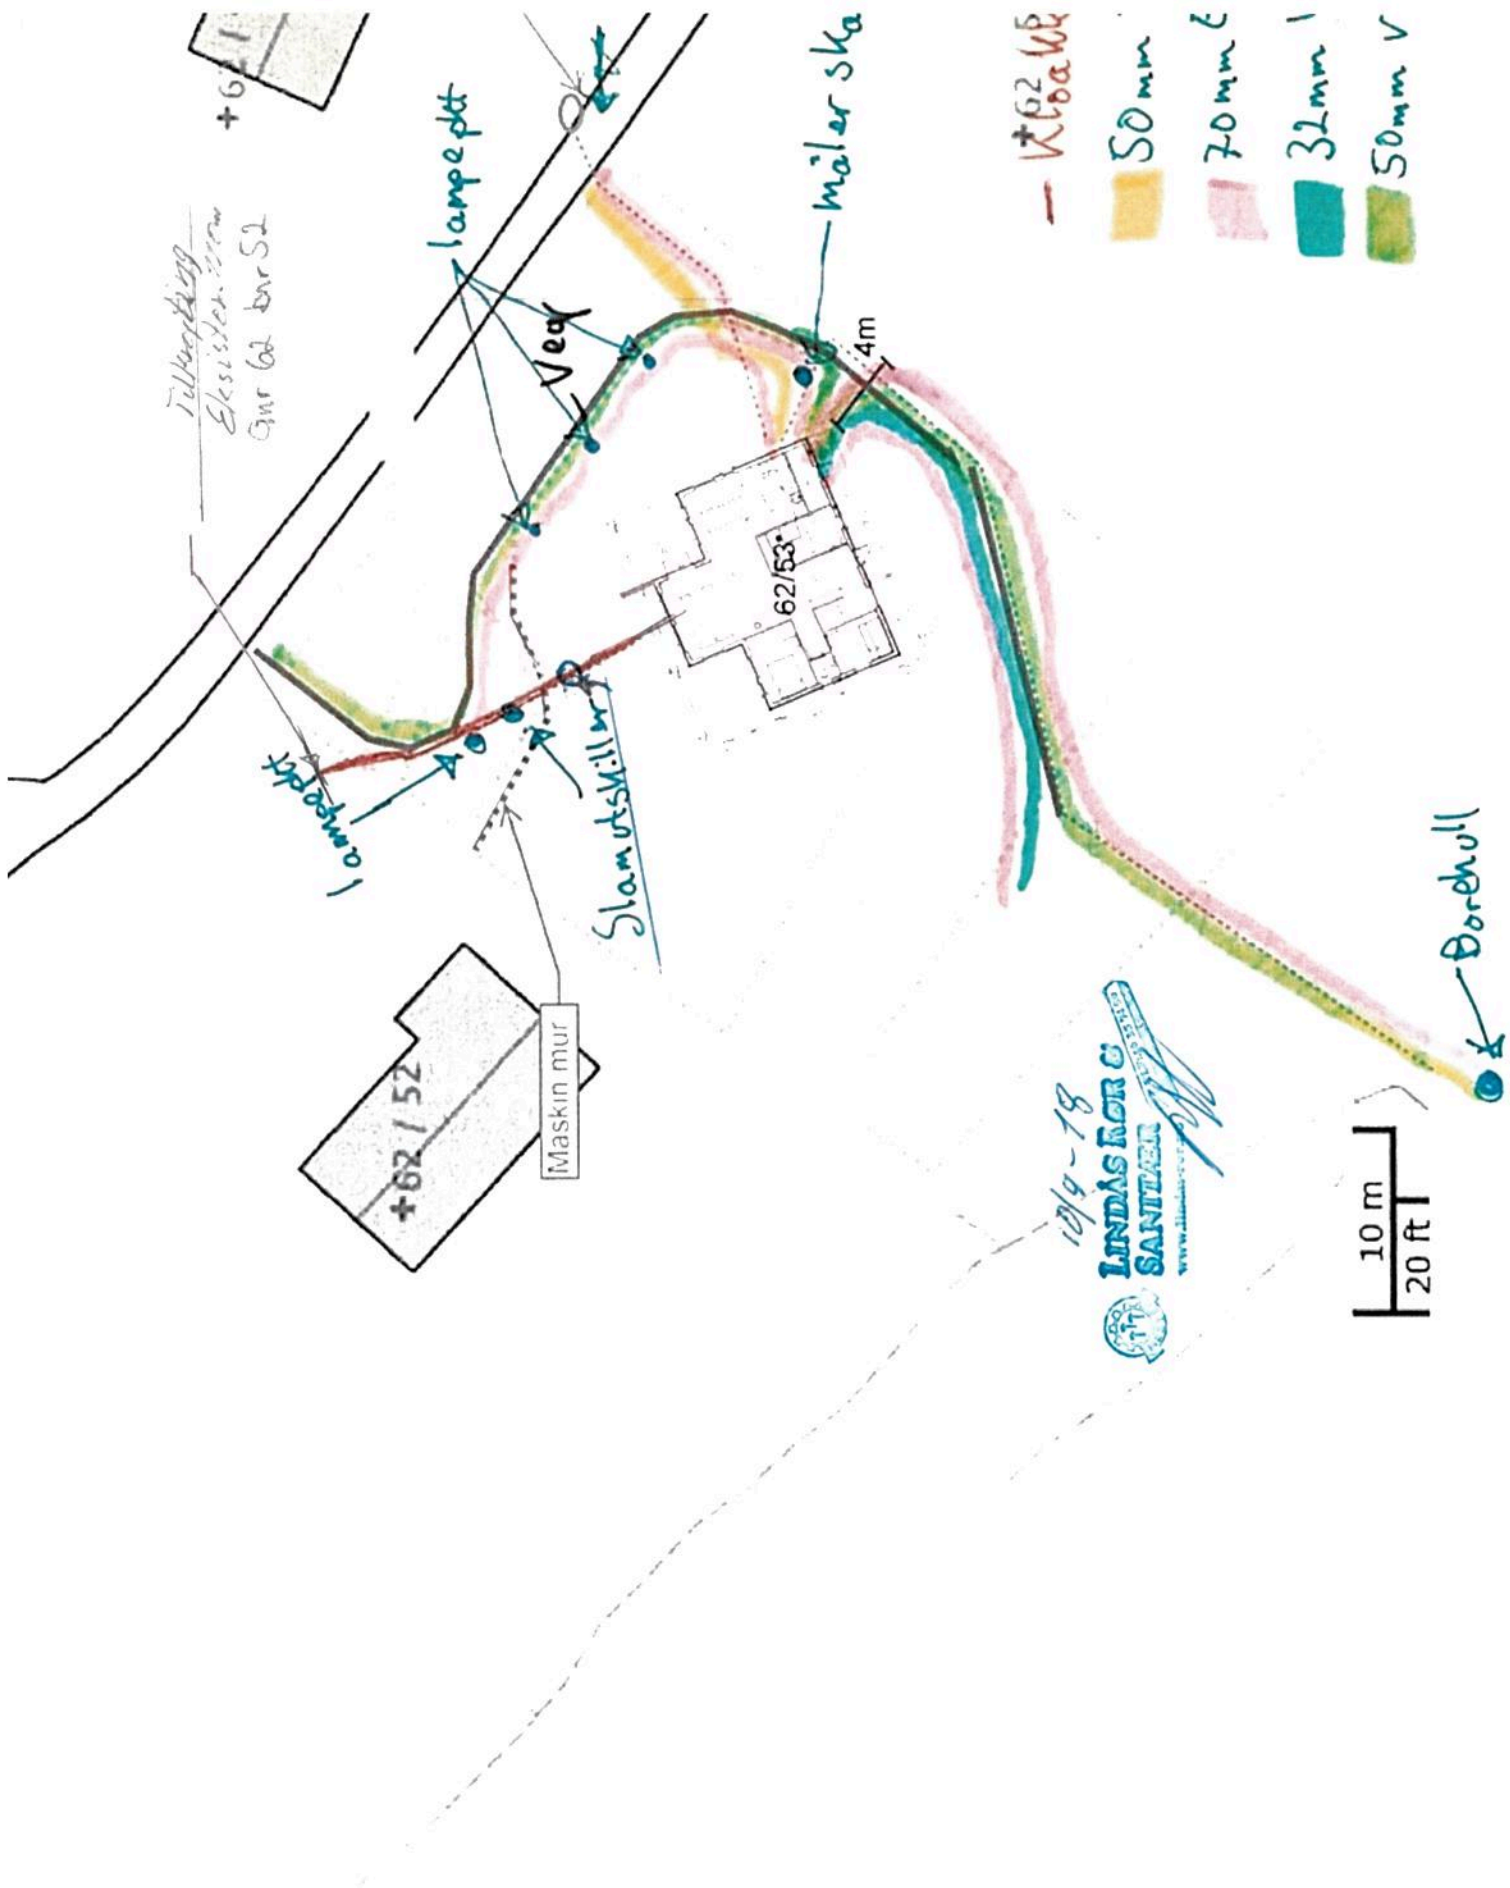

Gnr 62 bnr 52

+62/1

lampepkt

Ved

Mäler ska

62/53

4m

lampepkt

Slamutskylling

+62/52

Maskin mur

Kloa KE

50mm

70mm L

32mm I

50mm V

10/9-18



Borehull