


E III

3

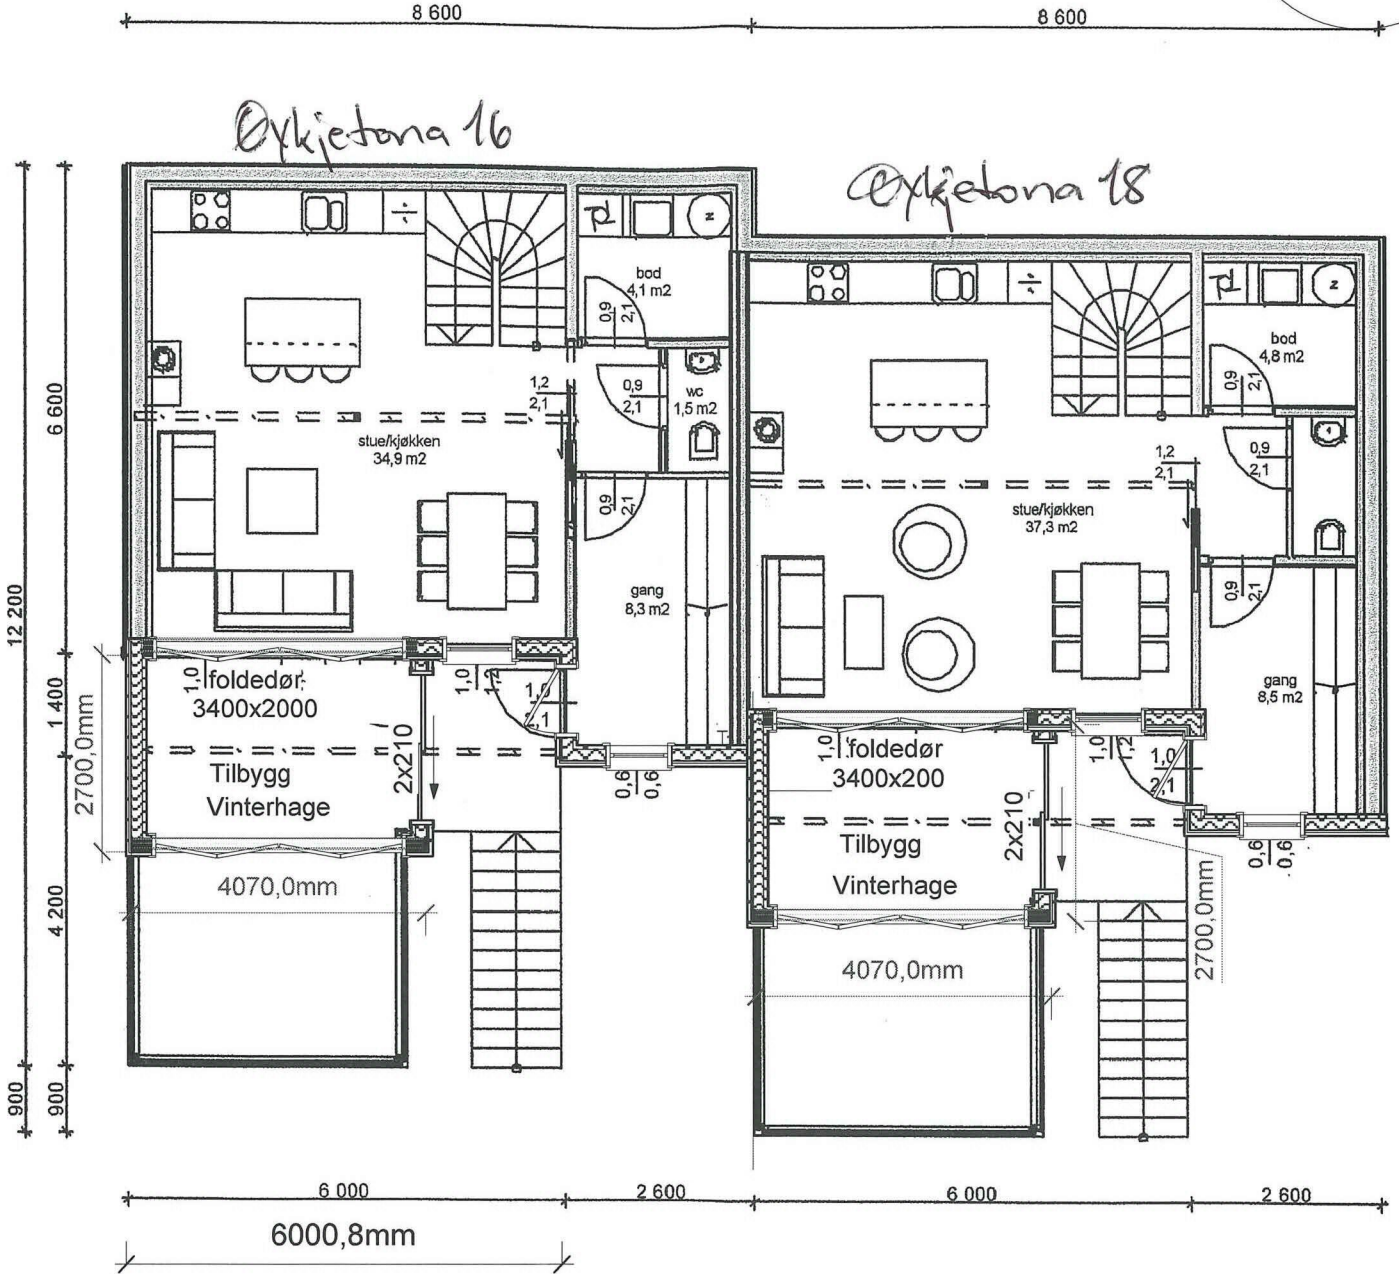

Utvidelese a

zeng Lir

Marie Nor