

• = utfu bakkekran  
 60 cm fra 315  
 Kum

**Stendal VVS AS**  
 Blombakken 1 - 5911 ALVERSUND  
 E-post: sten-vvs@online.no  
 Org.nr. 980 626 180


Situasjonskart -  
 124 / 26



Dato: 16-07-2019

Målestokk: 1:350



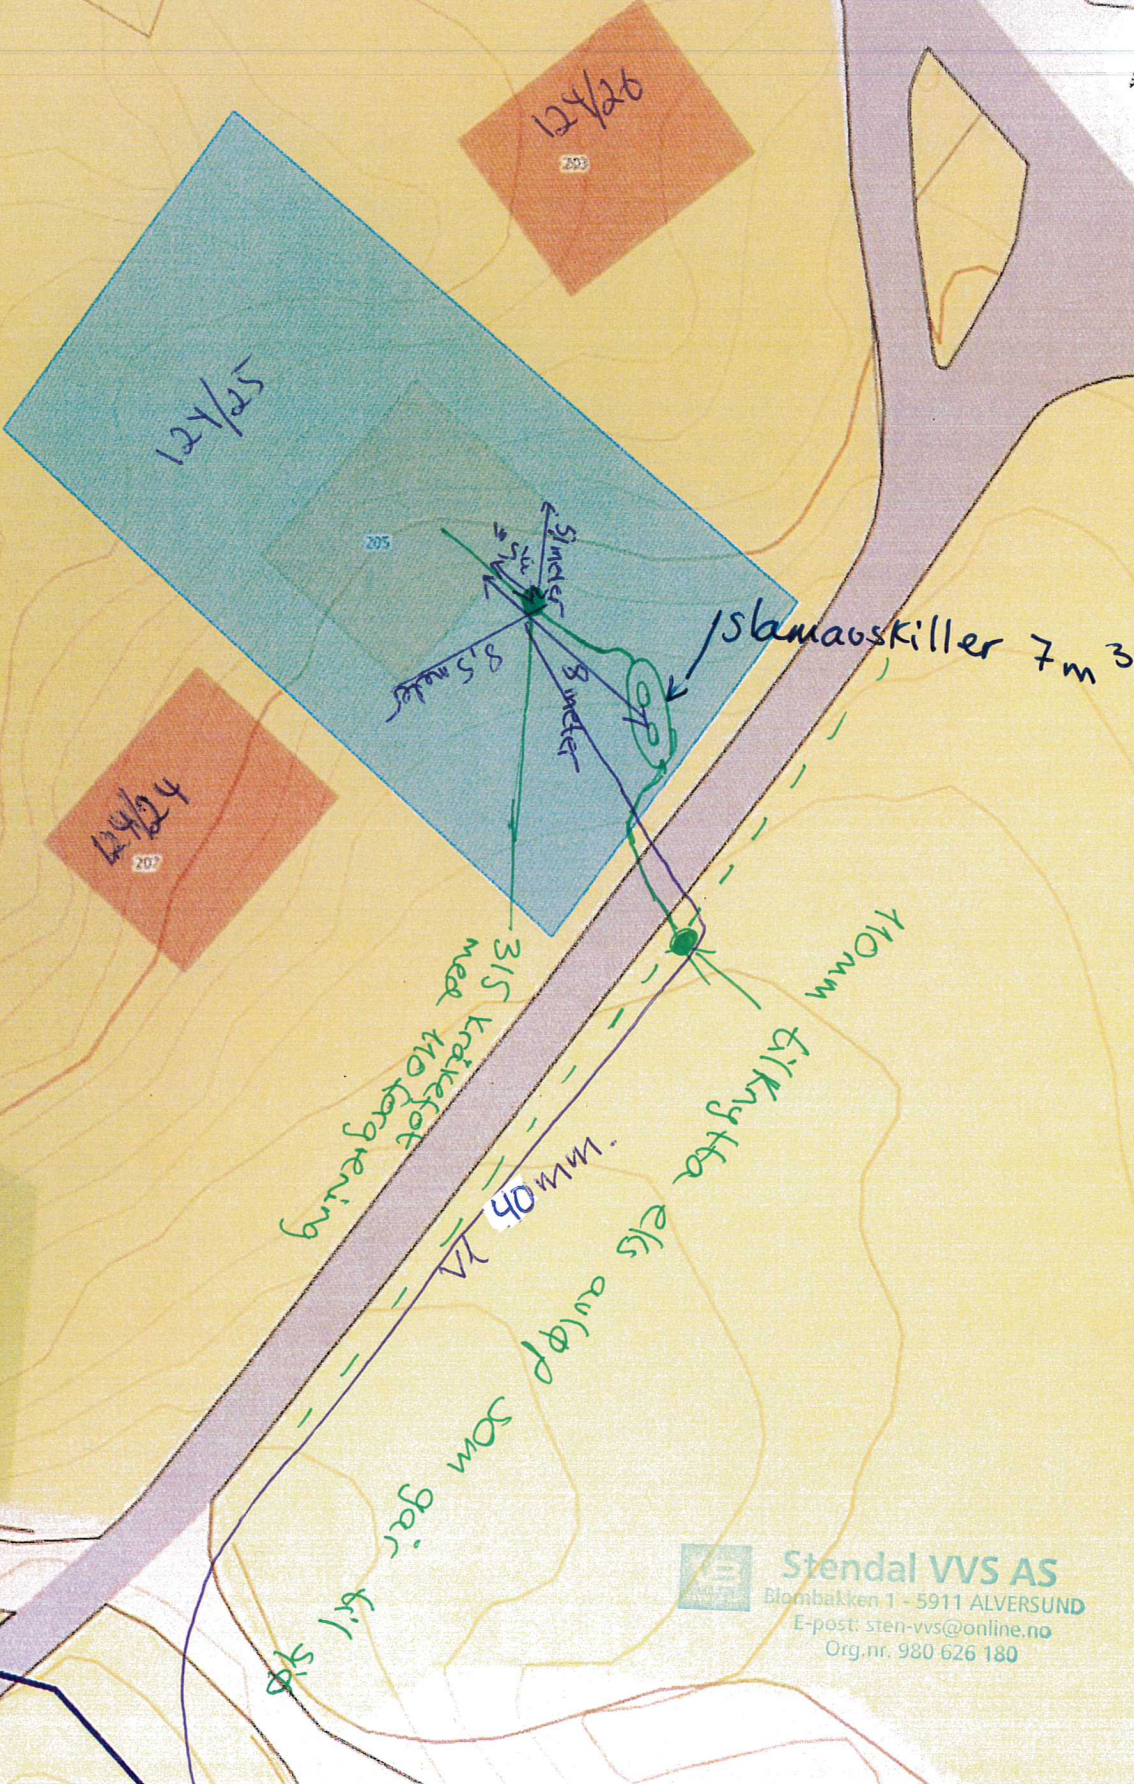

**Stendal VVS AS**  
 Elombakken 1 - 5911 ALVERSUND  
 E-post: sten-vvs@online.no  
 Org.nr. 980 626 180


Situasjonskart - gnr  
 124 / 24, 25 og 26  
 felles avløp og  
 vann.



Dato: 16-07-2019

Målestokk: 1:350



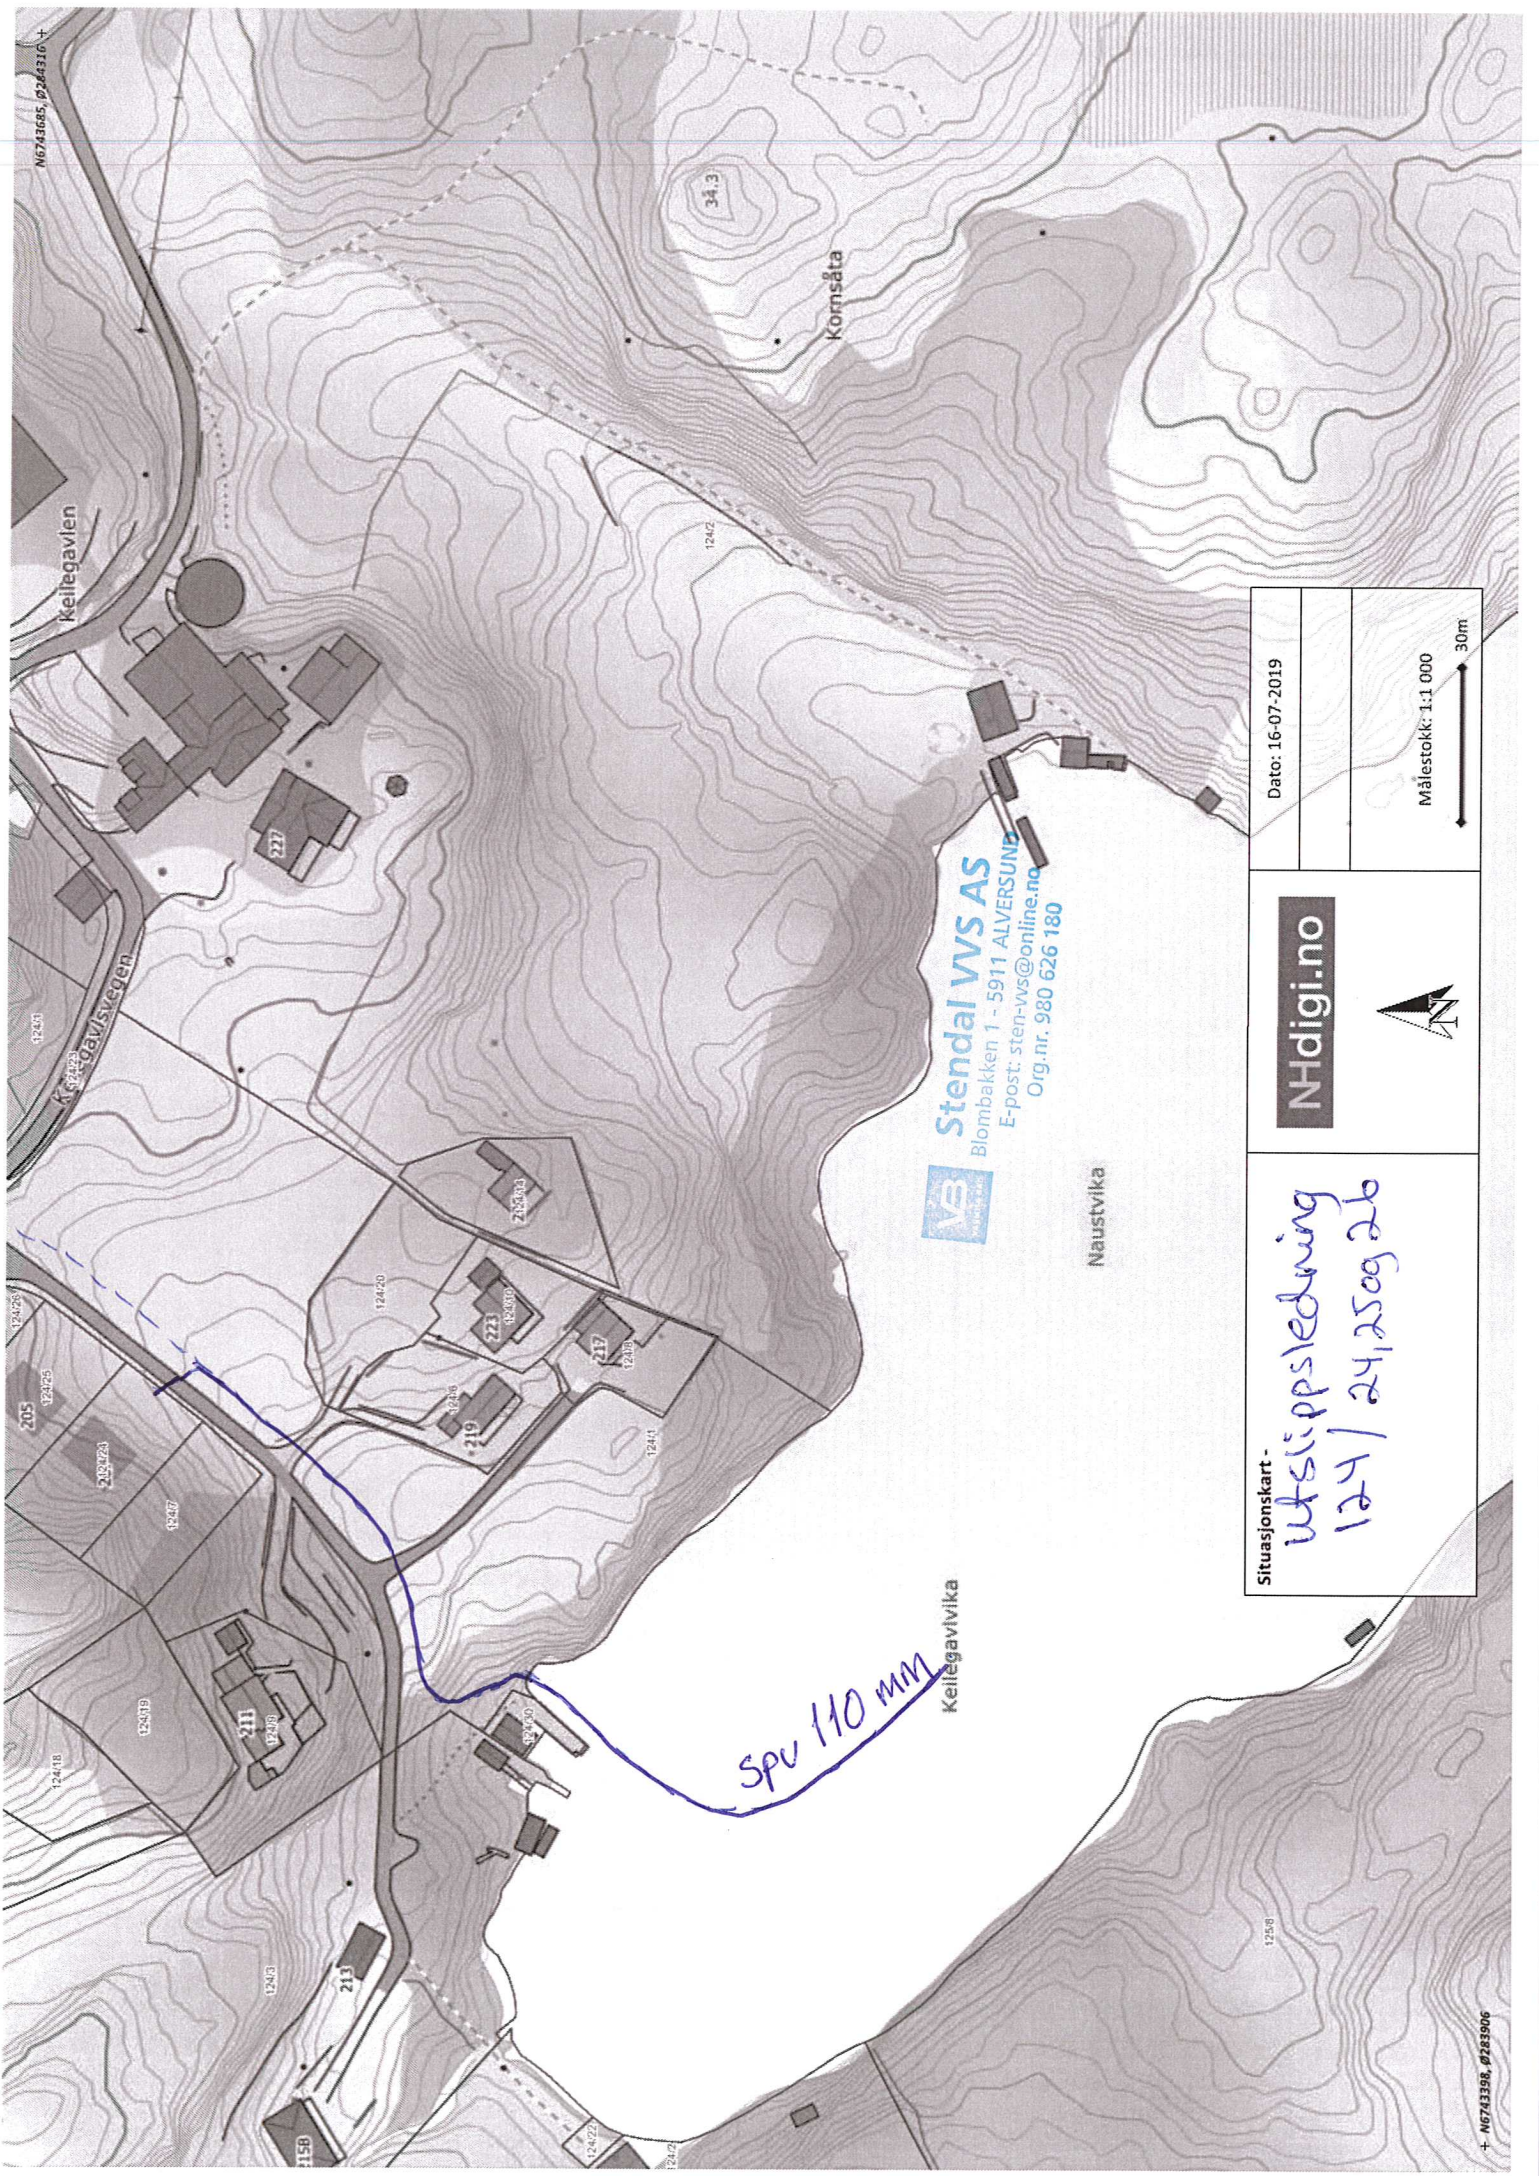

N6743885, Ø2464310

Keilegavliken

Komsåta

1242

12420














Keilegavliken


**Stendal VVS AS**  
Blombakken 1 - 5911 ALVERSUND  
E-post: sten-vvs@online.no  
Org.nr. 980 626 180



Naustvika

Keilegavlika

SPU 110 mm

Date: 16-07-2019	<b>NHdigi.no</b>	Situasjonskart - <i>utslippsledning 124 / 24,25 og 26</i>
		
Målestokk: 1:1 000	