

• = utfu bakkekran
40 cm fra 315
km

VB Stendal VVS AS
Blømbakken 1 - 5911 ALVERSUND
E-post: sten-vvs@online.no
Org.nr. 980 626 180


Situasjonskart -
124 / 25



Dato: 16-07-2019

Målestokk: 1:350



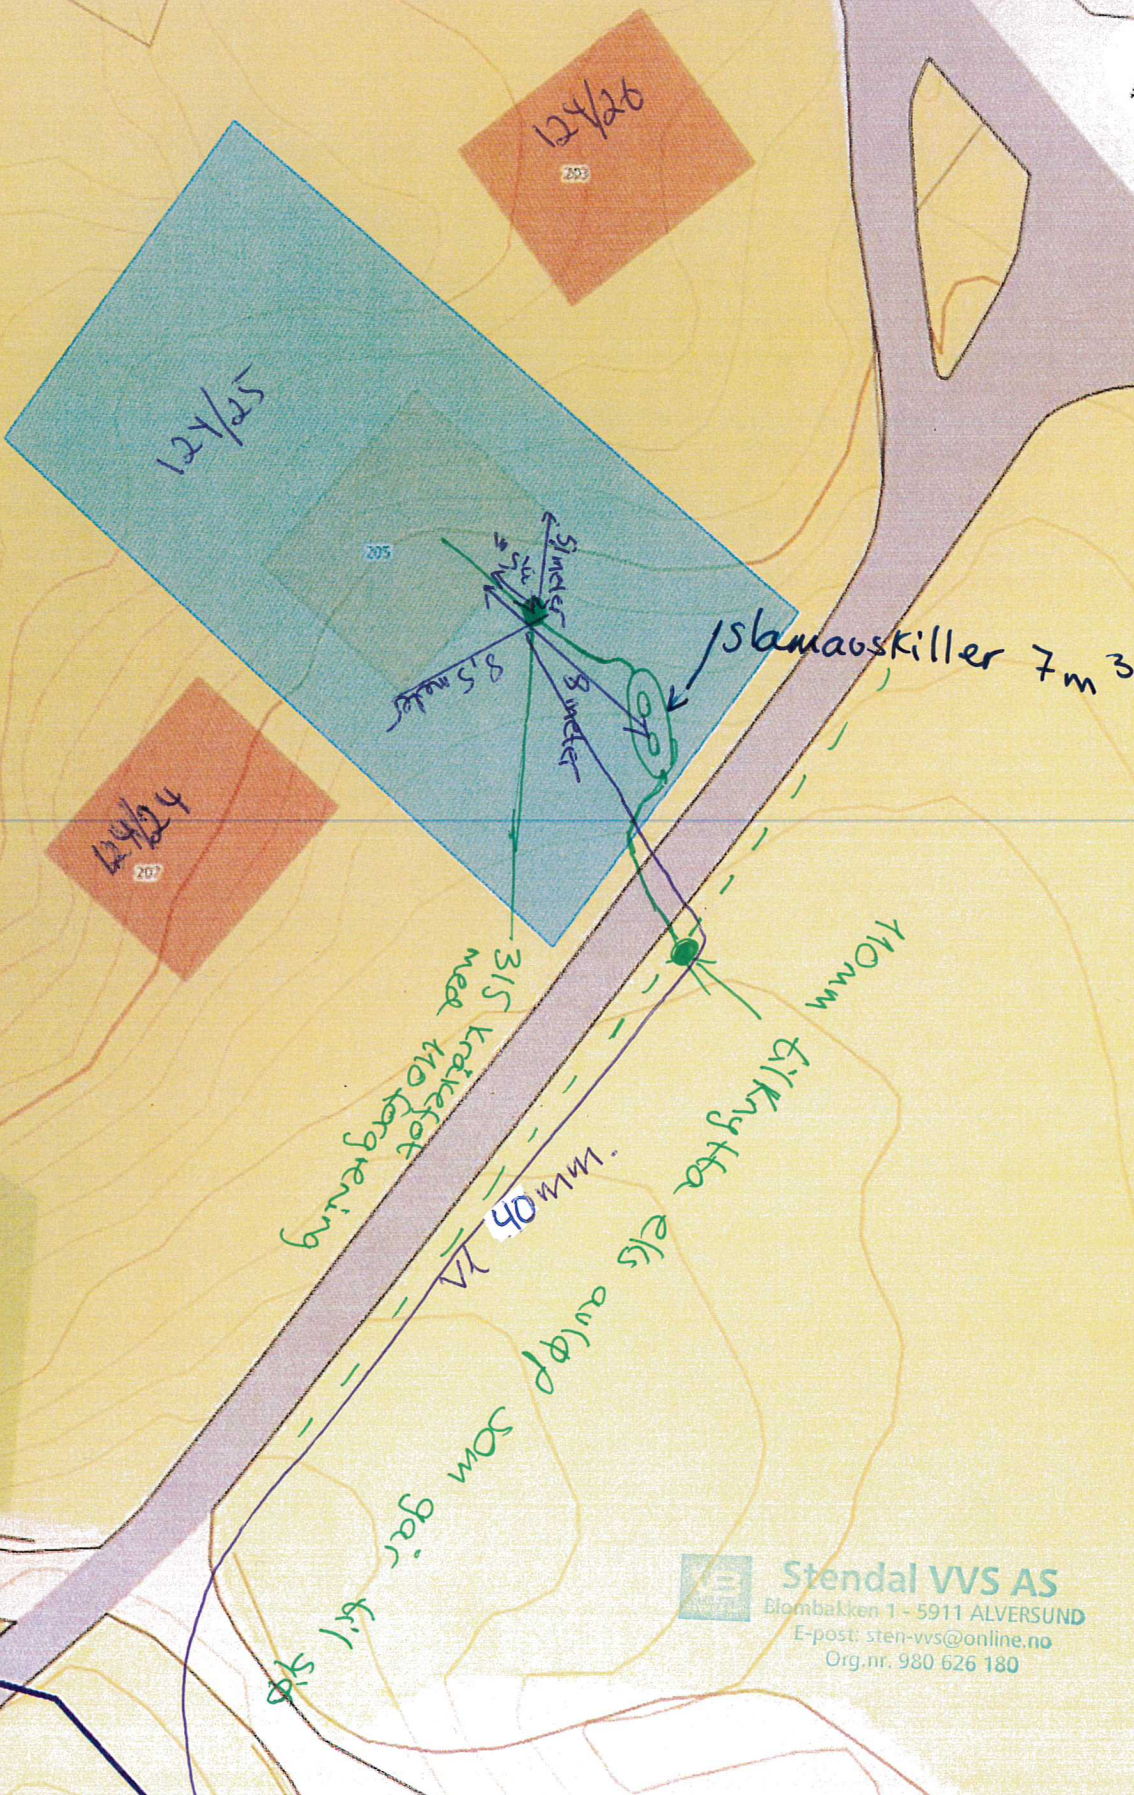


Stendal VVS AS
 Elombakken 1 - 5911 ALVERSUND
 E-post: sten-vvs@online.no
 Org.nr. 980 626 180


Situasjonsskart - gnr
 124 / 24, 25 og 26
 felles avløp og
 vann.



Dato: 16-07-2019

Målestokk: 1:350



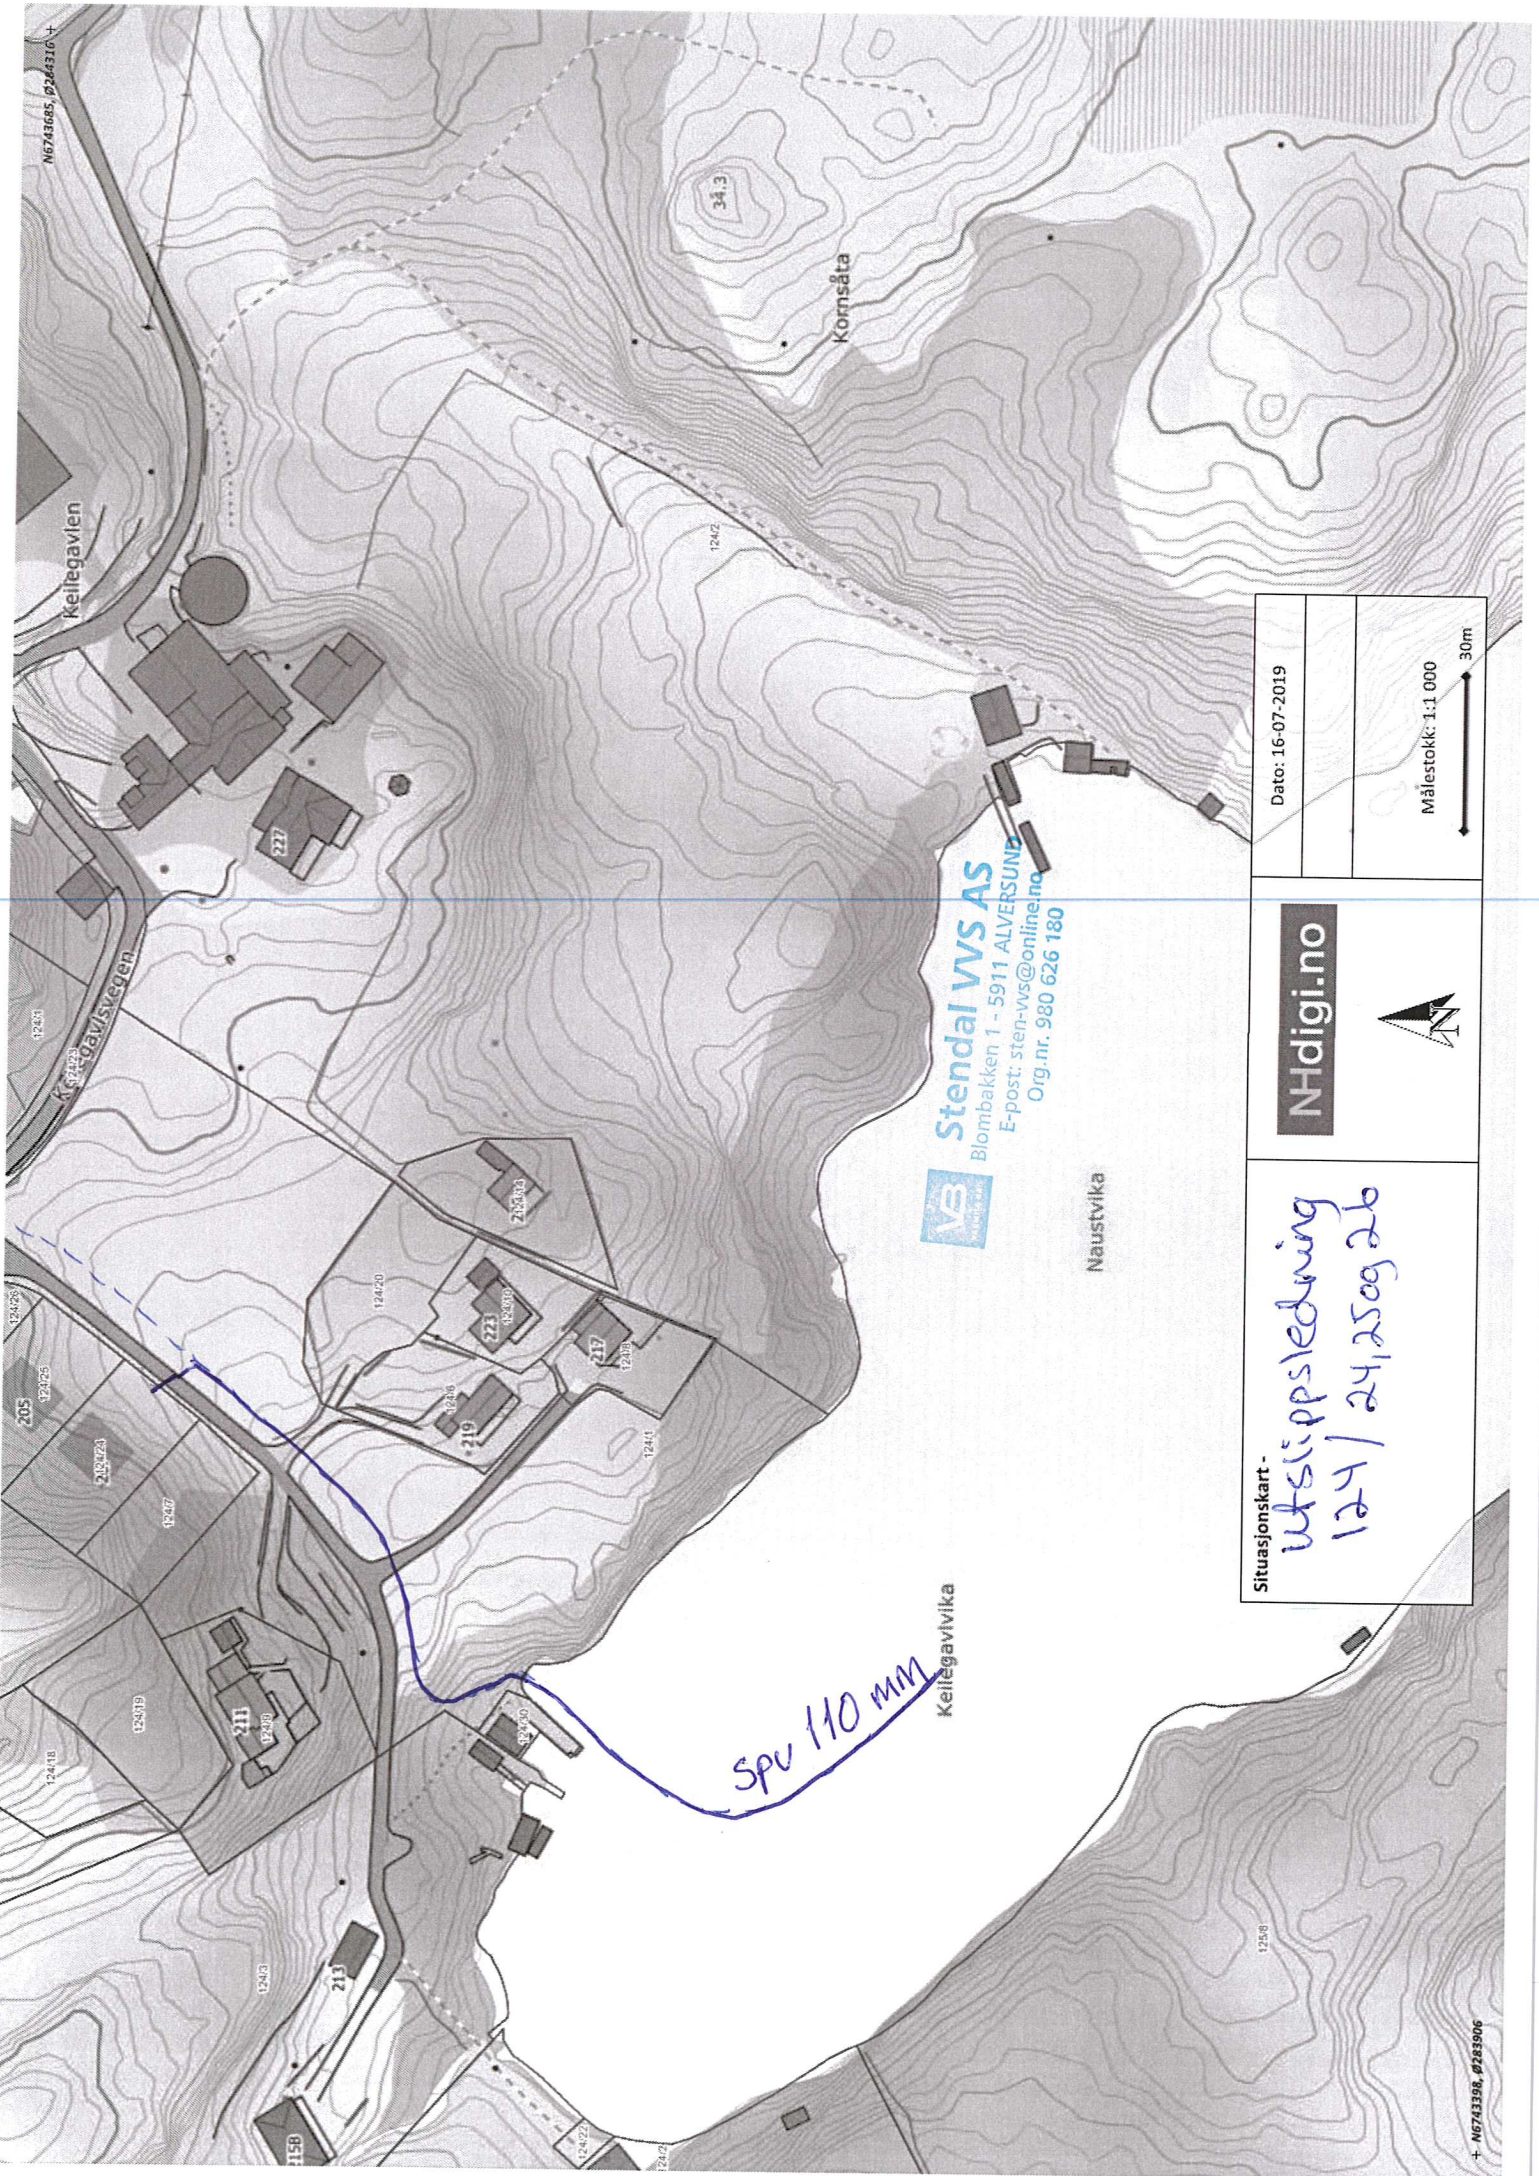

N6743398, 0283906

Keilegavviken

Kornsåta

1242

12470














Keilegavviken

Stendal VVS AS
 Blombakken 1 - 5911 ALVERSUND
 E-post: stend-vvs@online.no
 Org.nr. 980 626 180



Naustvika

Dato: 16-07-2019

Målestokk: 1:1 000



NHdigi.no



Situasjonskart -

*Utførelsesledning
 124 / 24,2509 26*

+ N6743398, 0283906