


Kjell Eikemo, Skauvegen 219. 5957 Myking

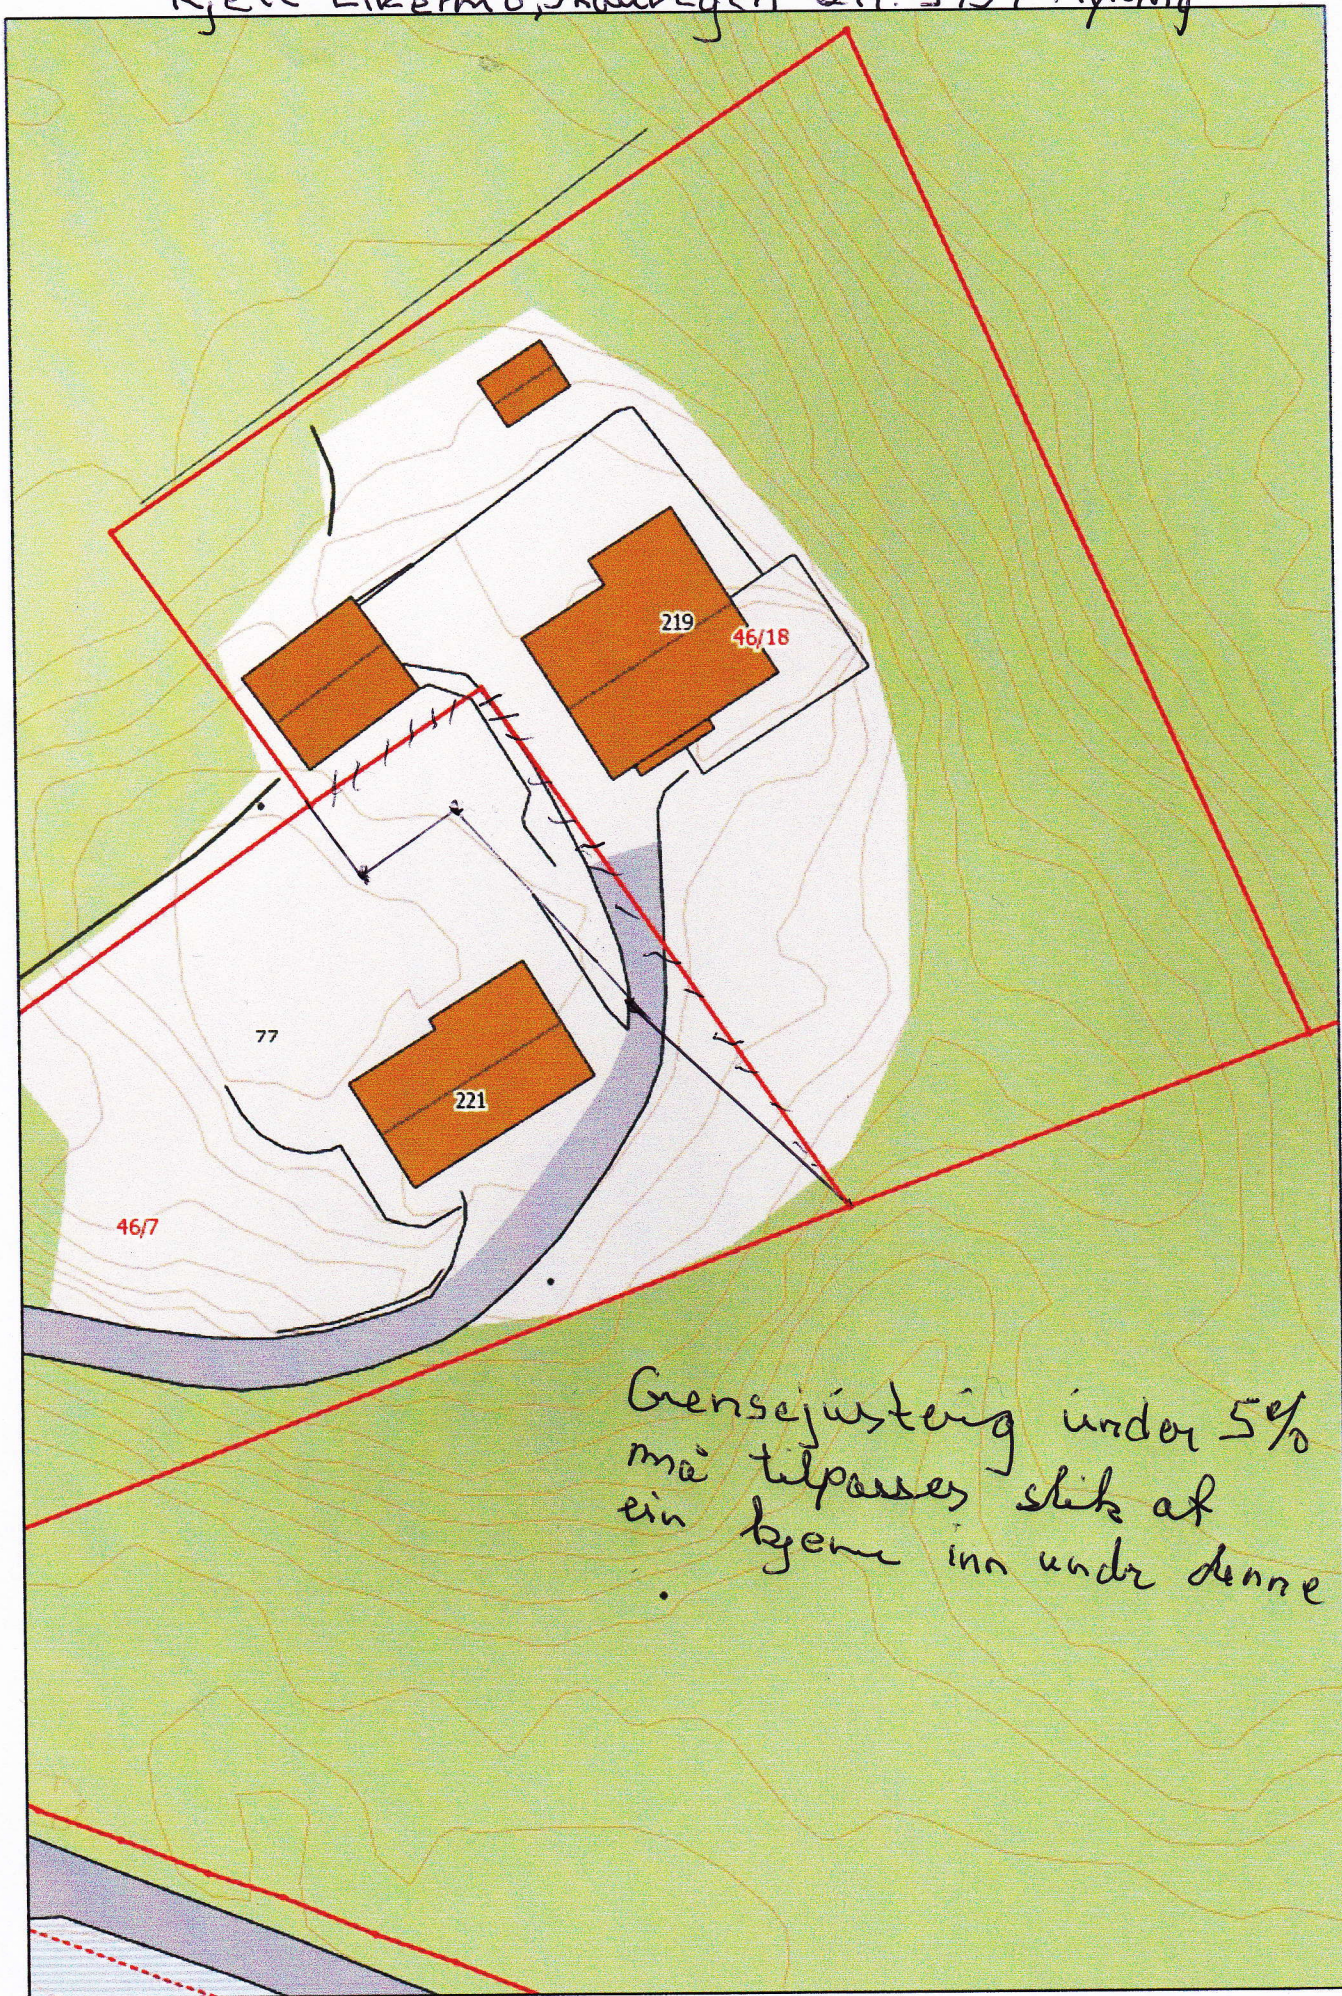

Grensejustering under 5%  
må tilpasses slik at  
ein bygn inn under denne %.