

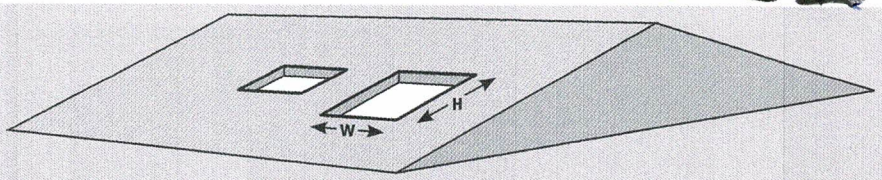


E-1-1


1

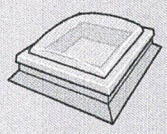

CXP	W mm	H mm
090120	900-910	1200-1210
100100	1000-1010	1000-1010
120120	1200-1210	1200-1210

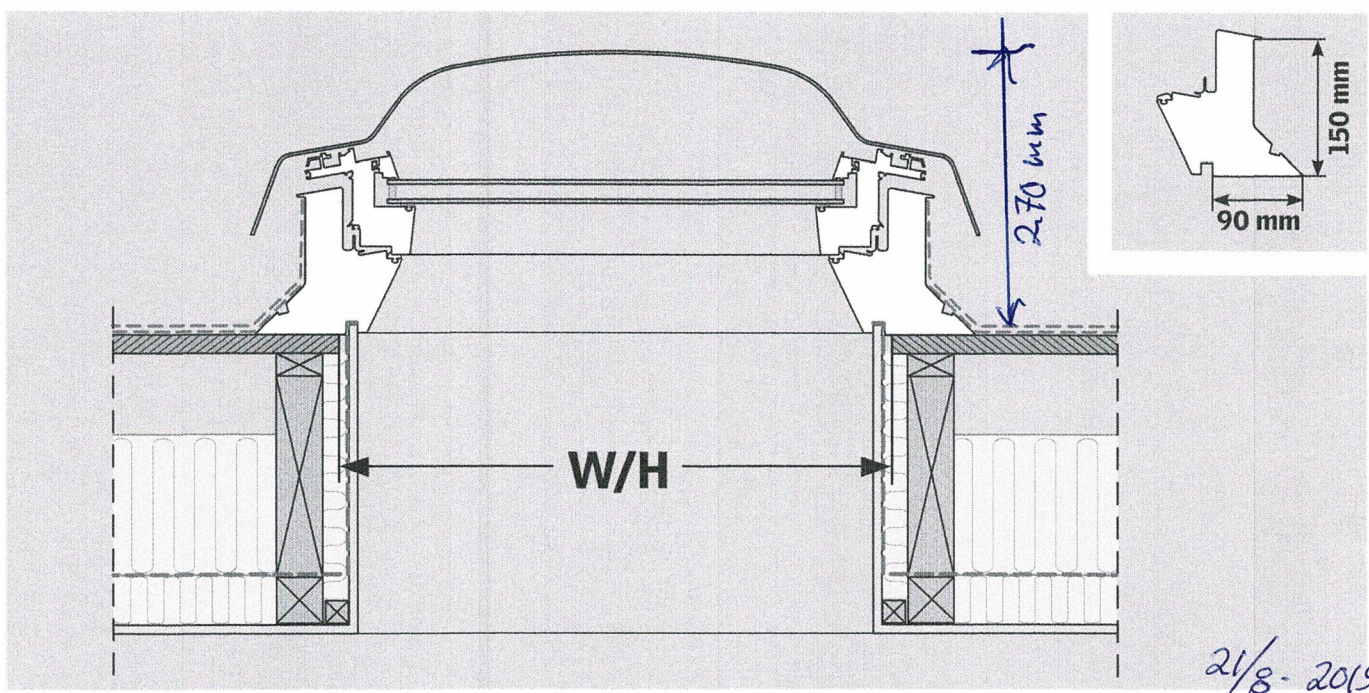

2/8-2019

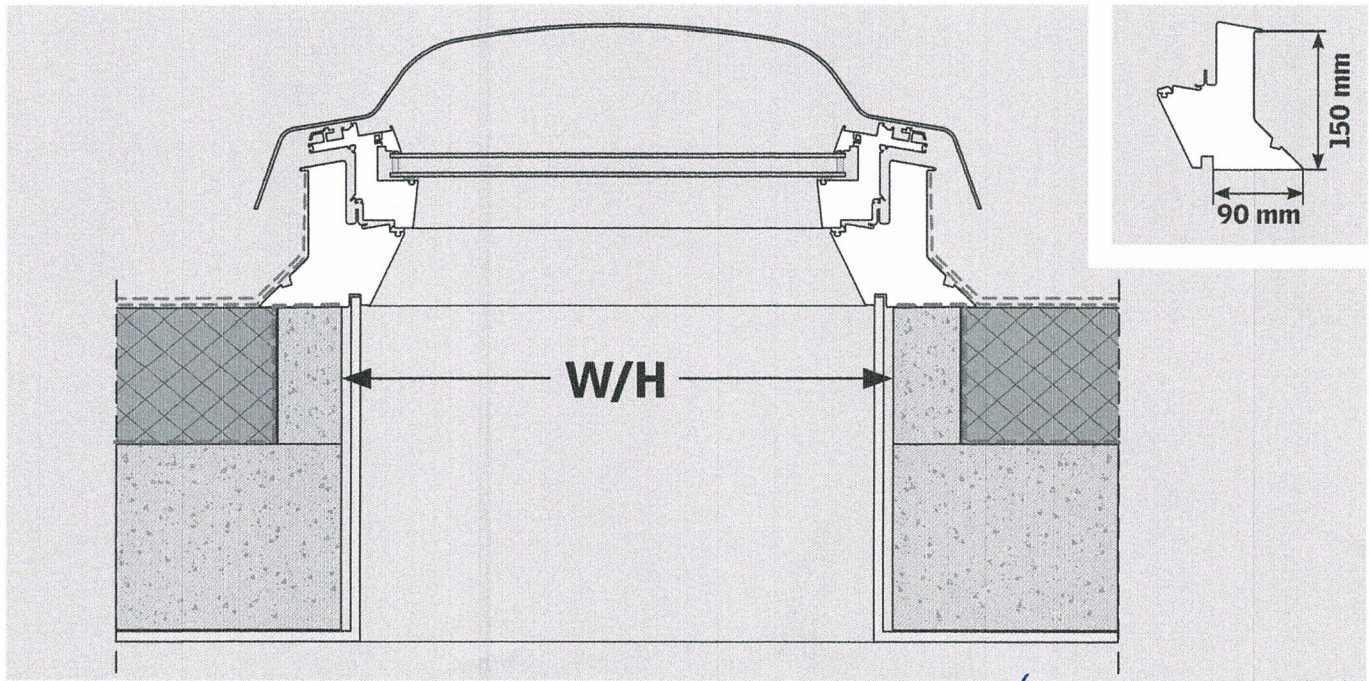

- Návad 10 x 16  
 - Ny - 9 x 12 7/8 kuppel

ER-1 av 5

UTSIKT FRA SPISESTUE




E - 2 av 5

UTSIKT FRA KJØKKEN



€ 3-5

UTSIK FRA STUE SOM VISER DAGENS LINDU

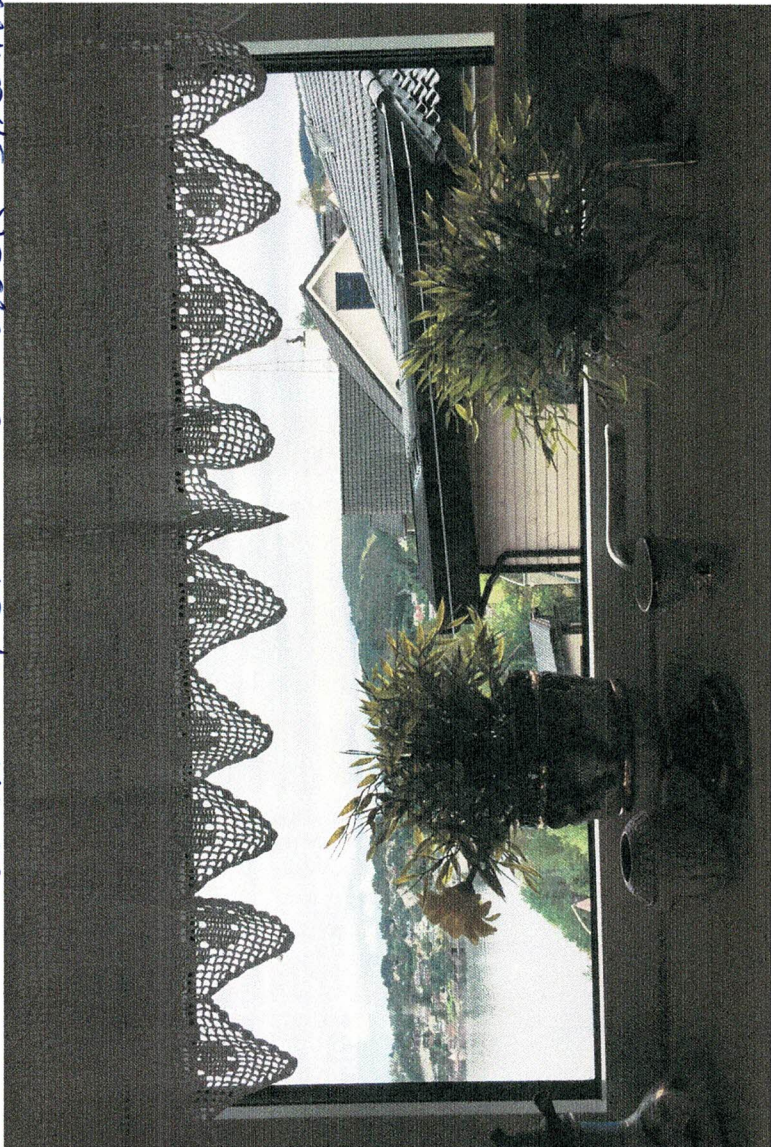

E 4-5

UTSIKT FRA STUE, NYTT HORNØY VINDU



5-5  
0

Hjörke vindu

