




# Alversund Maskinstasjon A.S

23.10.2019

Til  
Stendal VVS

Her er innmålingsdata for punktene

Id	Øst	Nord	Høyde	S_OBJID		
1	284057,741	6743681,677	24,977	stk-b124-g26.1		
2	284057,343	6743681,711	24,942	stk-b124-g25.1		
3	284056,629	6743681,008	25,063	stk-b124-g24.1		
4	284057,402	6743681,29	24,789	stakekum1		
5	284060,92	6743678,323	23,835	kammer2-3		
6	284060,656	6743679,503	23,887	slamavskiller1		

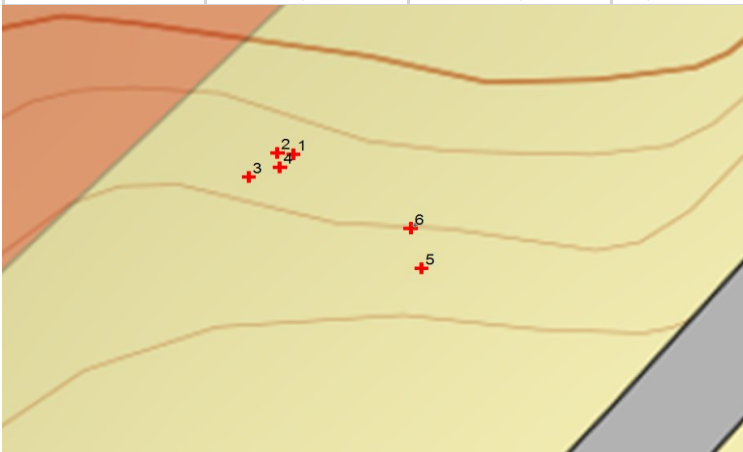

Mvh  
Marianne Myking

Boring  
Sprenning  
Graving  
Transport

Veggrus  
Singel  
Oppretting  
Stein

Usortert jord  
Sortert jord



Telefon: 56 35 01 80  
E-post: alm-as@online.no  
Org.nr. 937 664 044 MVA

Mob: Steinar 918 52 510  
Ove 918 52 501  
Ronny 913 23 473