

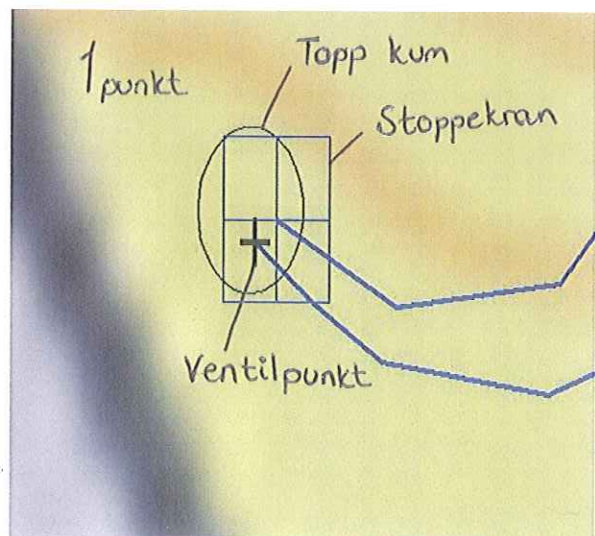


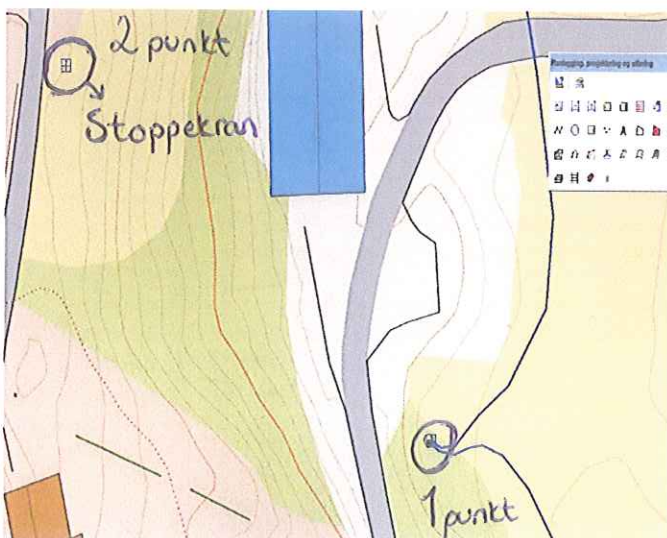

Alversund Maskinstasjon A.S

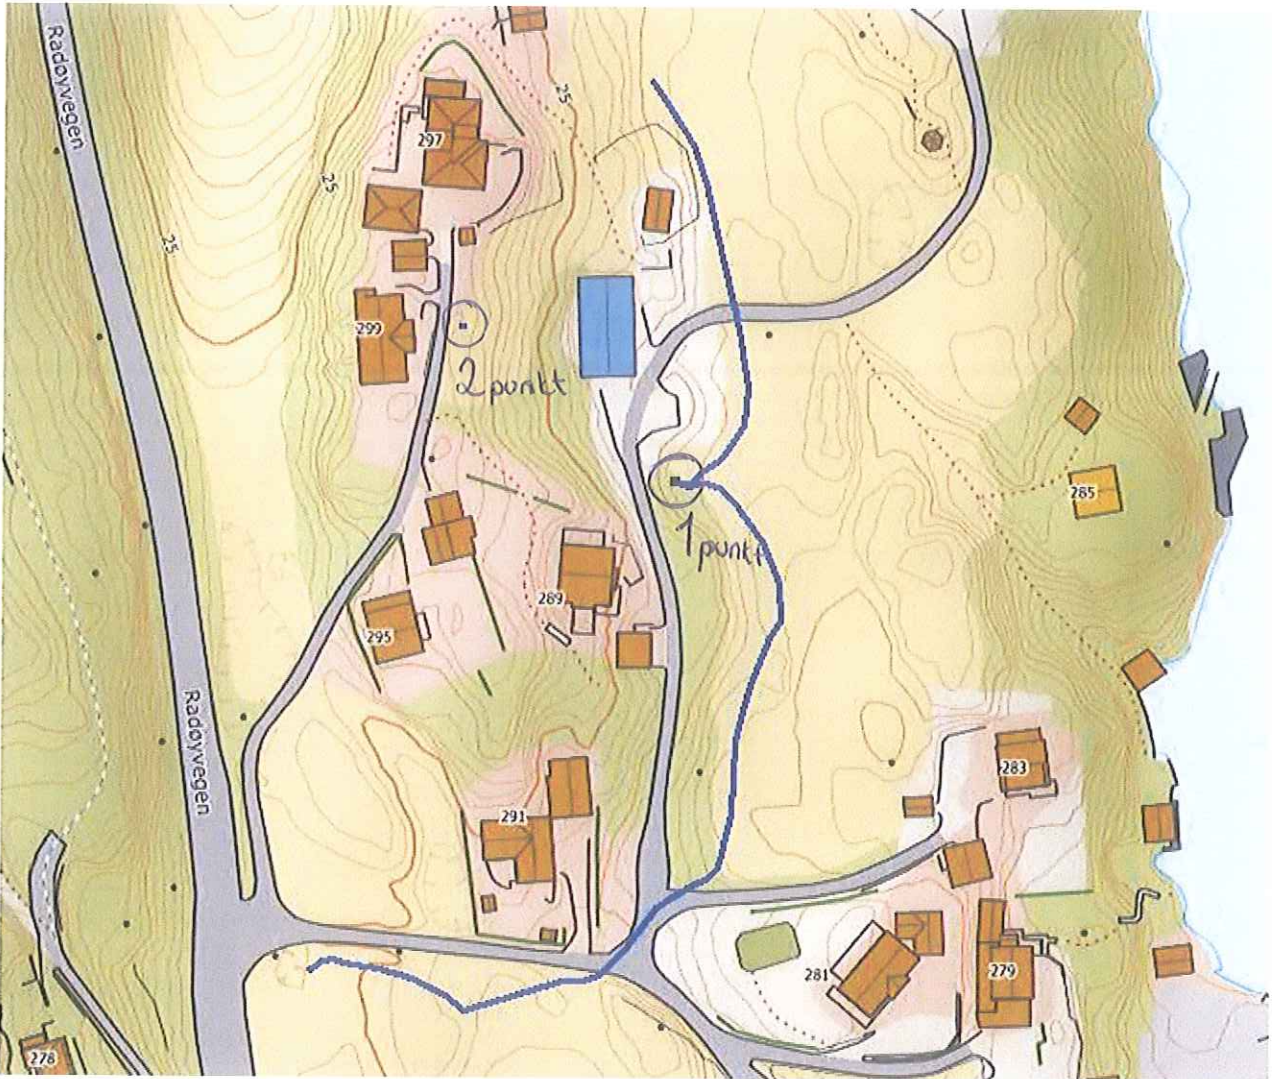

Boring
Sprenging
Graving
Transport

Veggrus
Singel
Oppretting
Stein

Usortert jord
Sortert jord



Telefon: 56 35 01 80
E-post: alm-as@online.no
Org.nr. 937 664 044 MVA

Mob: Steinar 918 52 510
Ove 918 52 501
Ronny 913 23 473