

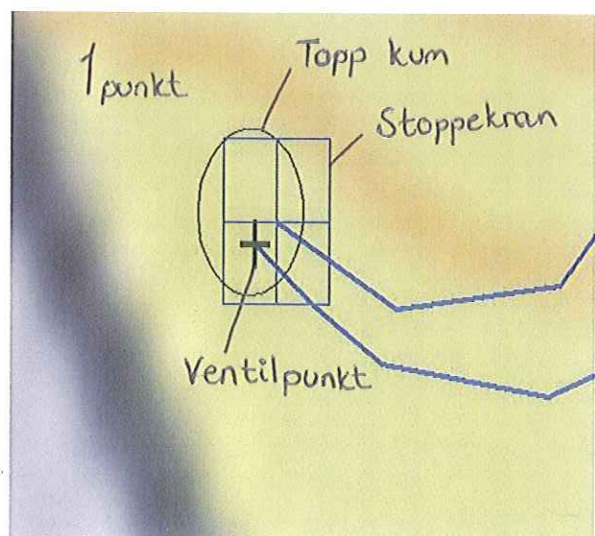


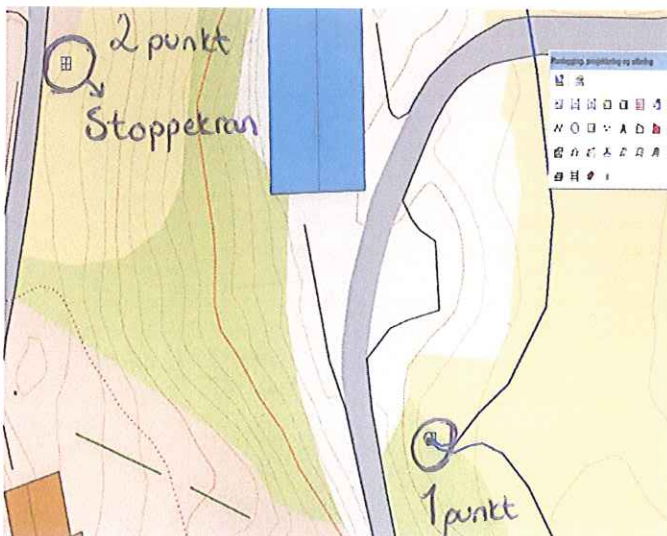

# Alversund Maskinstasjon A.S

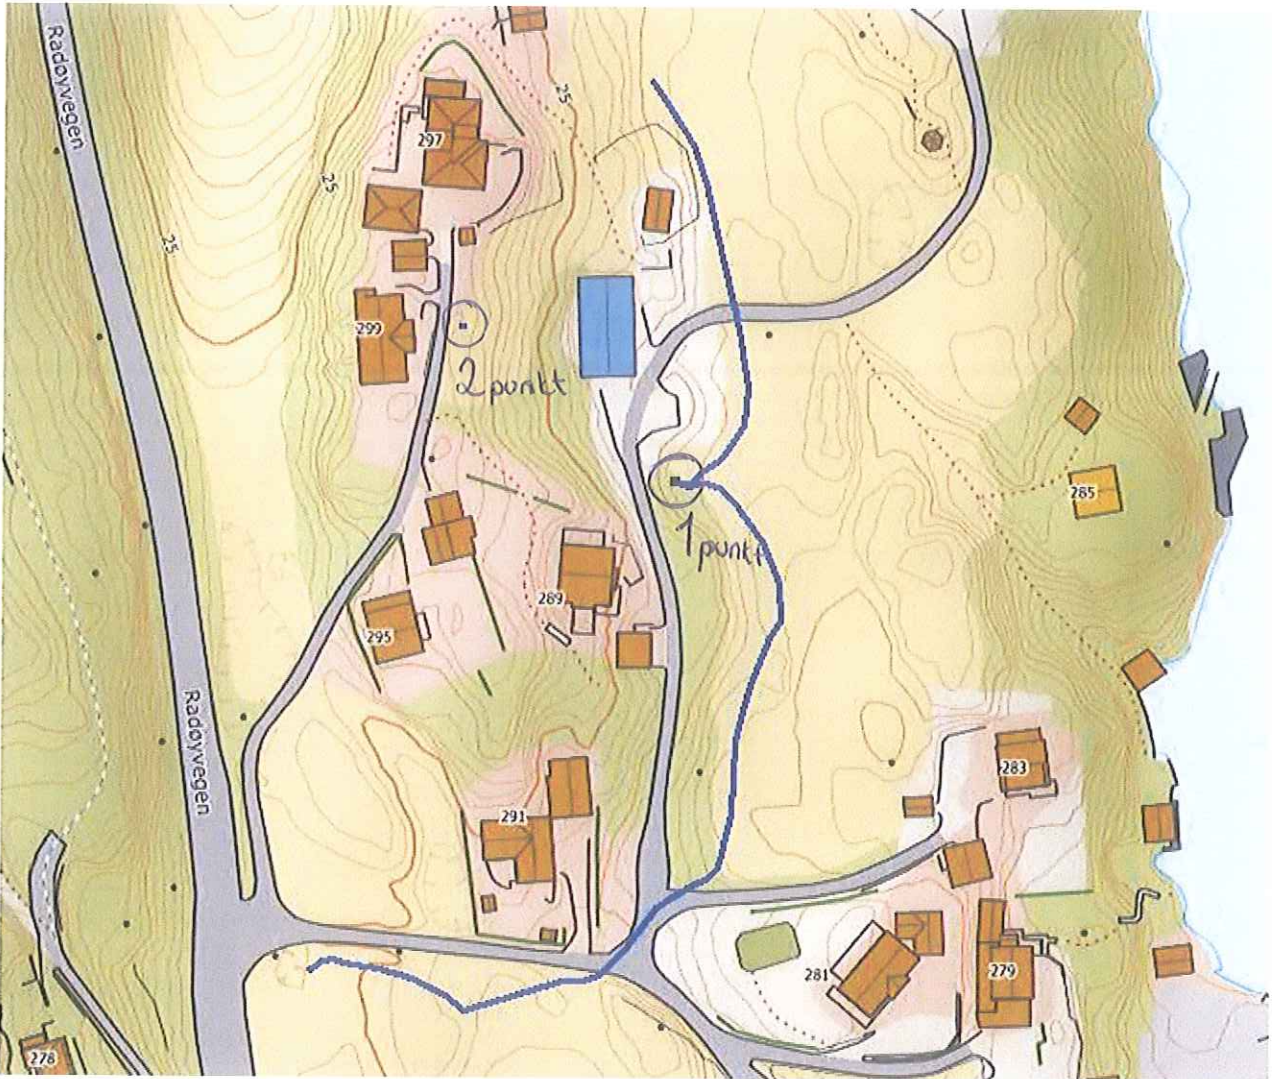

Boring  
Sprenging  
Graving  
Transport

Veggrus  
Singel  
Oppretting  
Stein

Usortert jord  
Sortert jord



Telefon: 56 35 01 80  
E-post: alm-as@online.no  
Org.nr. 937 664 044 MVA

Mob: Steinar 918 52 510  
Ove 918 52 501  
Ronny 913 23 473