
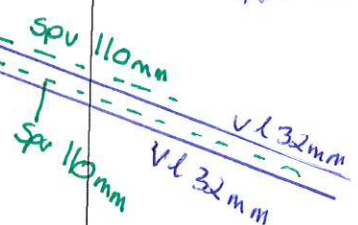


VL63
SP170
OV146

VL50
SP170
OV160

5a-f = 600mm
B

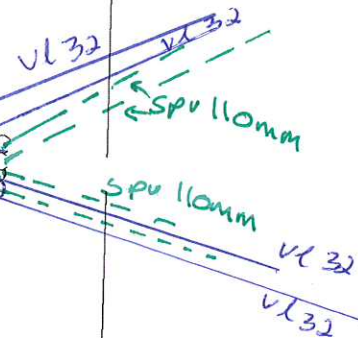

Gbnr 137/203
Innmått VA
28.11.2019
Målestokk 1:100
Medaas Oppmåling

