




Lindås, gnr 185 bnr 297,
Data på innmålt grunnmur

18.02.2019

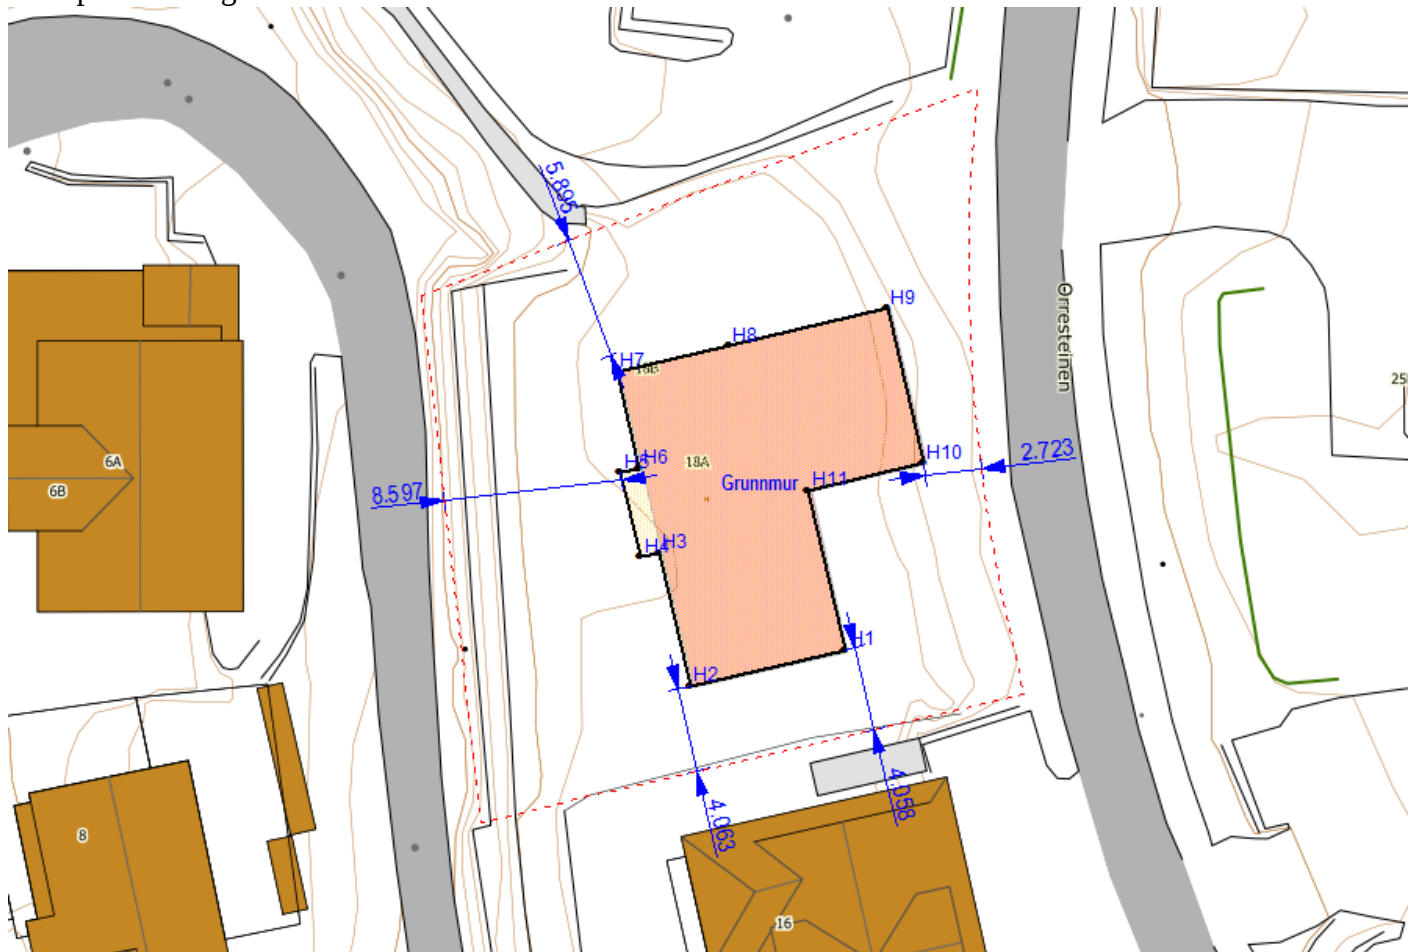

PunktID	N-koord.	Ø-koord.	Høyde
H1	6718933,18	295780,68	
H2	6718931,42	295773,18	66,71
H3	6718937,84	295771,68	66,70
H4	6718937,64	295770,80	66,70
H5	6718941,71	295769,83	66,69
H6	6718941,93	295770,71	66,70
H7	6718946,58	295769,62	66,70
H8	6718947,86	295775,07	66,70
H9	6718949,64	295782,66	
H10	6718942,18	295784,42	
H11	6718940,87	295778,87	