


Lindås, gnr 102 bnr 130, Vabø
Data på innmålt fasadeliv

08.04.2014

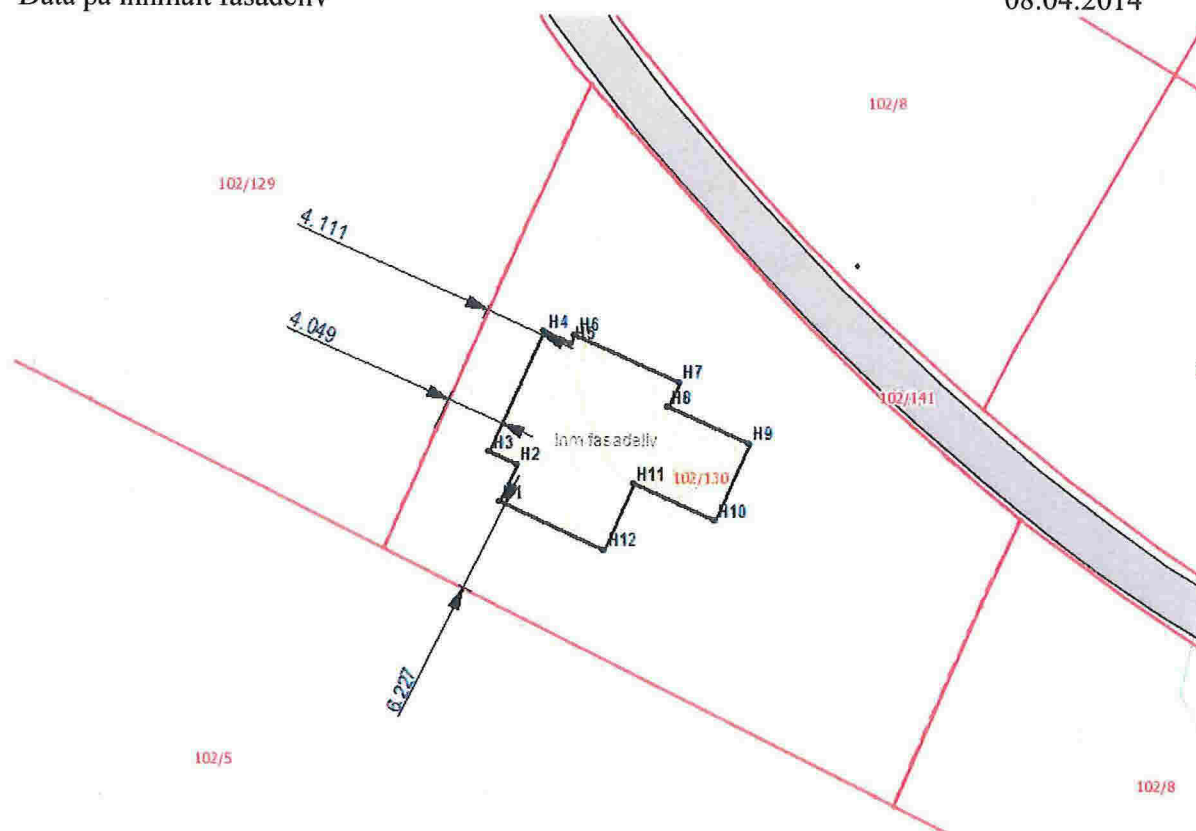

PunktID	N-koord.	Ø-koord.
H1	6740170,31	294359,86
H2	6740172,87	294360,99
H3	6740173,68	294359,17
H4	6740181,71	294362,74
H5	6740180,90	294364,56
H6	6740181,49	294364,83
H7	6740178,35	294371,90
H8	6740176,71	294371,17
H9	6740174,27	294376,65
H10	6740169,12	294374,36
H11	6740171,56	294368,88
H12	6740167,17	294366,93

Høyde topp grunnmur: kote +24,77