


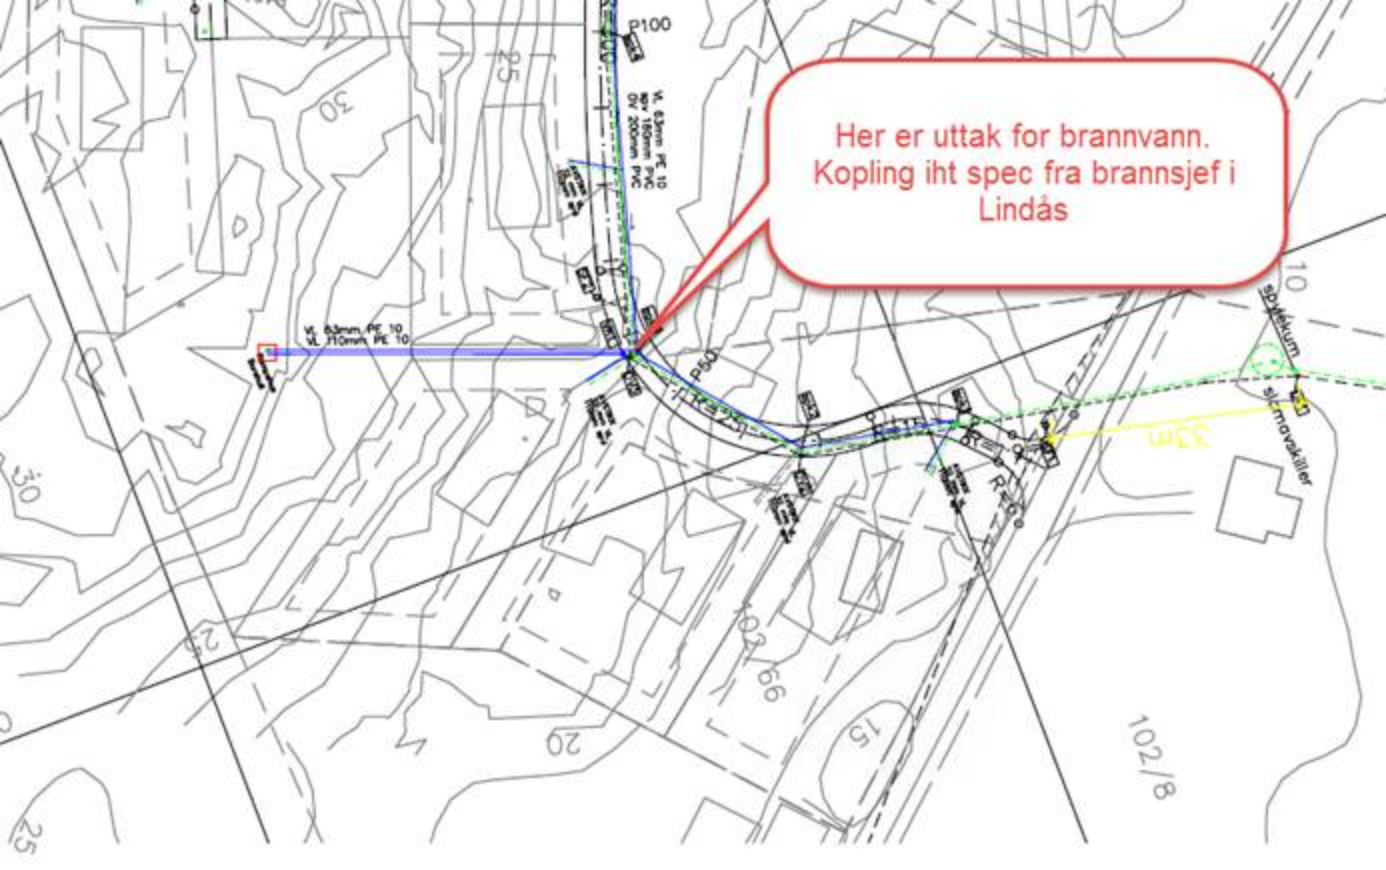

Her er uttak for brannvann.
Kopling iht spec fra brannsjef i
Lindås

The diagram shows a topographic map with contour lines and building outlines. A blue line represents the fire water supply system, starting from a source on the left and branching out to several points. A red speech bubble points to a specific connection point. A yellow line indicates a distance of 33m to a building labeled 'Skolekuller'. Various technical specifications for pipes and valves are noted along the lines.

V. 63mm PE 10
VL 110mm PE 10

P100
V. 63mm PE 10
NPT 160mm PVC
DN 200mm PVC

P50

33m


102/8