




Lindås, gnr 107 bnr 11,
Data på innmålt grunnmur

23.05.2013

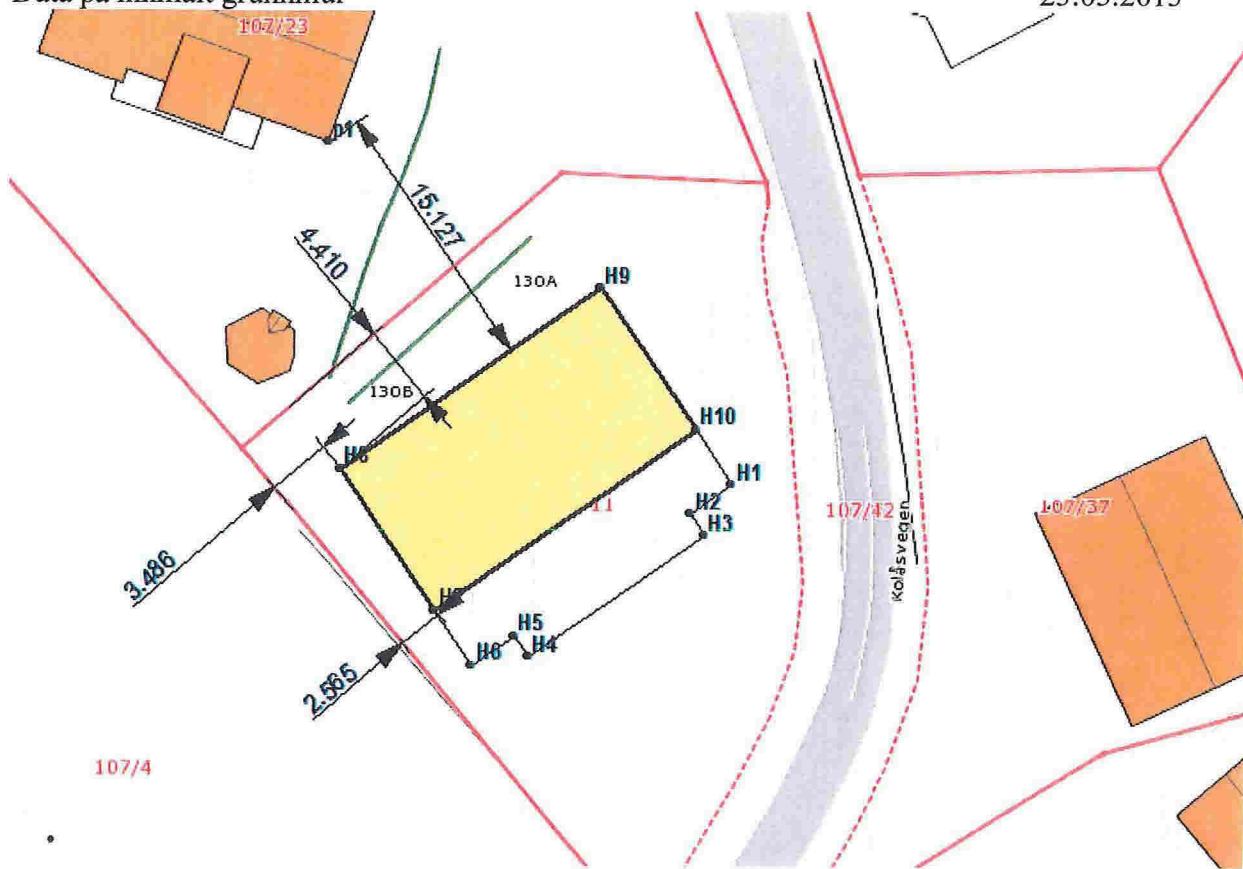

PunktID	N-koord.	Ø-koord.	Høyde
H1	6740769,44	290636,74	127,04
H2	6740767,86	290634,42	127,03
H3	6740766,71	290635,21	127,01
H4	6740760,05	290625,53	127,00
H5	6740761,18	290624,77	127,03
H6	6740759,59	290622,45	127,03
H7	6740762,58	290620,36	129,62
H8	6740770,33	290615,03	129,63
H9	6740780,21	290629,35	129,61
H10	6740772,49	290634,69	129,61