


8 7 6 5 4

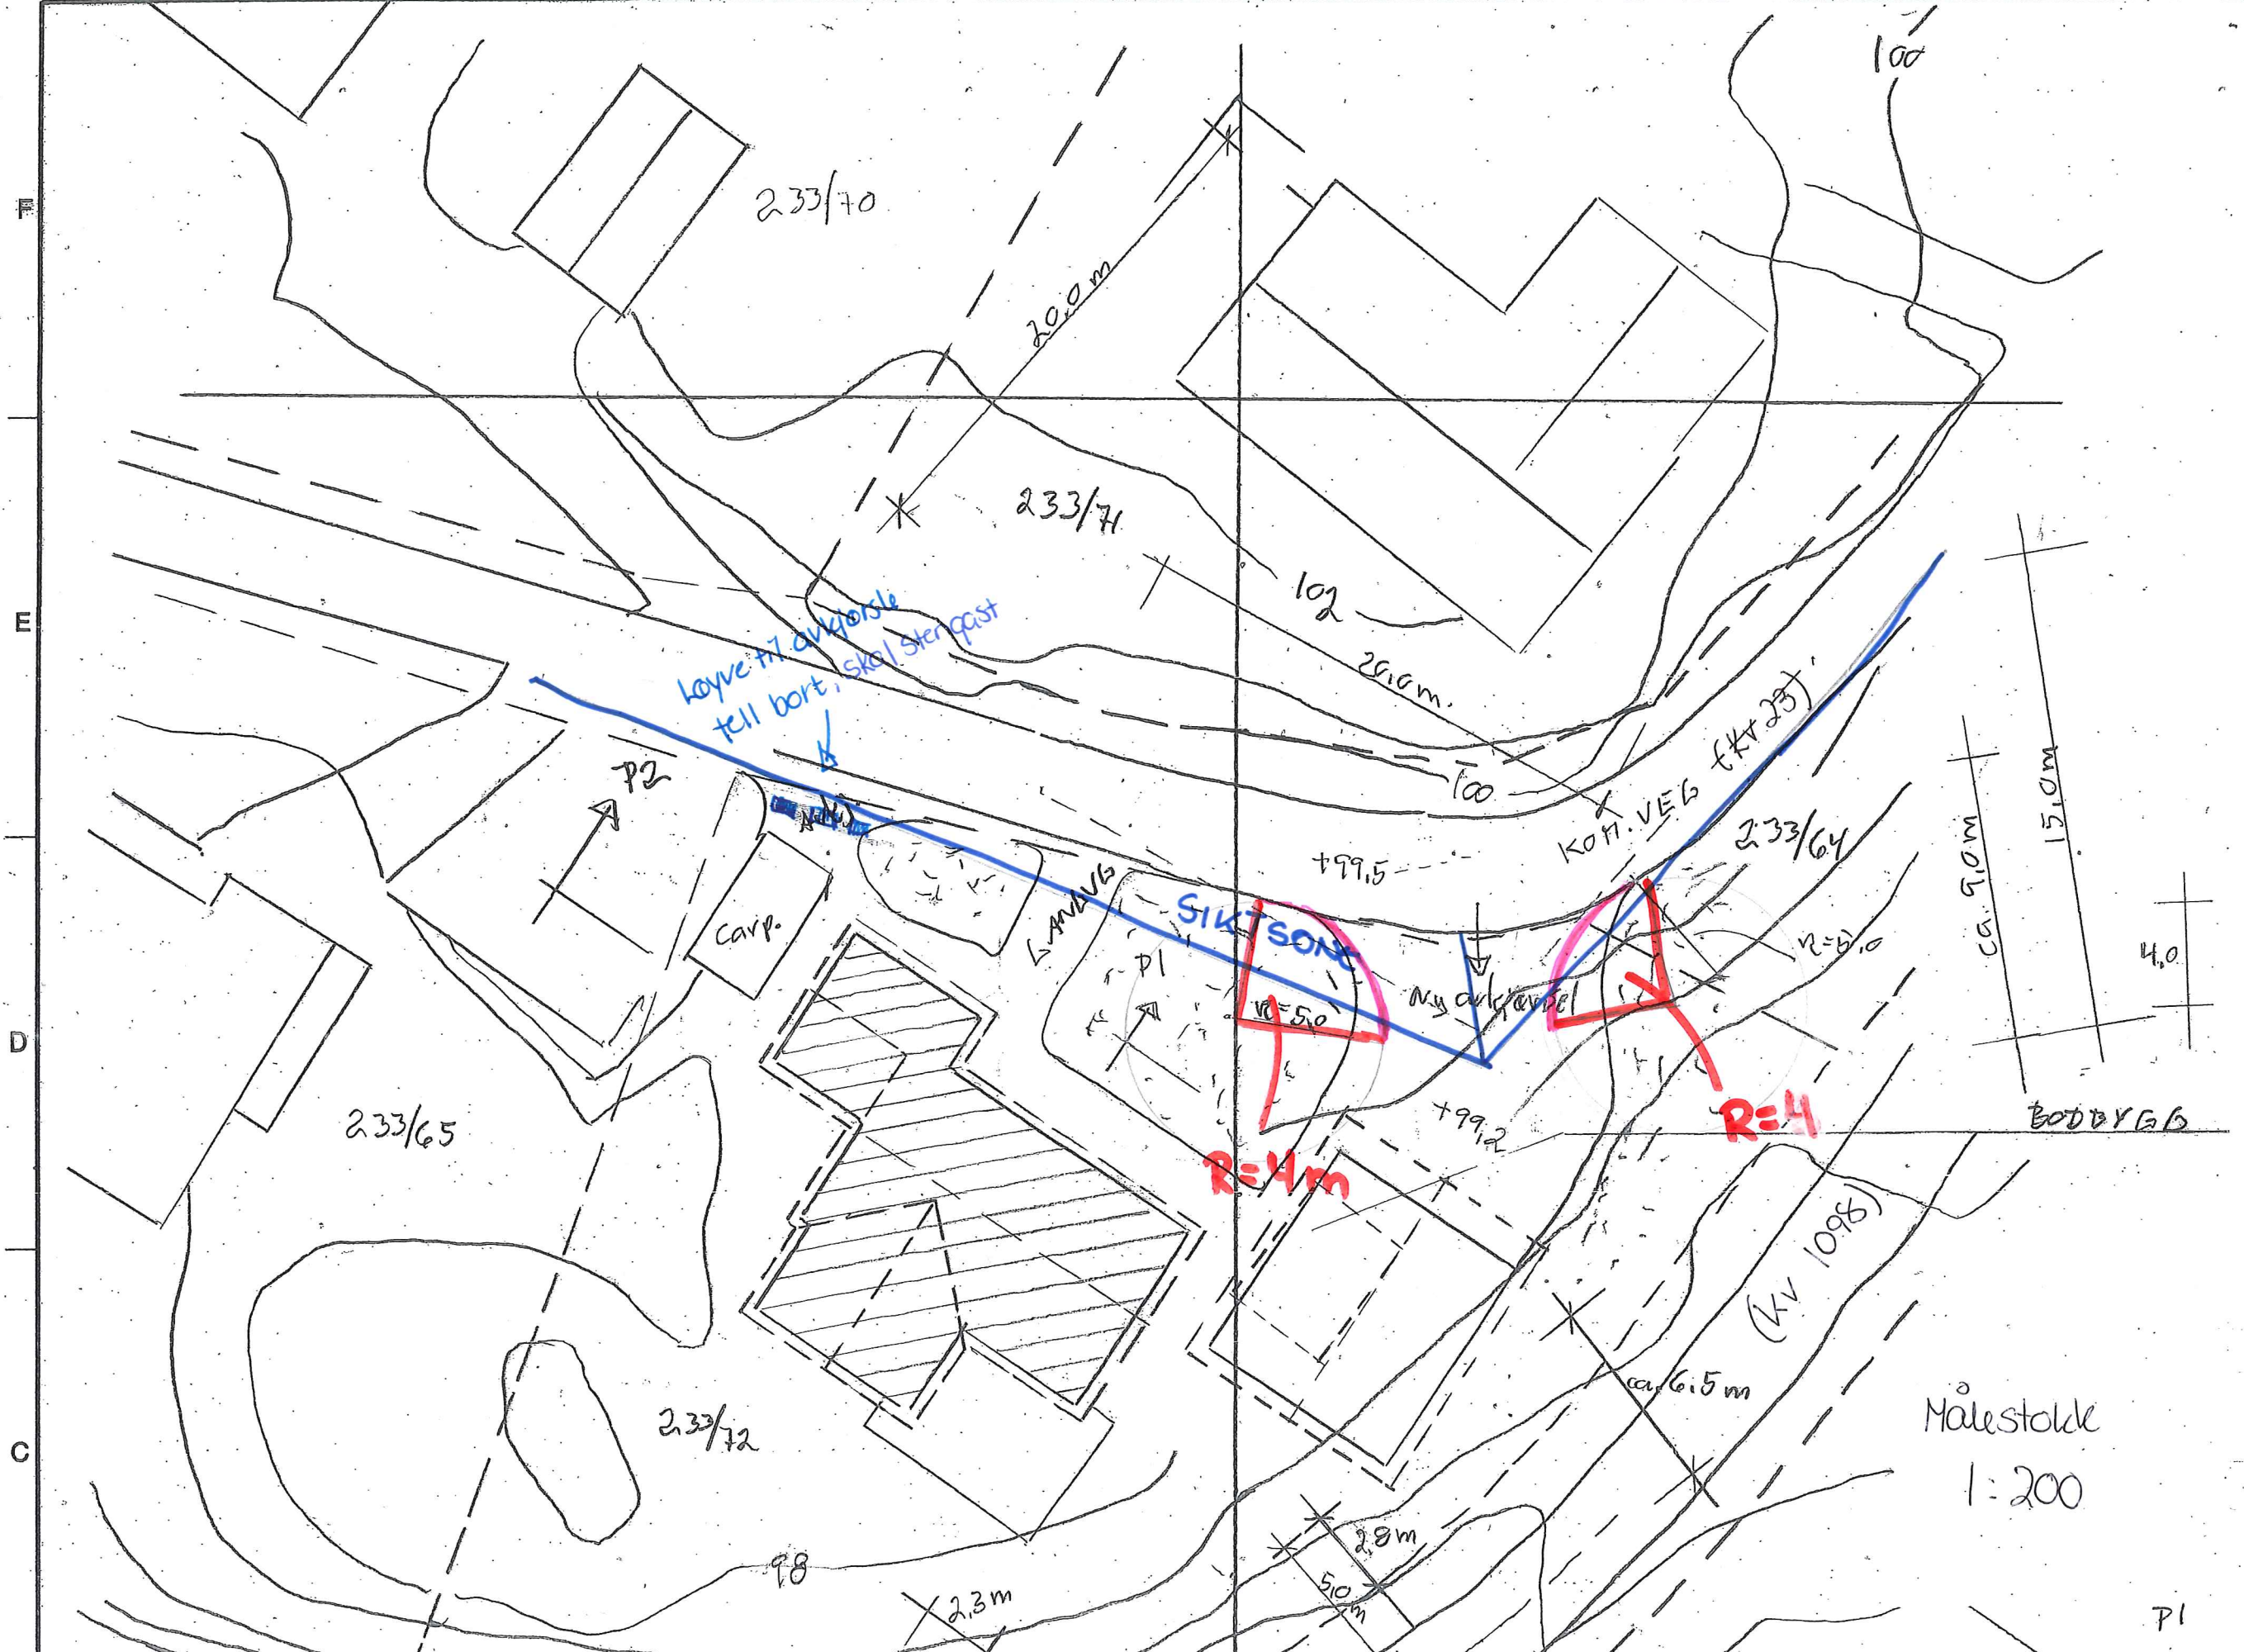

Målestokk 1:200

PI