




Fasade mot øst

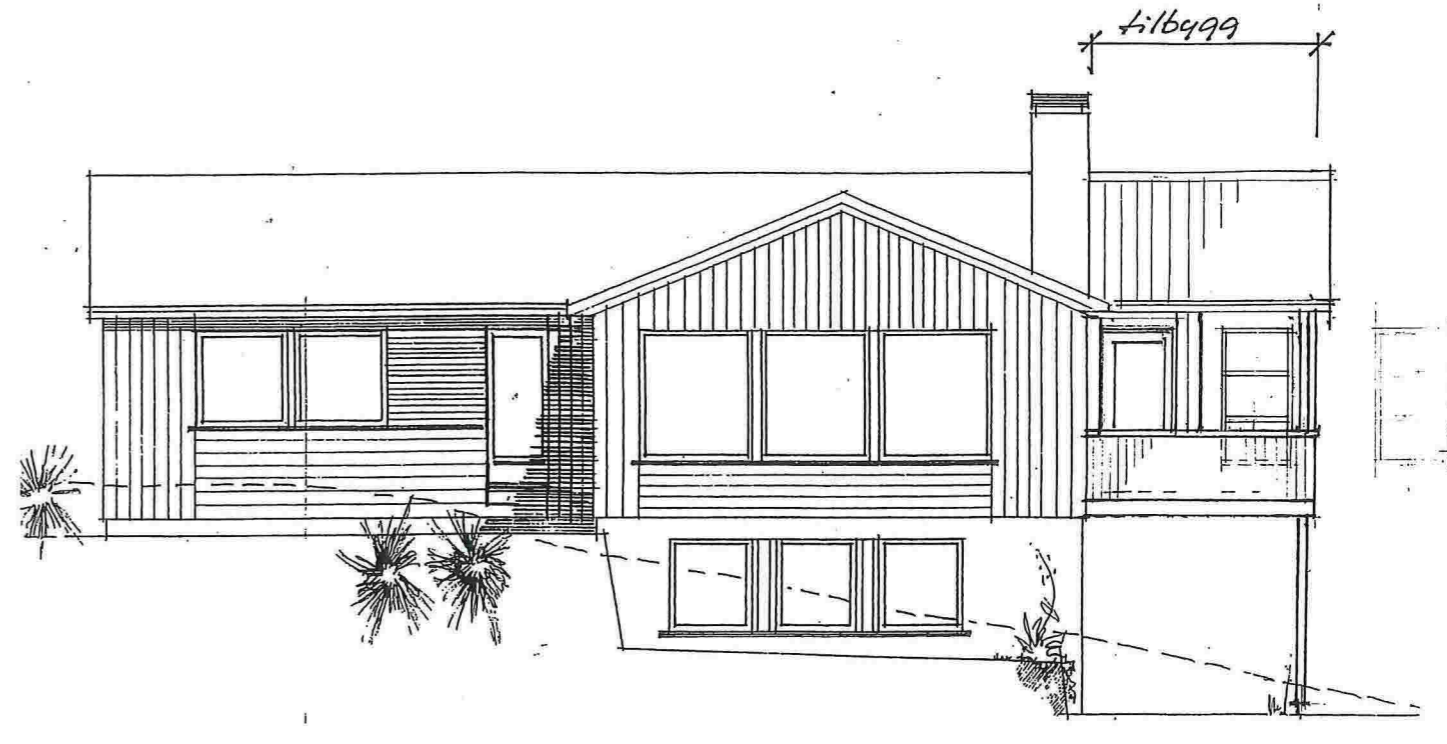

Fasade mot syd

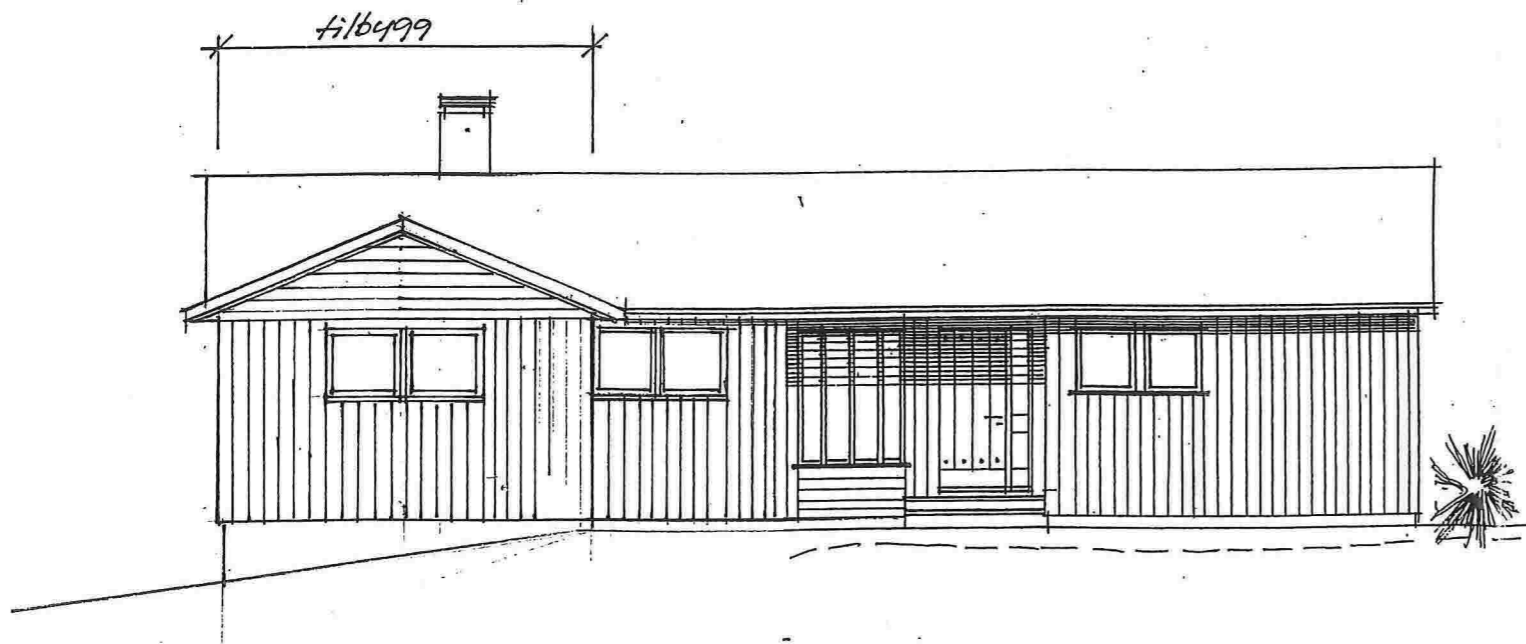


Fasade mot nord

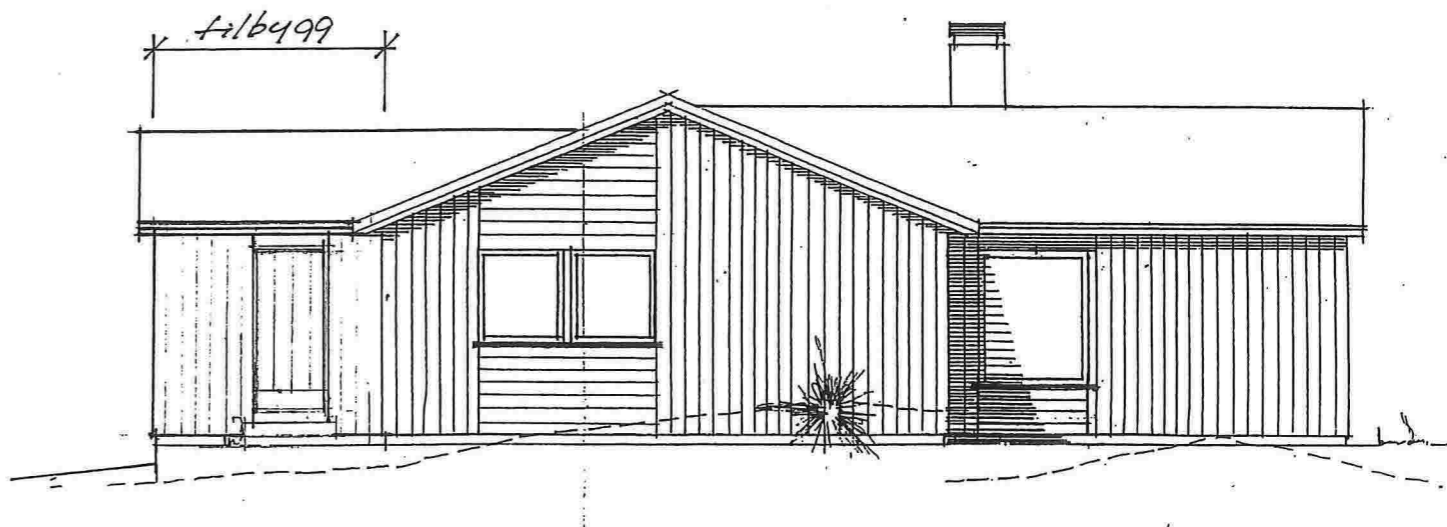

Fasade mot vest

Kåre Hellem gnr 195 bnr 54 på Leiknes, Lindås Kommune
 Tilbygg / fasadeendring, fasader 1:100
 Tsdalstø 28.01.2015

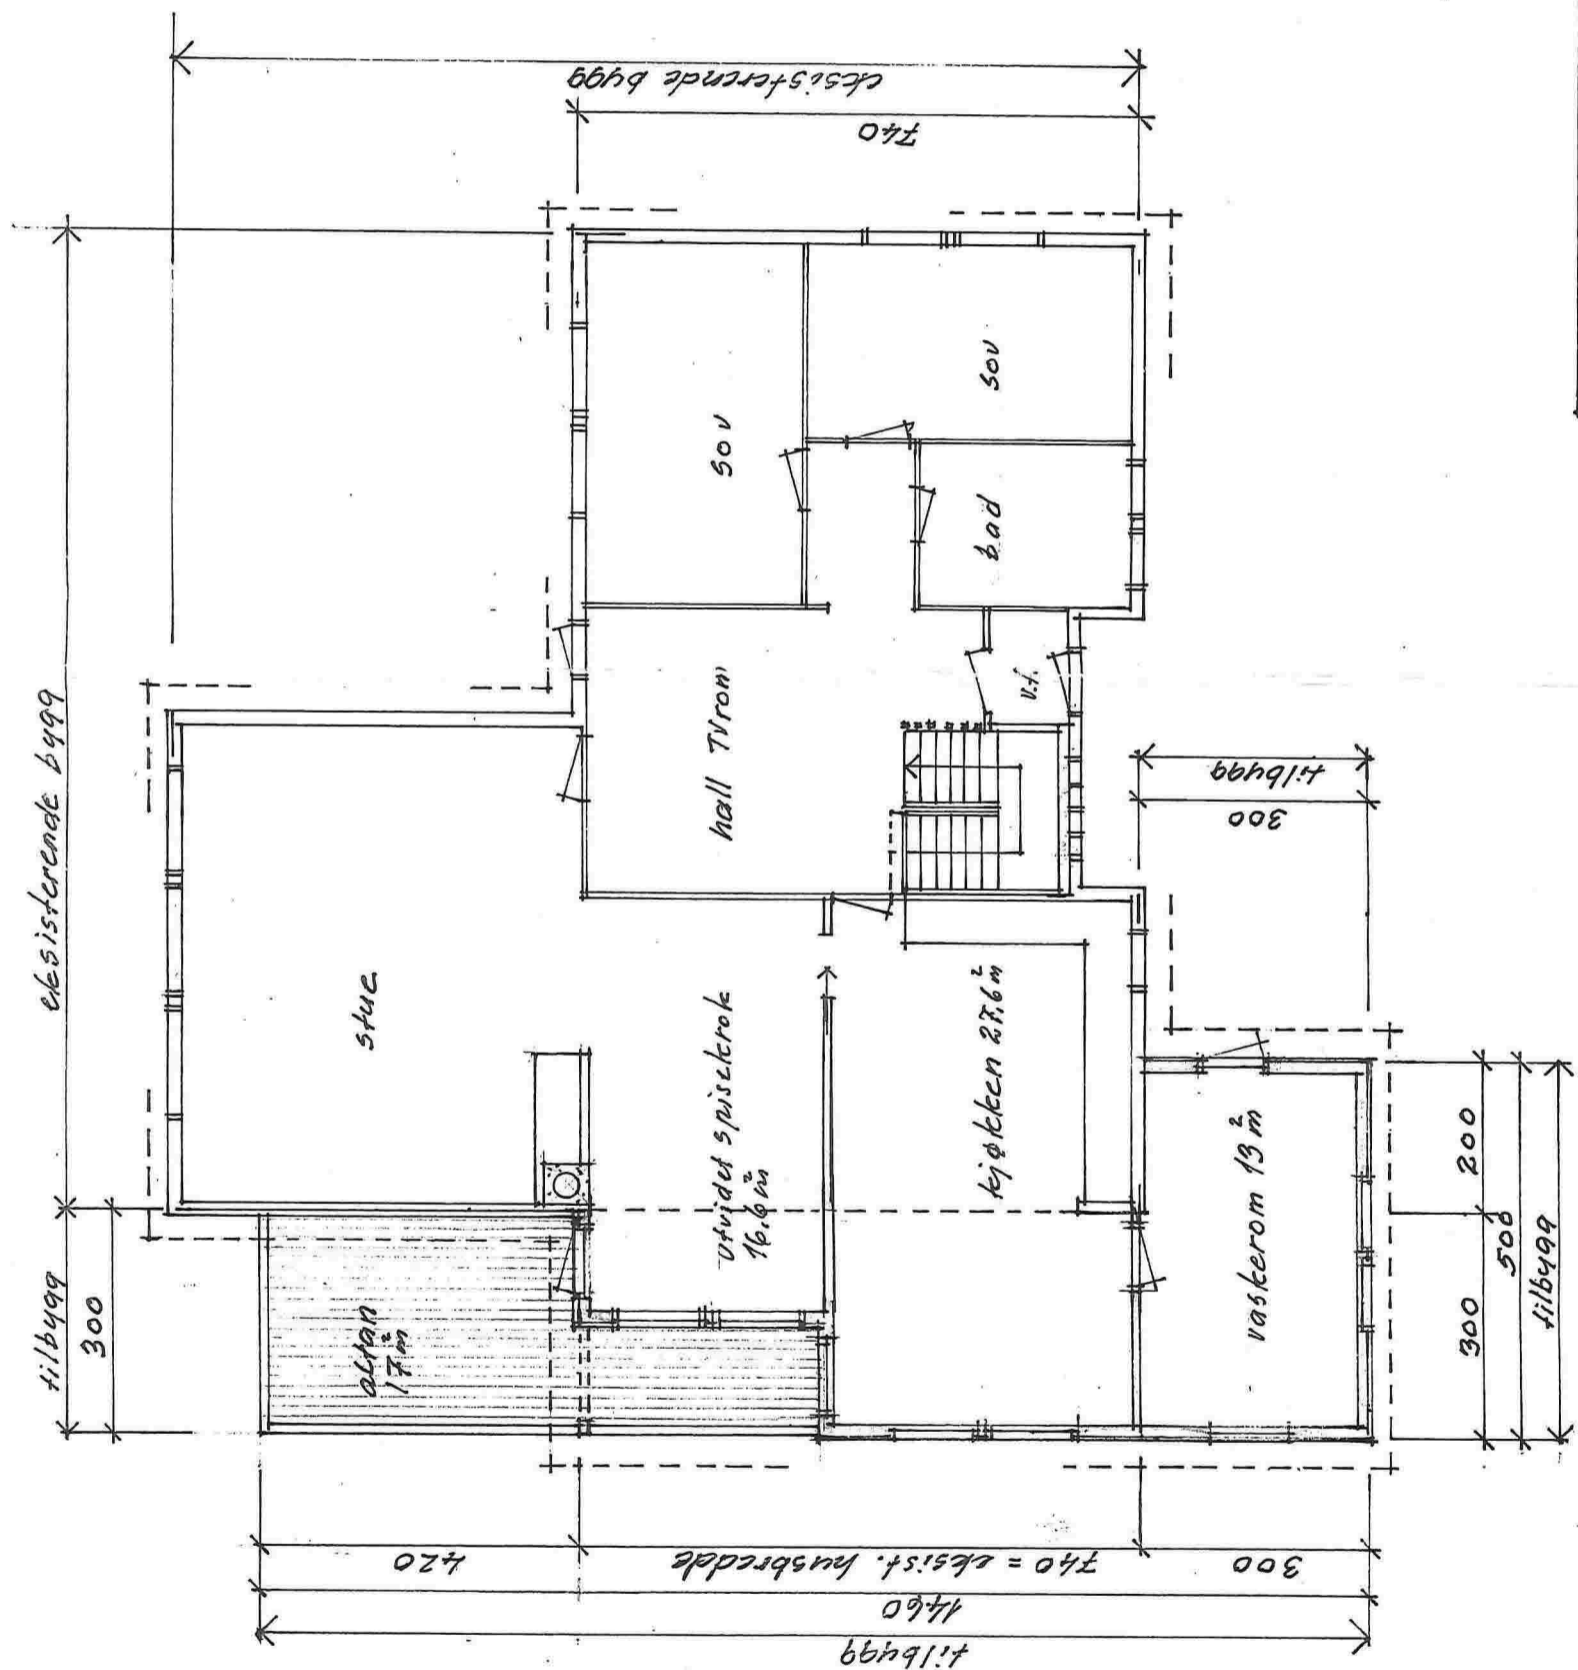

Kåre Hellem gnr 195, bnr 54 på Leiknes
 Tilbygg / fasadeendring, Plan 1. etasje 1:100
 Tsdalstø, 28.01.2015