



TERRENG H.	109.88	107.79	104.84	104.56	104.32	100.44	96.77	92.60	88.71	84.70	77.95		
------------	--------	--------	--------	--------	--------	--------	-------	-------	-------	-------	-------	--	--

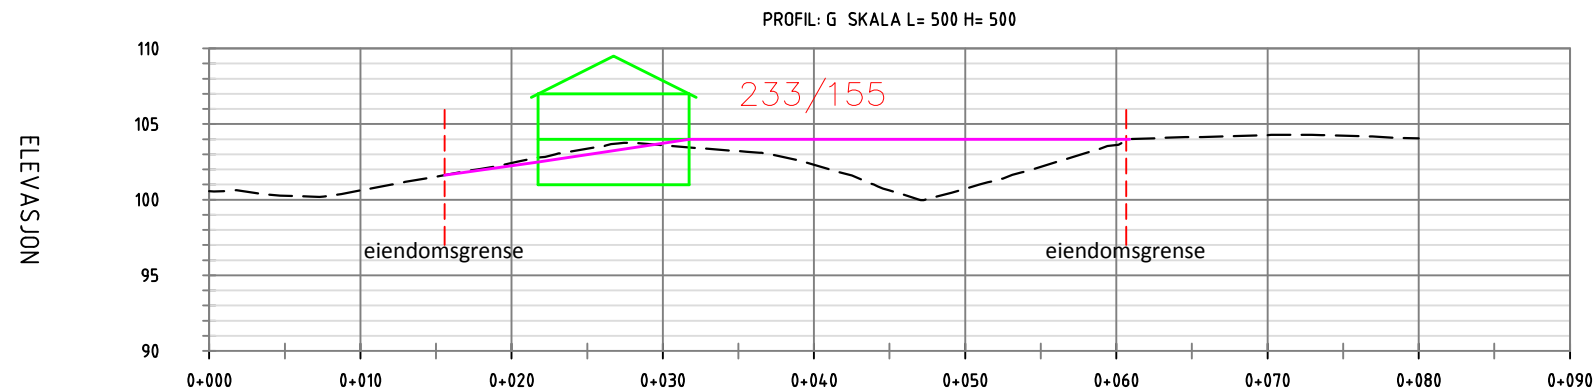

TERRENG H.	100.56	100.26	100.61	101.51	102.43	103.36	103.59	103.21	102.31	100.62	100.72	102.18	103.62	104.14	104.28	104.24	104.05		
------------	--------	--------	--------	--------	--------	--------	--------	--------	--------	--------	--------	--------	--------	--------	--------	--------	--------	--	--

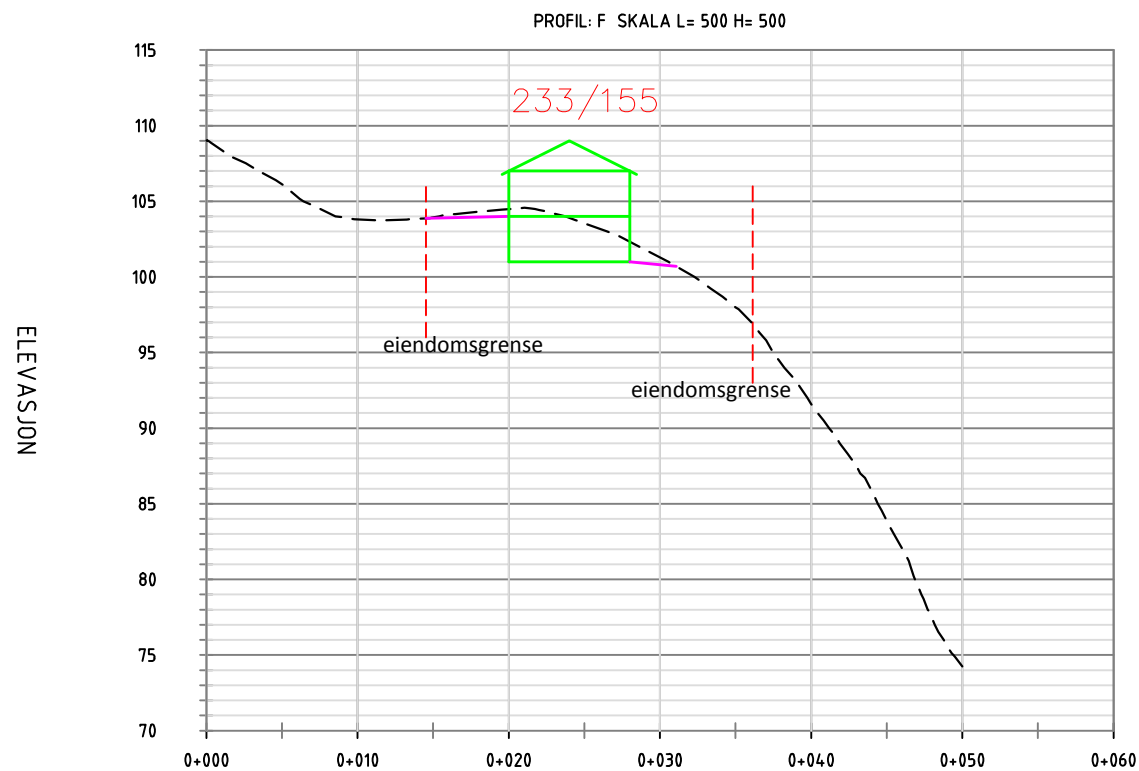

TERRENG H.	109.01	106.13	103.80	103.93	104.49	103.54	101.29	98.00	91.59	83.87	74.25		
------------	--------	--------	--------	--------	--------	--------	--------	-------	-------	-------	-------	--	--

Revisjon	Revisjonen gjelder	Utarb	Kontr	Godkjent	Rev. dato
A	Husplassering, endret foreslått terreng	PMO	GBA	KHJ	13-03-2015
A/STAB					
Fylling Dyrhovden Fyllingsplan E, F, G Tiltakshaver: Vestafjell AS		Produsert av A/STAB AS			
		Tegningsdato		13.01.2015	
		Målestokk		A3 1:500	
Utarbeidet av	Kontrollert av	Godkjent av	Konsulentarkiv	Tegningsnummer / revisjonsbokstav	
PNO	GBA	GBA	100174	04	-