




FASADE. NOT

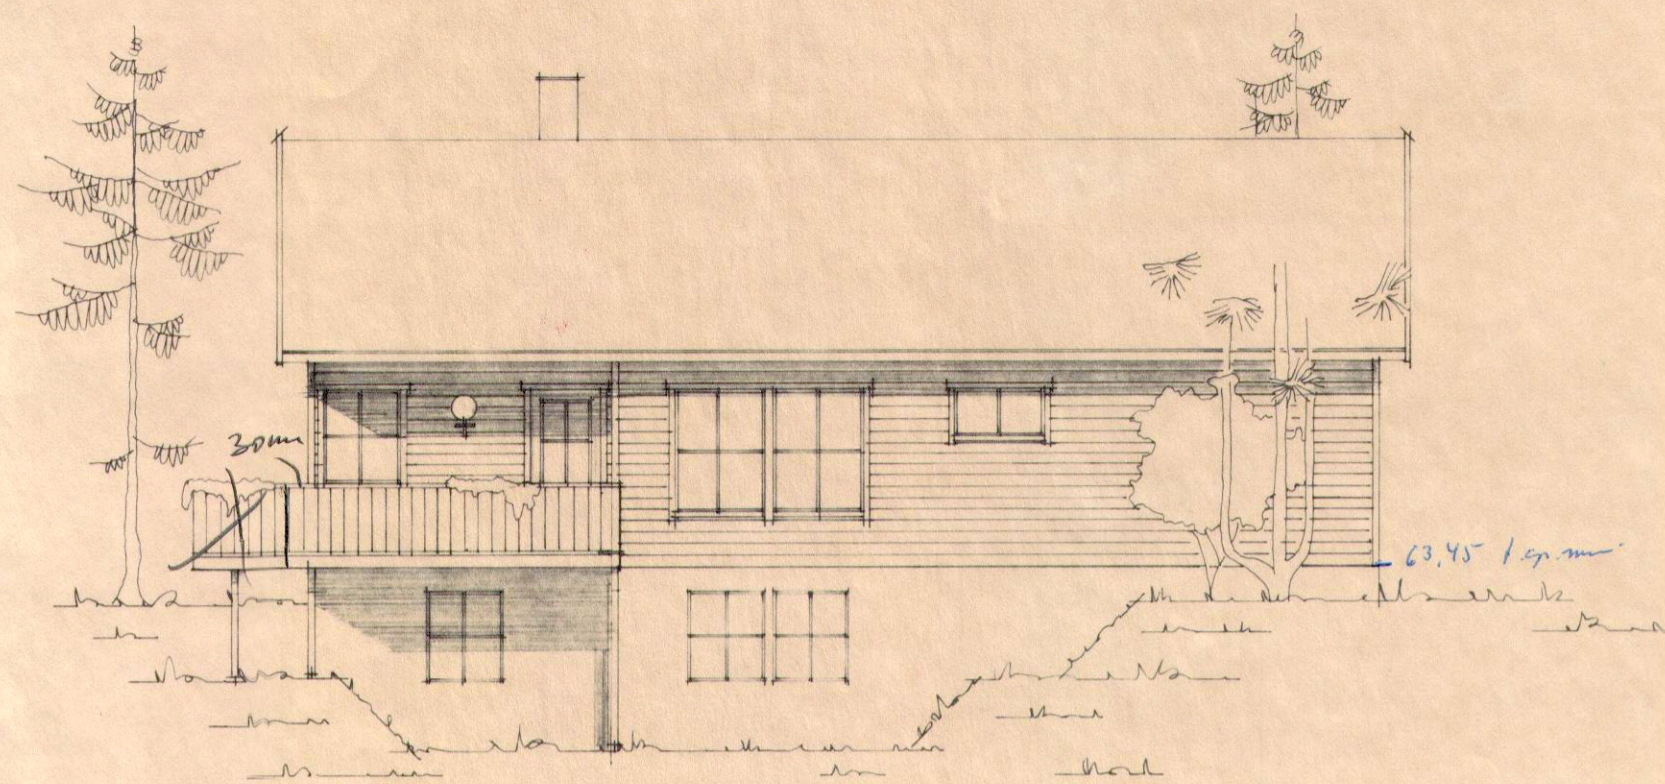

FASADE. NOT

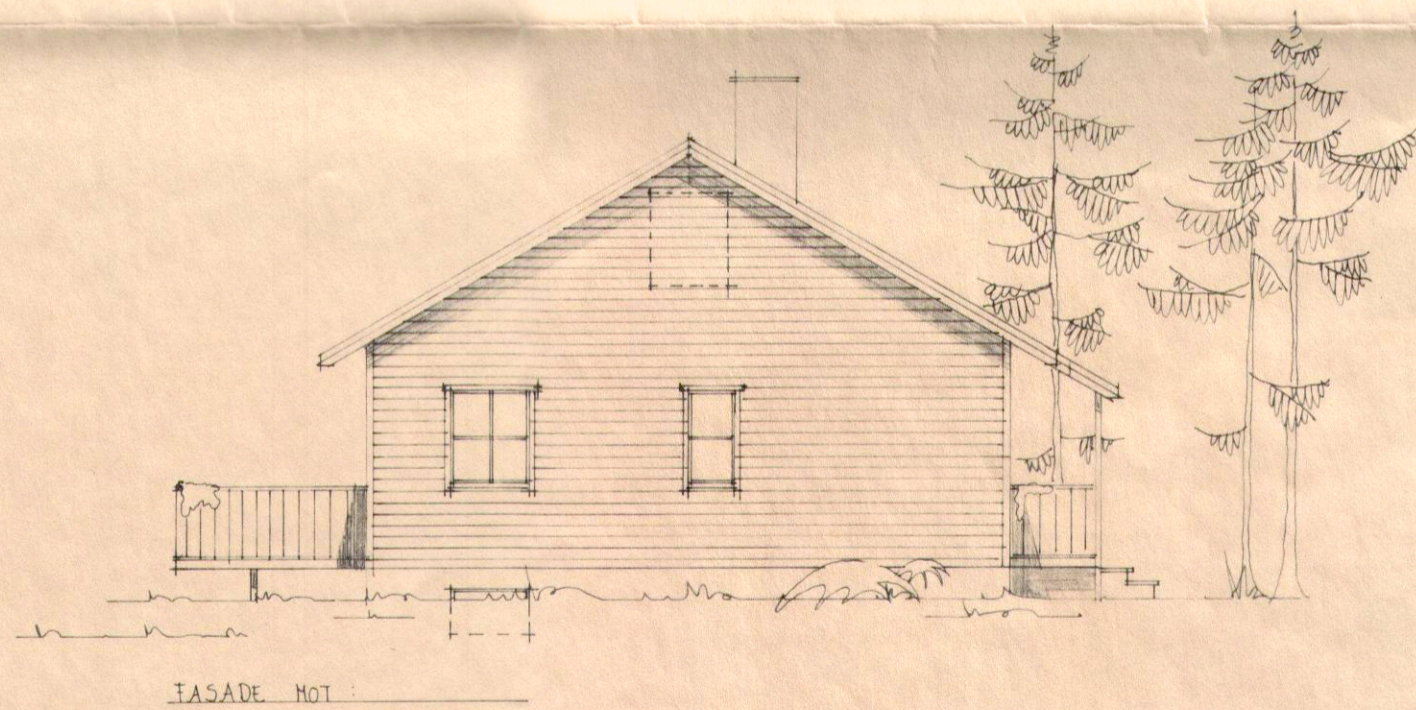

FASADE. NOT

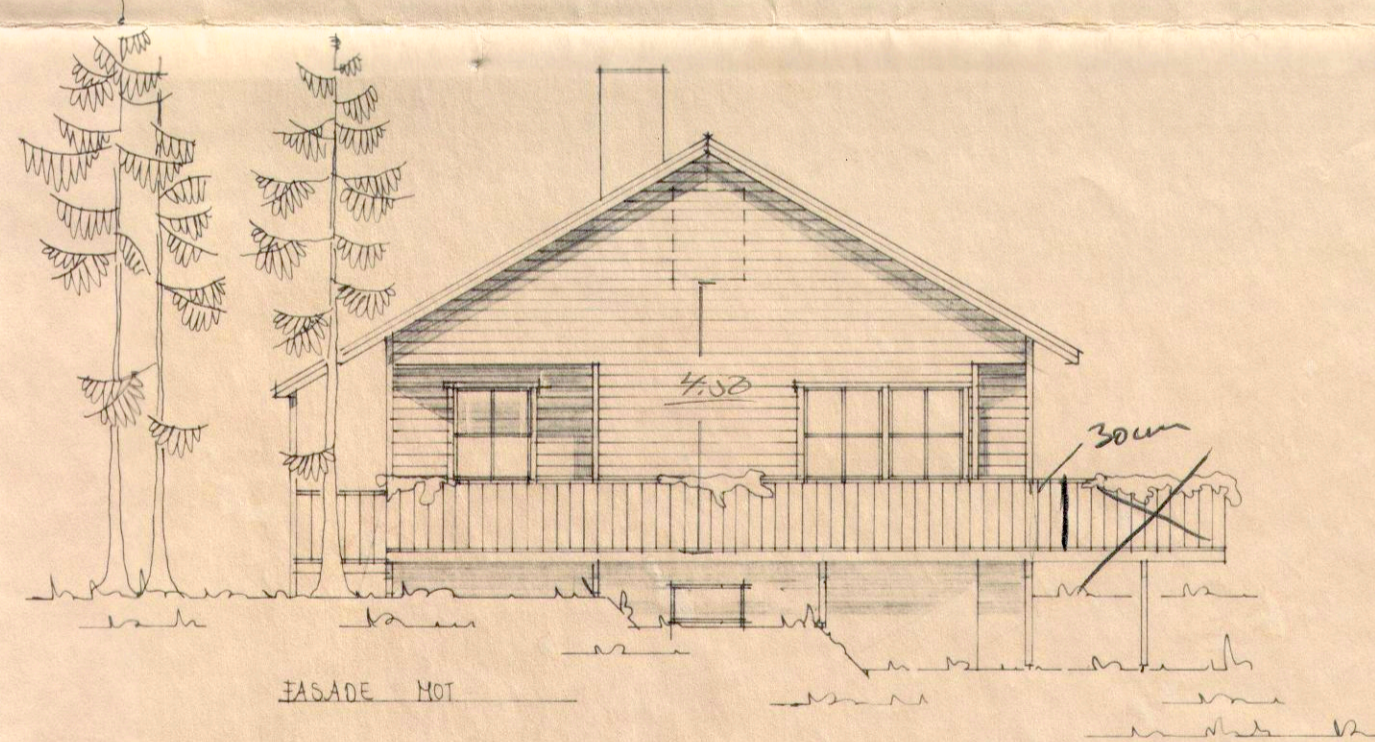

FASADE. NOT

LINDÅS KOMMUNE
TEKNISK ETAT
18.11.88 002634
ARKIV NR. 188-588

HANDSAMA DEN
0 1 DES. 1988
BYGNINGSJEFEN I LINDÅS



REV	ANT	REVIDERINGEN GJELDER	SIGN	DATO
BYGGHERRE				
KARI THOMASSEN, ARILD STANGELAND				
ADRESSE				
BYGGEPLASS				
TEGN.	S.K.W.	ERST. FOR	ERST. AV	
GODKJ.		PROSJ. NR		
MÅL	1:100			
DATO	13.10.88	TEGN. NR	60-1992	