


Lindås, gnr 107 bnr 3, Kolåsvegen  
Data på innmålt fasadeliv

24.02.2015

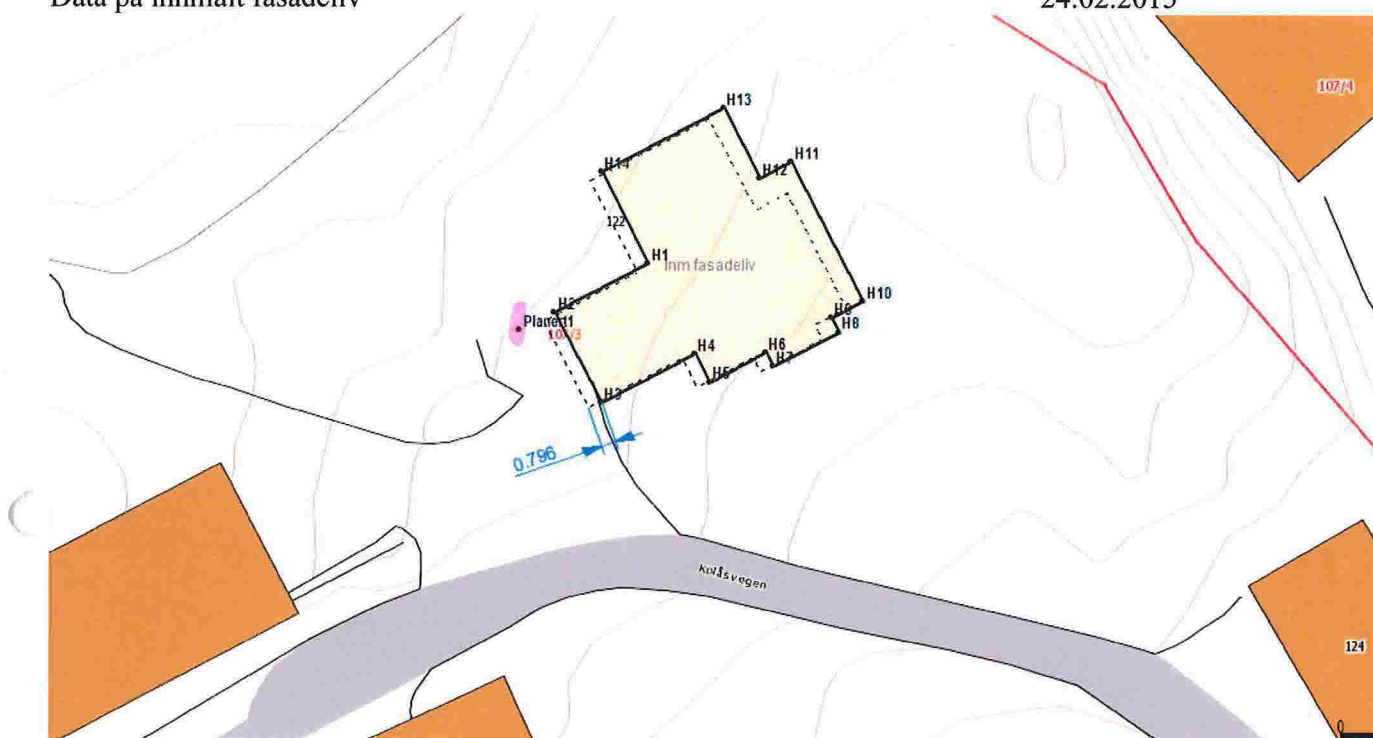

PunktID	N-koord.	Ø-koord.	Høyde
H1	6740856,94	290412,33	
H2	6740854,17	290407,01	
H3	6740849,08	290409,66	
H4	6740851,86	290414,98	
H5	6740850,26	290415,81	
H6	6740851,93	290419,01	
H7	6740851,13	290419,42	
H8	6740853,09	290423,18	
H9	6740853,88	290422,76	
H10	6740854,81	290424,53	
H11	6740862,67	290420,43	
H12	6740861,75	290418,65	
H13	6740865,71	290416,59	
H14	6740862,08	290409,64	

**Høyde planert: kote +137,13**

<b>Planert1</b>	6740853,17	290405,03	137,13
-----------------	------------	-----------	--------

**Vest Oppmåling AS**

PB 84, 5293 Lonevåg  
Tel 5639 4000 Mob 905 12 583