


FASADE NORD




FASADE SØR


28.01.14/LAH	25.02.13/PKT	02.11.12/LAH	DATE/SIGN	RILI/BOLIG & EIENDOM	REVISION/DATE: C/28.01.14	
				4 MANN'S BOLIG ALVERFLATEN	PROJECT NO.: 2012141	
TERRASSER	INNVEDIG BOD	VINDUER OG TRAPP	ENDRET	FASADER	DRAWING NO.: 28312141A04	
C	B	A	REV. DESCRIPTION	 ARKOCONSULT AS, Postboks 103, 5291 Valest.f. Tel.: 56390003 - Fax.: 56191130 - Mob.: 93241511 Mail: post@arkoconsult.no - Org.nr.: 997089782 MVA	SCALE: 1:100	FORMAT: A3
					DRAWN:	DATE:
					CHECKED:	DATE:




FASADE VEST

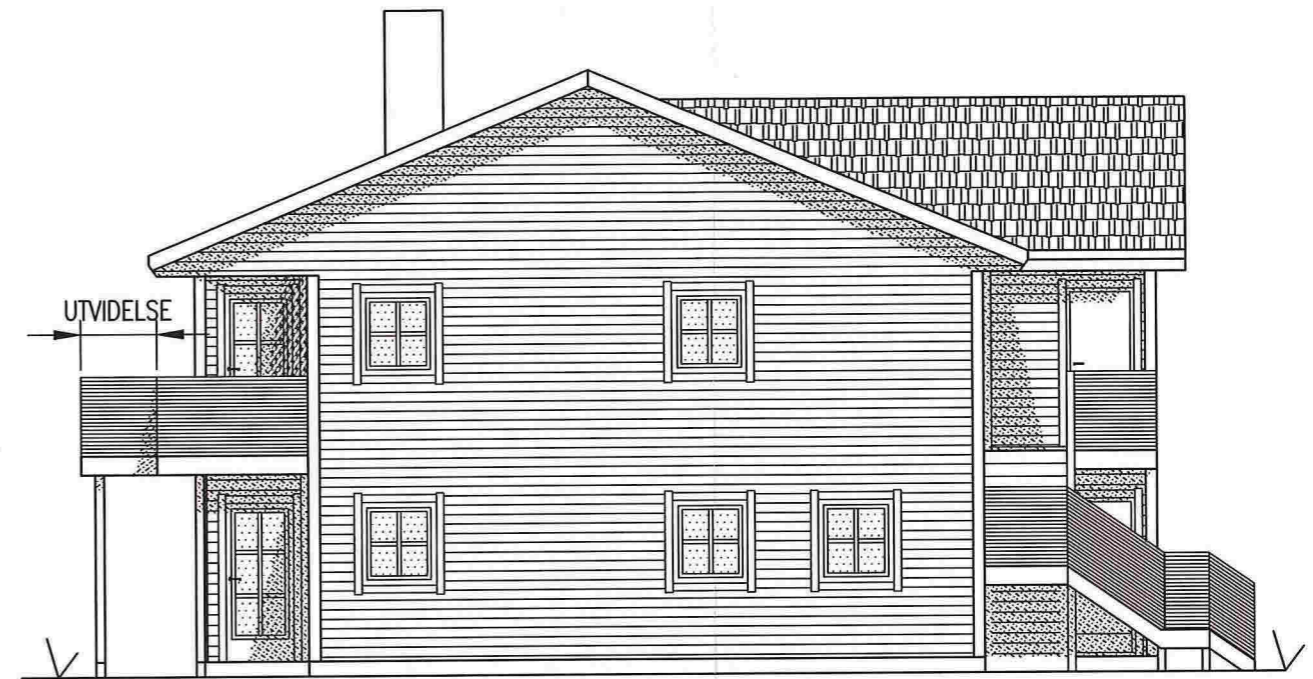


FASADE ØST

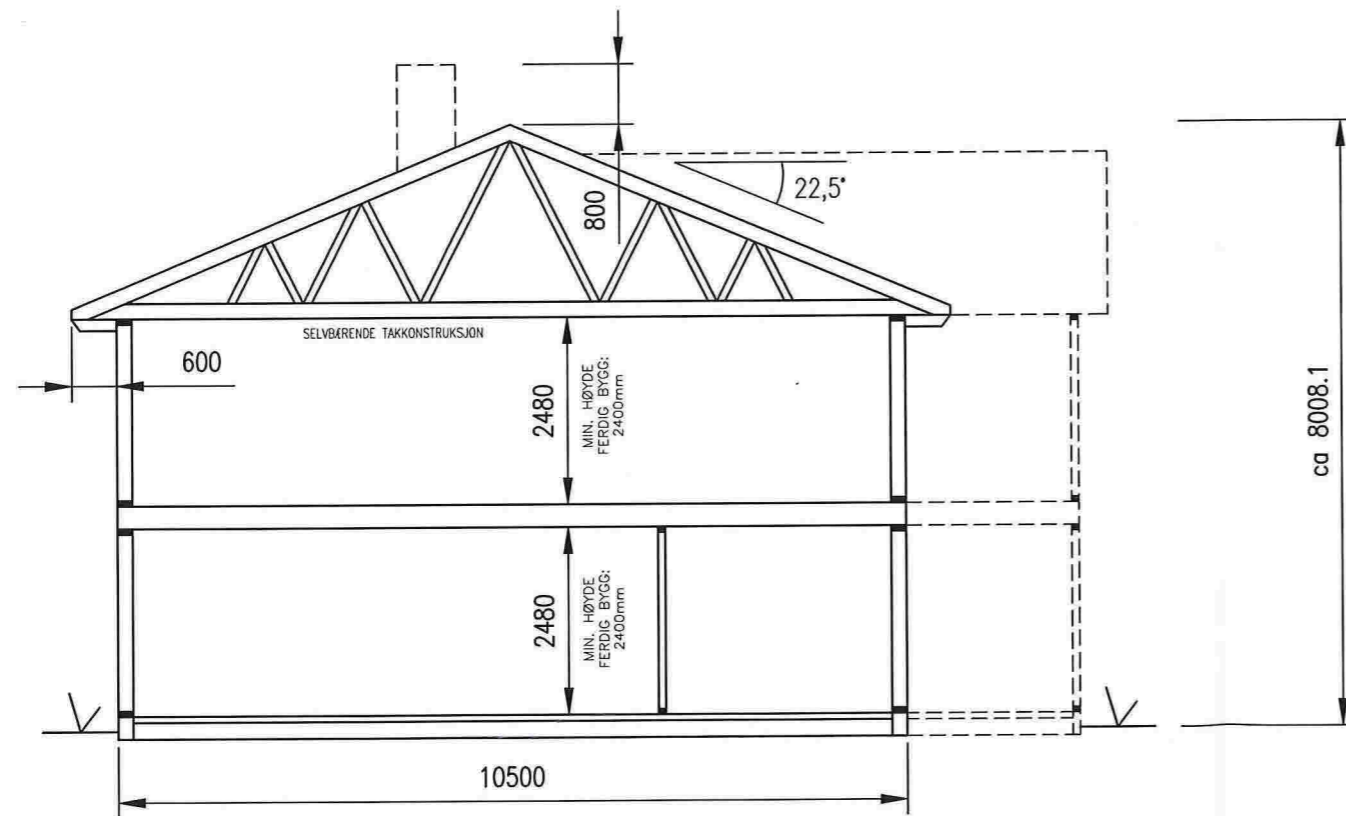


TYPISK SNITT


28.01.14/LAH	25.02.13/PKT	02.11.12/LAH	DATE/SIGN	RILI/BOLIG & EIENDOM	REVISION/DATE: C/28.01.14	
				4 MANNES BOLIG ALVERFLATEN	PROJECT NO.: 2012141	
				FASADER OG SNITT	DRAWING NO.: 28312141A03	
C	B	A	REV. DESCRIPTION	 ARKOCONSULT AS, Postboks 103, 5291 Valest.f. Tel.: 56390003 - Fax.: 56191130 - Mob.: 93241511 Mail: post@arkoconsult.no - Org.nr.: 997089782 MVA	SCALE: 1:100	FORMAT: A3
					DRAWN:	DATE:
					CHECKED:	DATE:

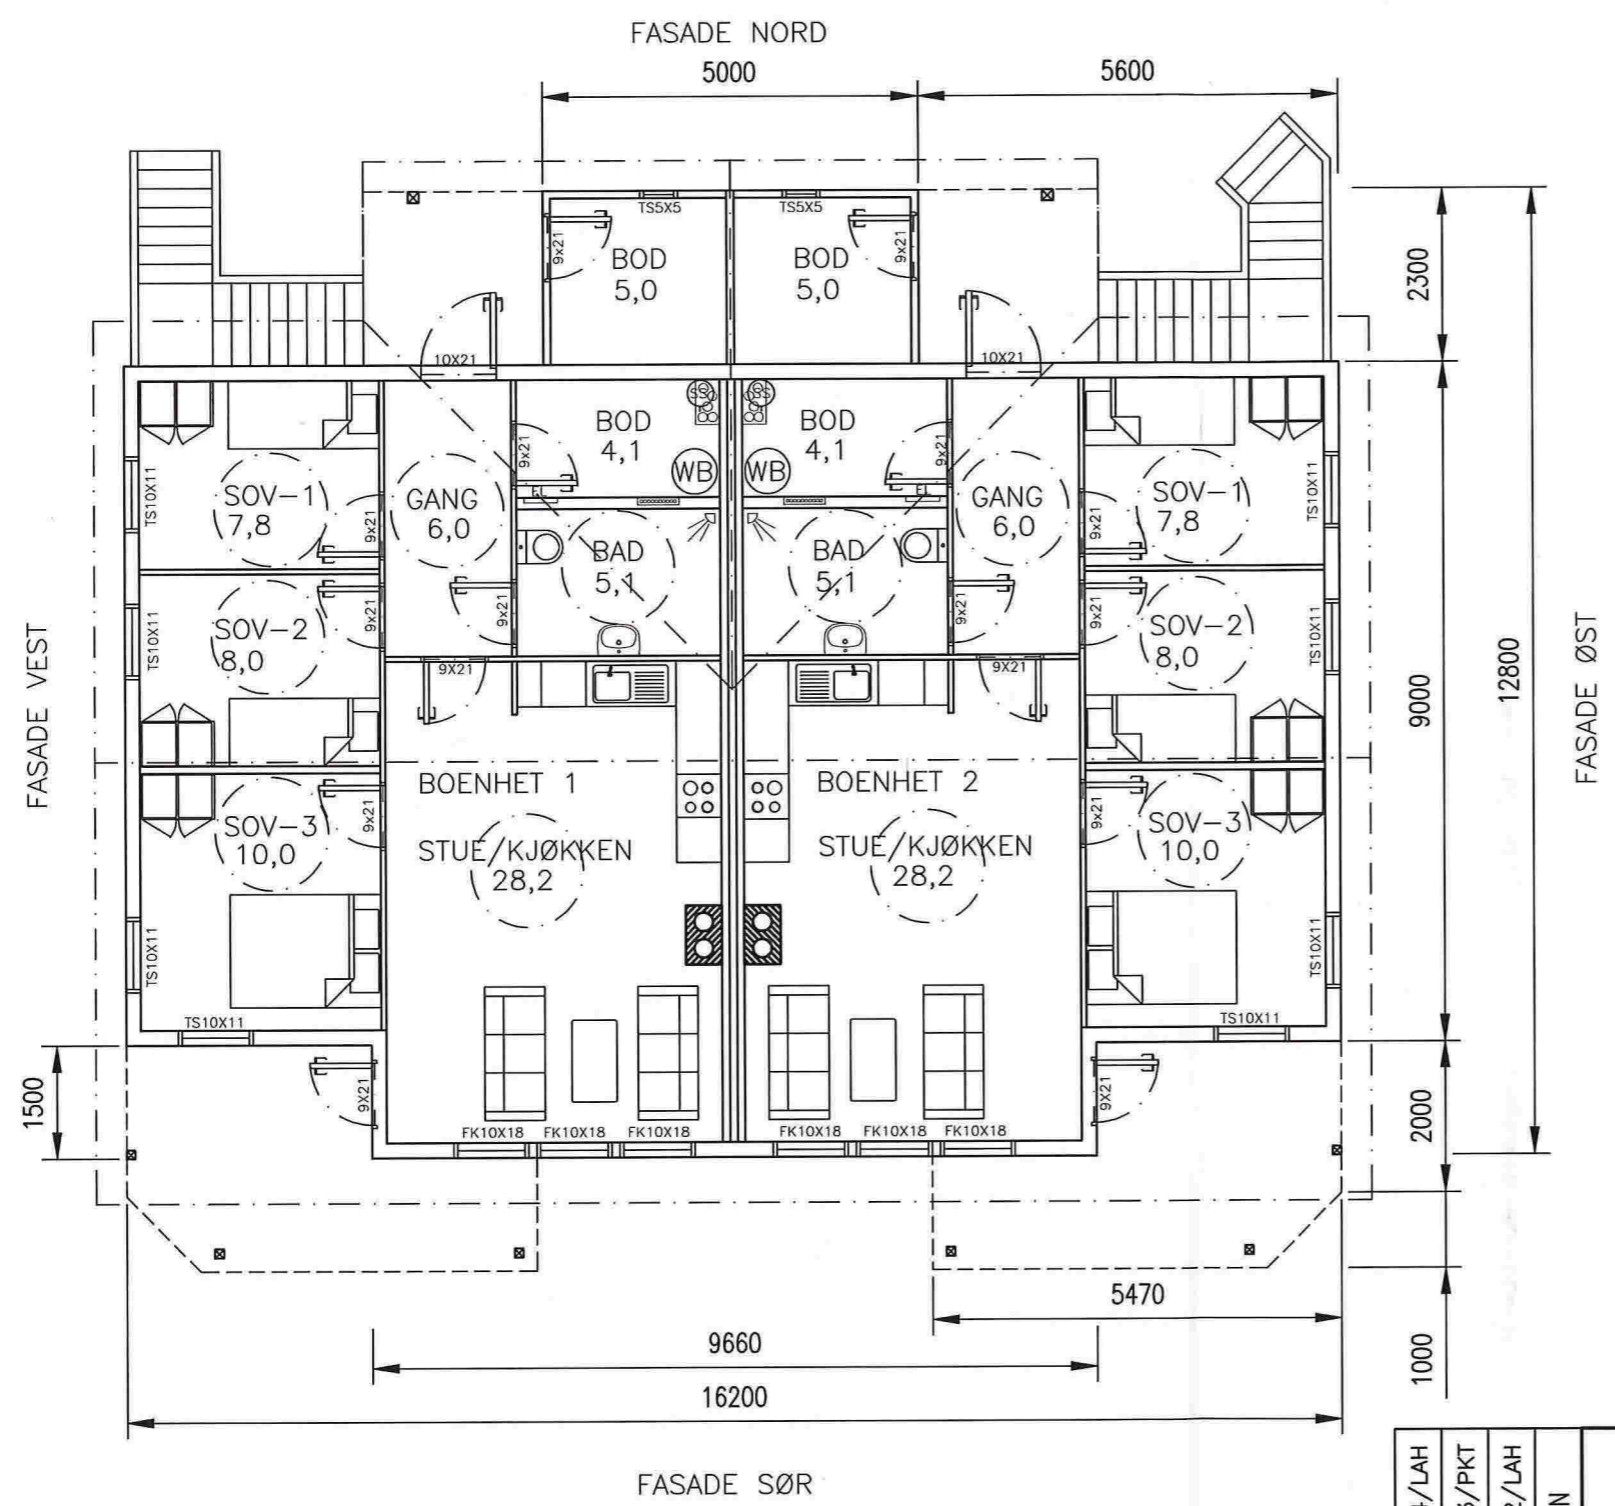

FASADE SØR

PLAN 1

28.01.14/LAH	25.02.13/PKT	02.11.12/LAH	DATE/SIGN	RILI/BOLIG & EIENDOM		REVISION/DATE: C/28.01.14
				4 MANNES BOLIG ALVERFLATEN		PROJECT NO.: 2012141
C	B	A	REV. DESCRIPTION	PLAN 1		DRAWING NO.:
						28312141A02
						SCALE: 1:100
				ARKOCONSULT AS, Postboks 103, 5291 Valest.f. Tel.: 56390003 - Fax.: 56191130 - Mob.: 93241511 Mail: post@arkoconsult.no - Org.nr.: 997089782 MVA		FORMAT: A3
						CHECKED: DATE:

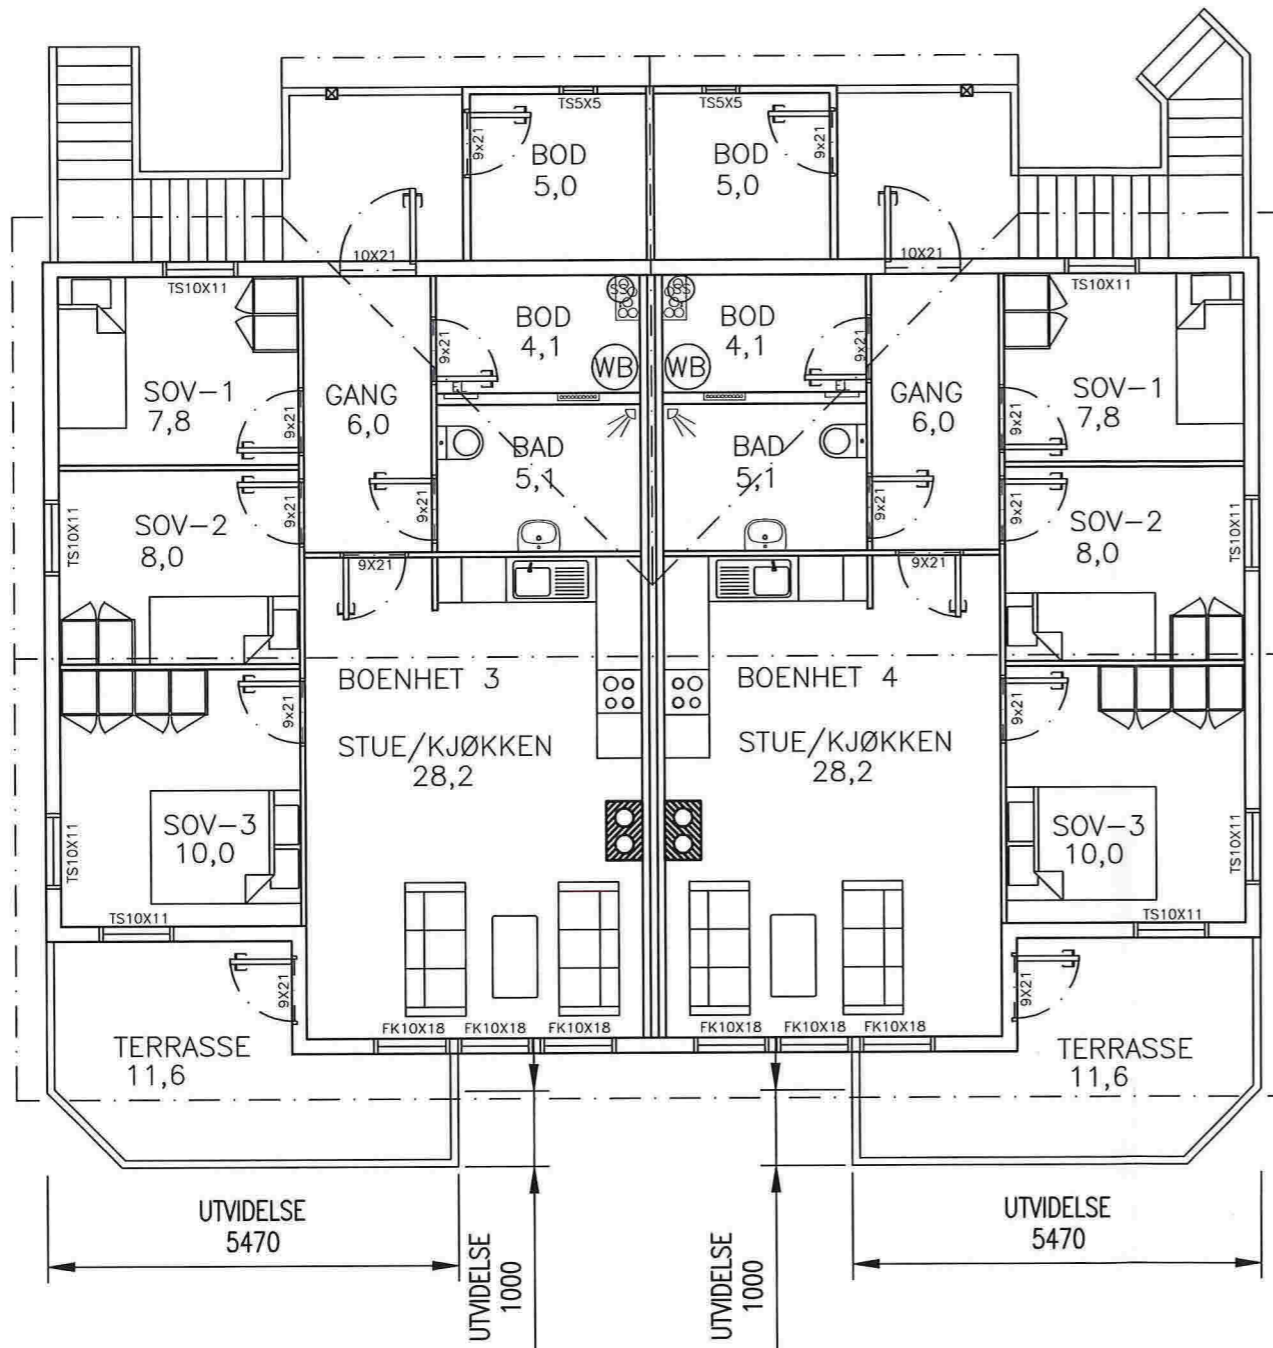

PLAN 2

BRA BOENHET 3 INNVENDIG:	ca 77,9 m2
P-ROM BOENHET 3:	ca 68,1 m2
BTA BOENHET 3:	ca 85,8 m2
BRA BOENHET 4 INNVENDIG:	ca 77,9 m2
P-ROM BOENHET 4:	ca 68,1 m2
BTA BOENHET 4:	ca 85,8 m2

28.01.14/LAH	RILI/BOLIG & EIENDOM	REVISION/DATE: C/28.01.14	
25.02.13/PKT		4 MANN'S BOLIG ALVERFLATEN	PROJECT NO.: 2012141
02.11.12/LAH	PLAN 2	DRAWING NO.:	
DATE/SIGN		28312141A01	
TERRASSER		SCALE: 1:100	FORMAT: A3
B INNVENDIG BOD	ARKOCONSULT AS, Postboks 103, 5291 Valest.f. Tel.: 56390003 - Fax.: 56191130 - Mob.: 93241511 Mail: post@arkoconsult.no - Org.nr.: 997089782 MVA	DRAWN:	DATE:
A VINDUER OG TRAPP ENDRET		CHECKED:	DATE:
REV. DESCRIPTION			

