




Lindås, gnr 239 bnr 119, Eknes
Data på innmålt grunnmur

27.06.2014

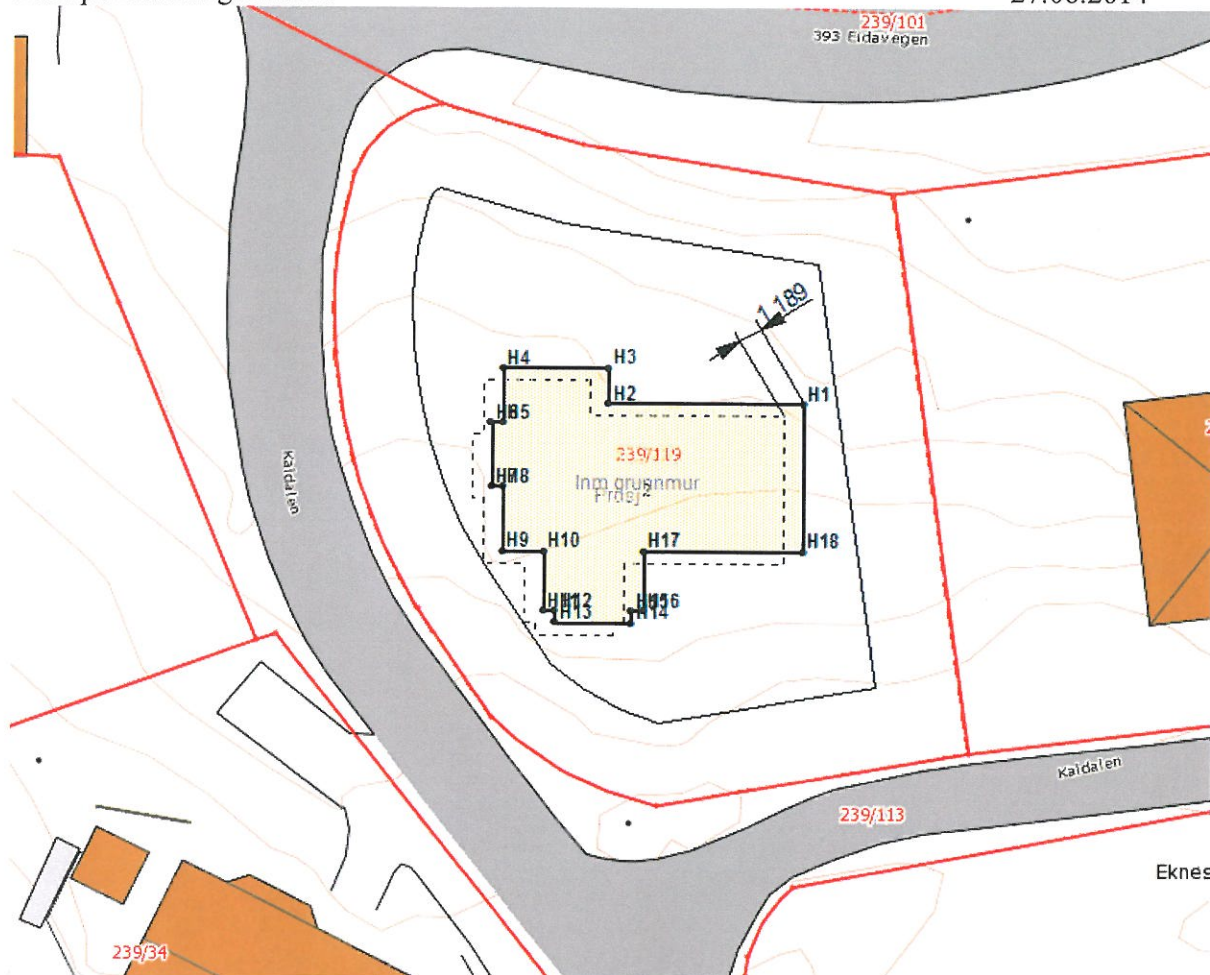

PunktID	N-koord.	Ø-koord.	Høyde
H1	6723829,23	305441,25	28,60
H2	6723829,22	305431,36	28,61
H3	6723831,04	305431,35	28,61
H4	6723831,00	305425,96	28,61
H5	6723828,24	305425,96	28,61
H6	6723828,24	305425,37	28,61
H7	6723825,01	305425,38	28,61
H8	6723825,01	305425,99	28,61
H9	6723821,72	305425,98	28,61
H10	6723821,72	305428,08	28,61
H11	6723818,71	305428,08	28,61
H12	6723818,72	305428,67	28,61
H13	6723818,11	305428,68	28,62
H14	6723818,10	305432,57	28,61
H15	6723818,71	305432,57	28,61
H16	6723818,71	305433,17	28,60
H17	6723821,72	305433,17	28,61
H18	6723821,74	305441,27	28,60

Vest Oppmåling AS

PB 84, 5293 Lonevåg
Tel 5639 4000 Mob 905 12 583