




**Vest
Oppmåling AS**

D-1
3/3

Lindås, gnr 56 bnr 150,
Data på innmålt fasadeliv

26.03.2015

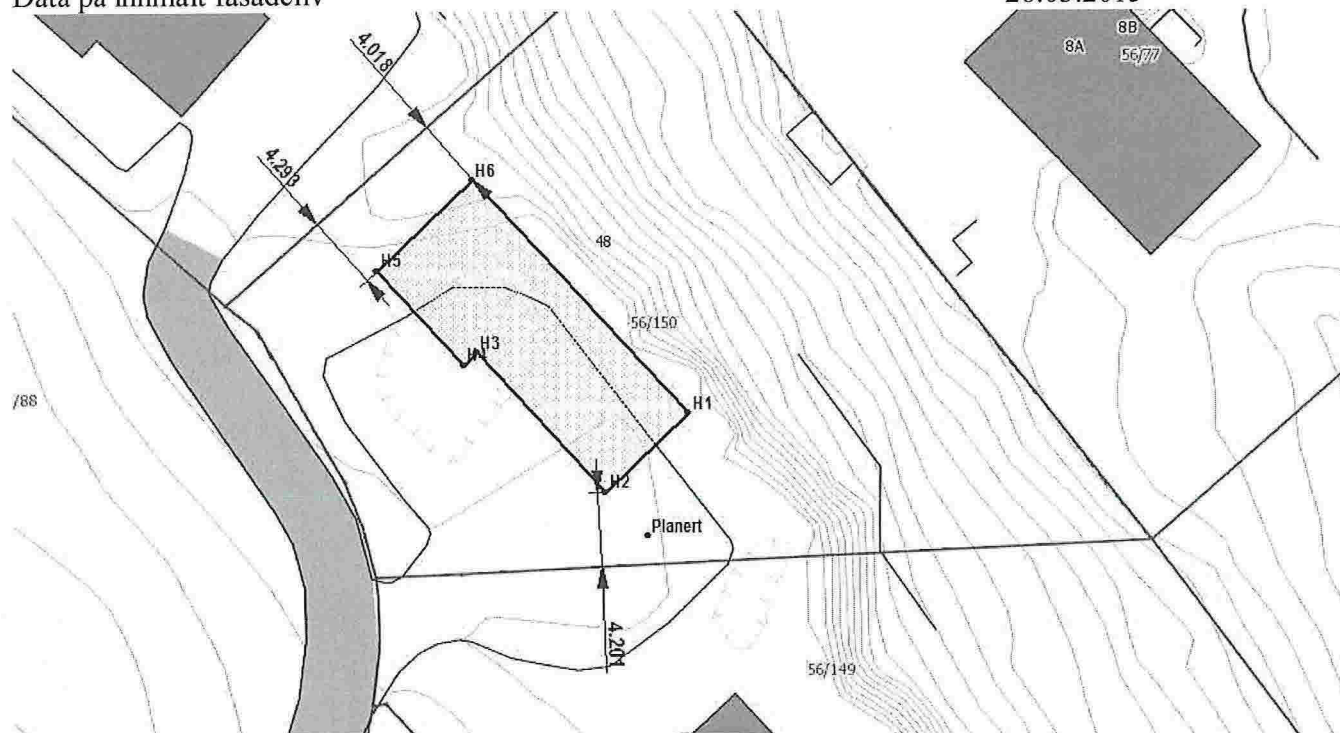

PunktID	N-koord.	Ø-koord.	Høyde
H1	6733331,78	292612,58	
H2	6733327,32	292607,84	
H3	6733335,18	292600,44	
H4	6733334,51	292599,72	
H5	6733339,78	292594,75	
H6	6733344,91	292600,20	

Høyde planert: kote +35,9

Planert	6733324,79	292610,22	35,90
---------	------------	-----------	-------

Vest Oppmåling AS

PB 84, 5293 Lonevåg
Tel 5639 4000 Mob 905 12 583