


NORD-VEST

Etter endring 1.4.14

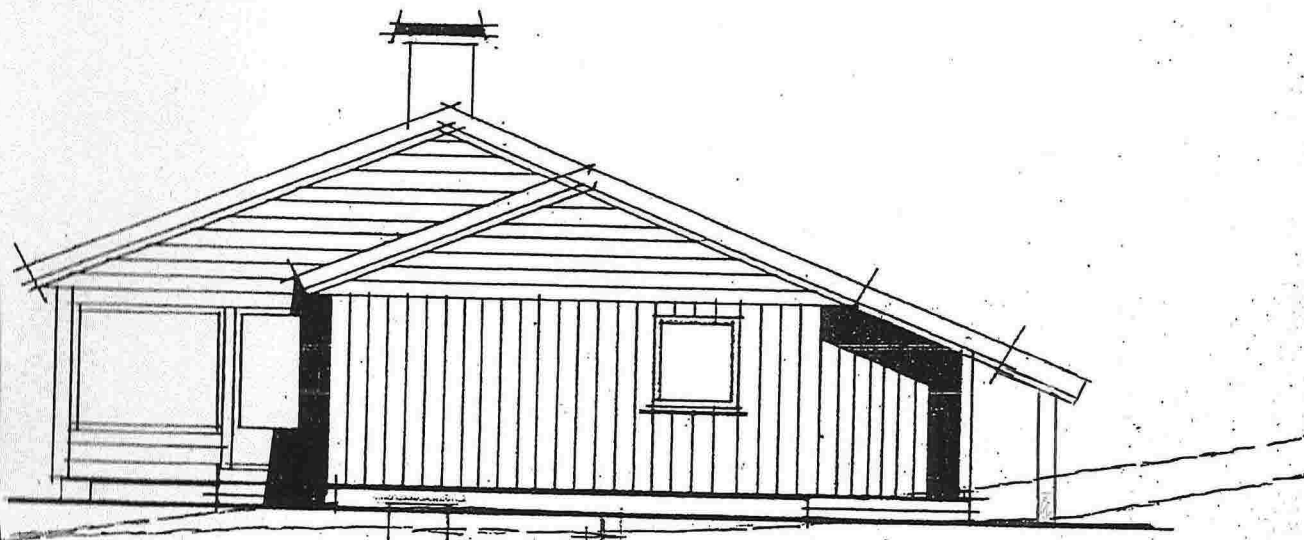

SÖR-ÖST

