




Lindås, gnr 202 bnr 154, Hjelmås
Data på innmålt fasadeliv

23.02.2015

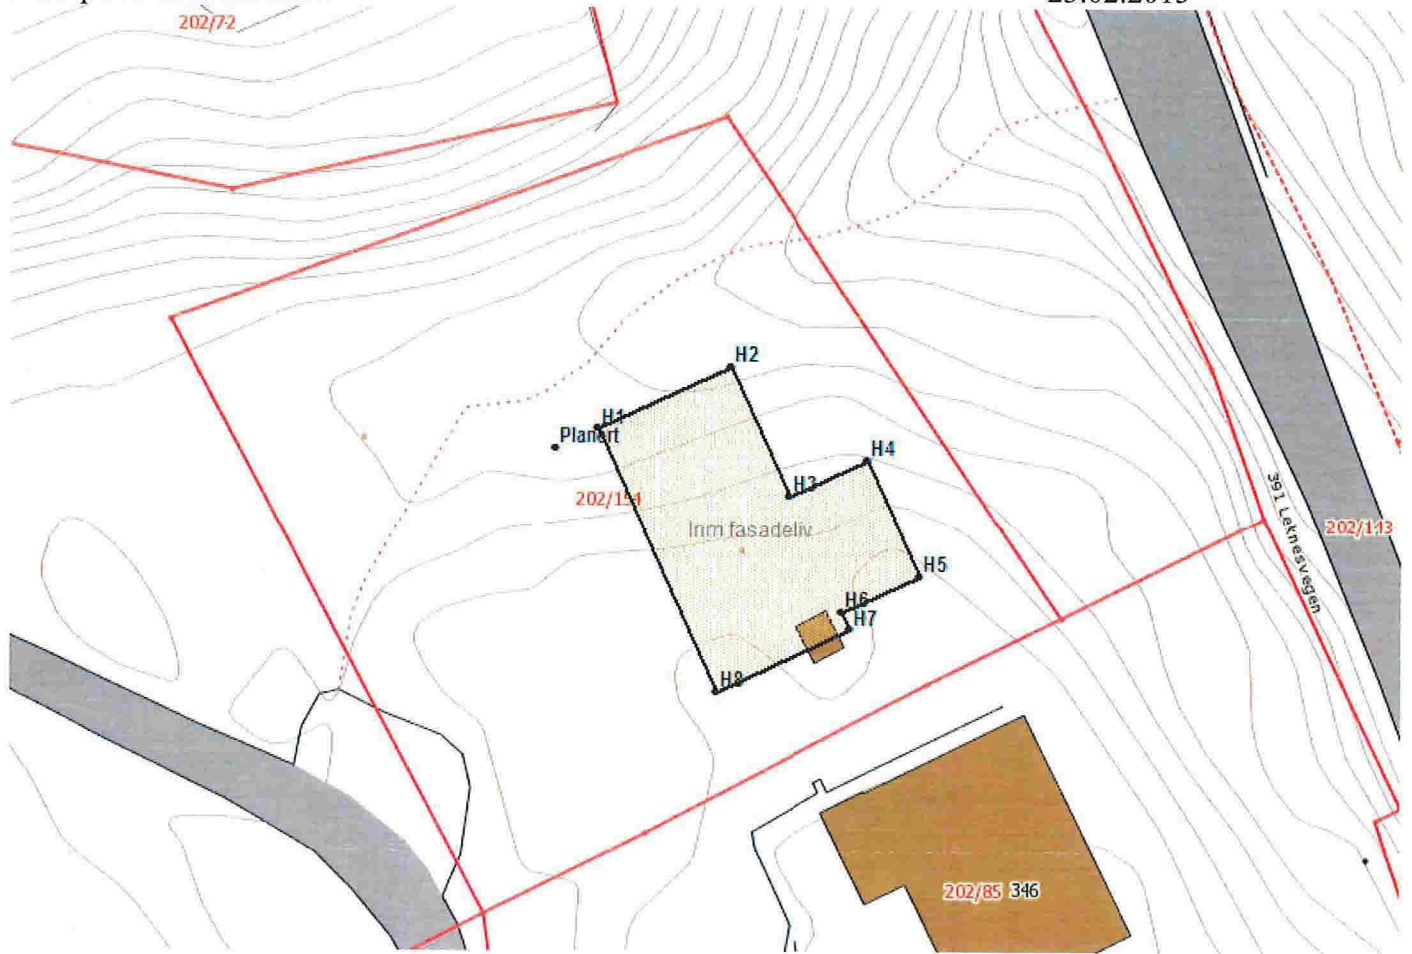

PunktID	N-koord.	Ø-koord.	Høyde
H1	6722569,13	300677,25	
H2	6722572,38	300684,30	
H3	6722565,59	300687,42	
H4	6722567,47	300691,52	
H5	6722561,41	300694,31	
H6	6722559,52	300690,21	
H7	6722558,59	300690,64	
H8	6722555,34	300683,59	

Høyde planert: kote +50,82

Planert	6722568,10	300675,00	50,82
---------	------------	-----------	-------

Vest Oppmåling AS

PB 84, 5293 Lonevåg
Tel 5639 4000 Mob 905 12 583