


# Vedlegg 1

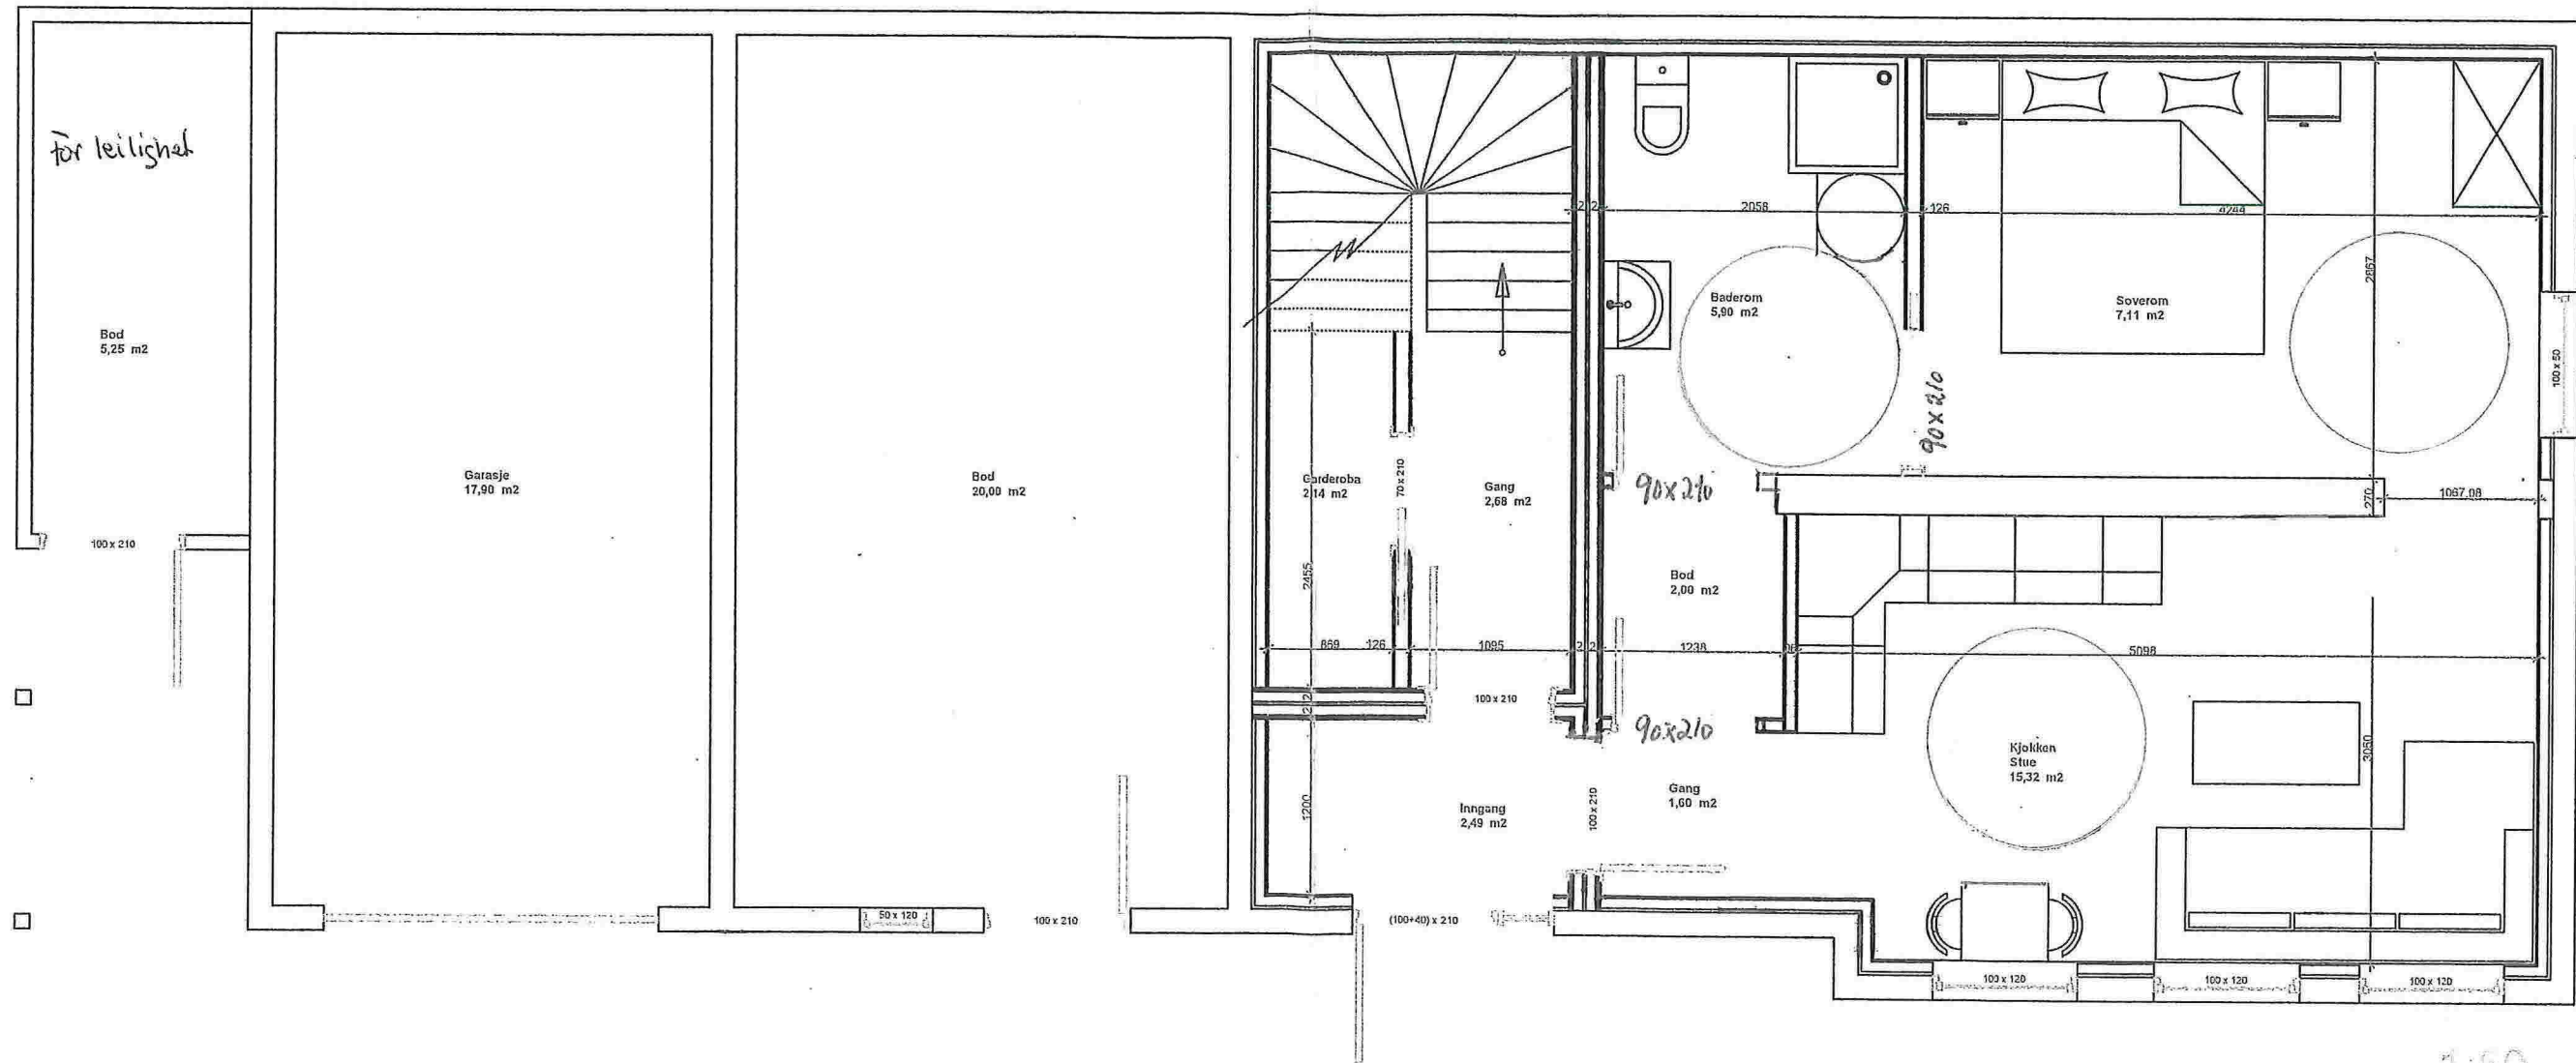

1:50