


"Nye vei" til neste område som
 beskrevet i skjøte

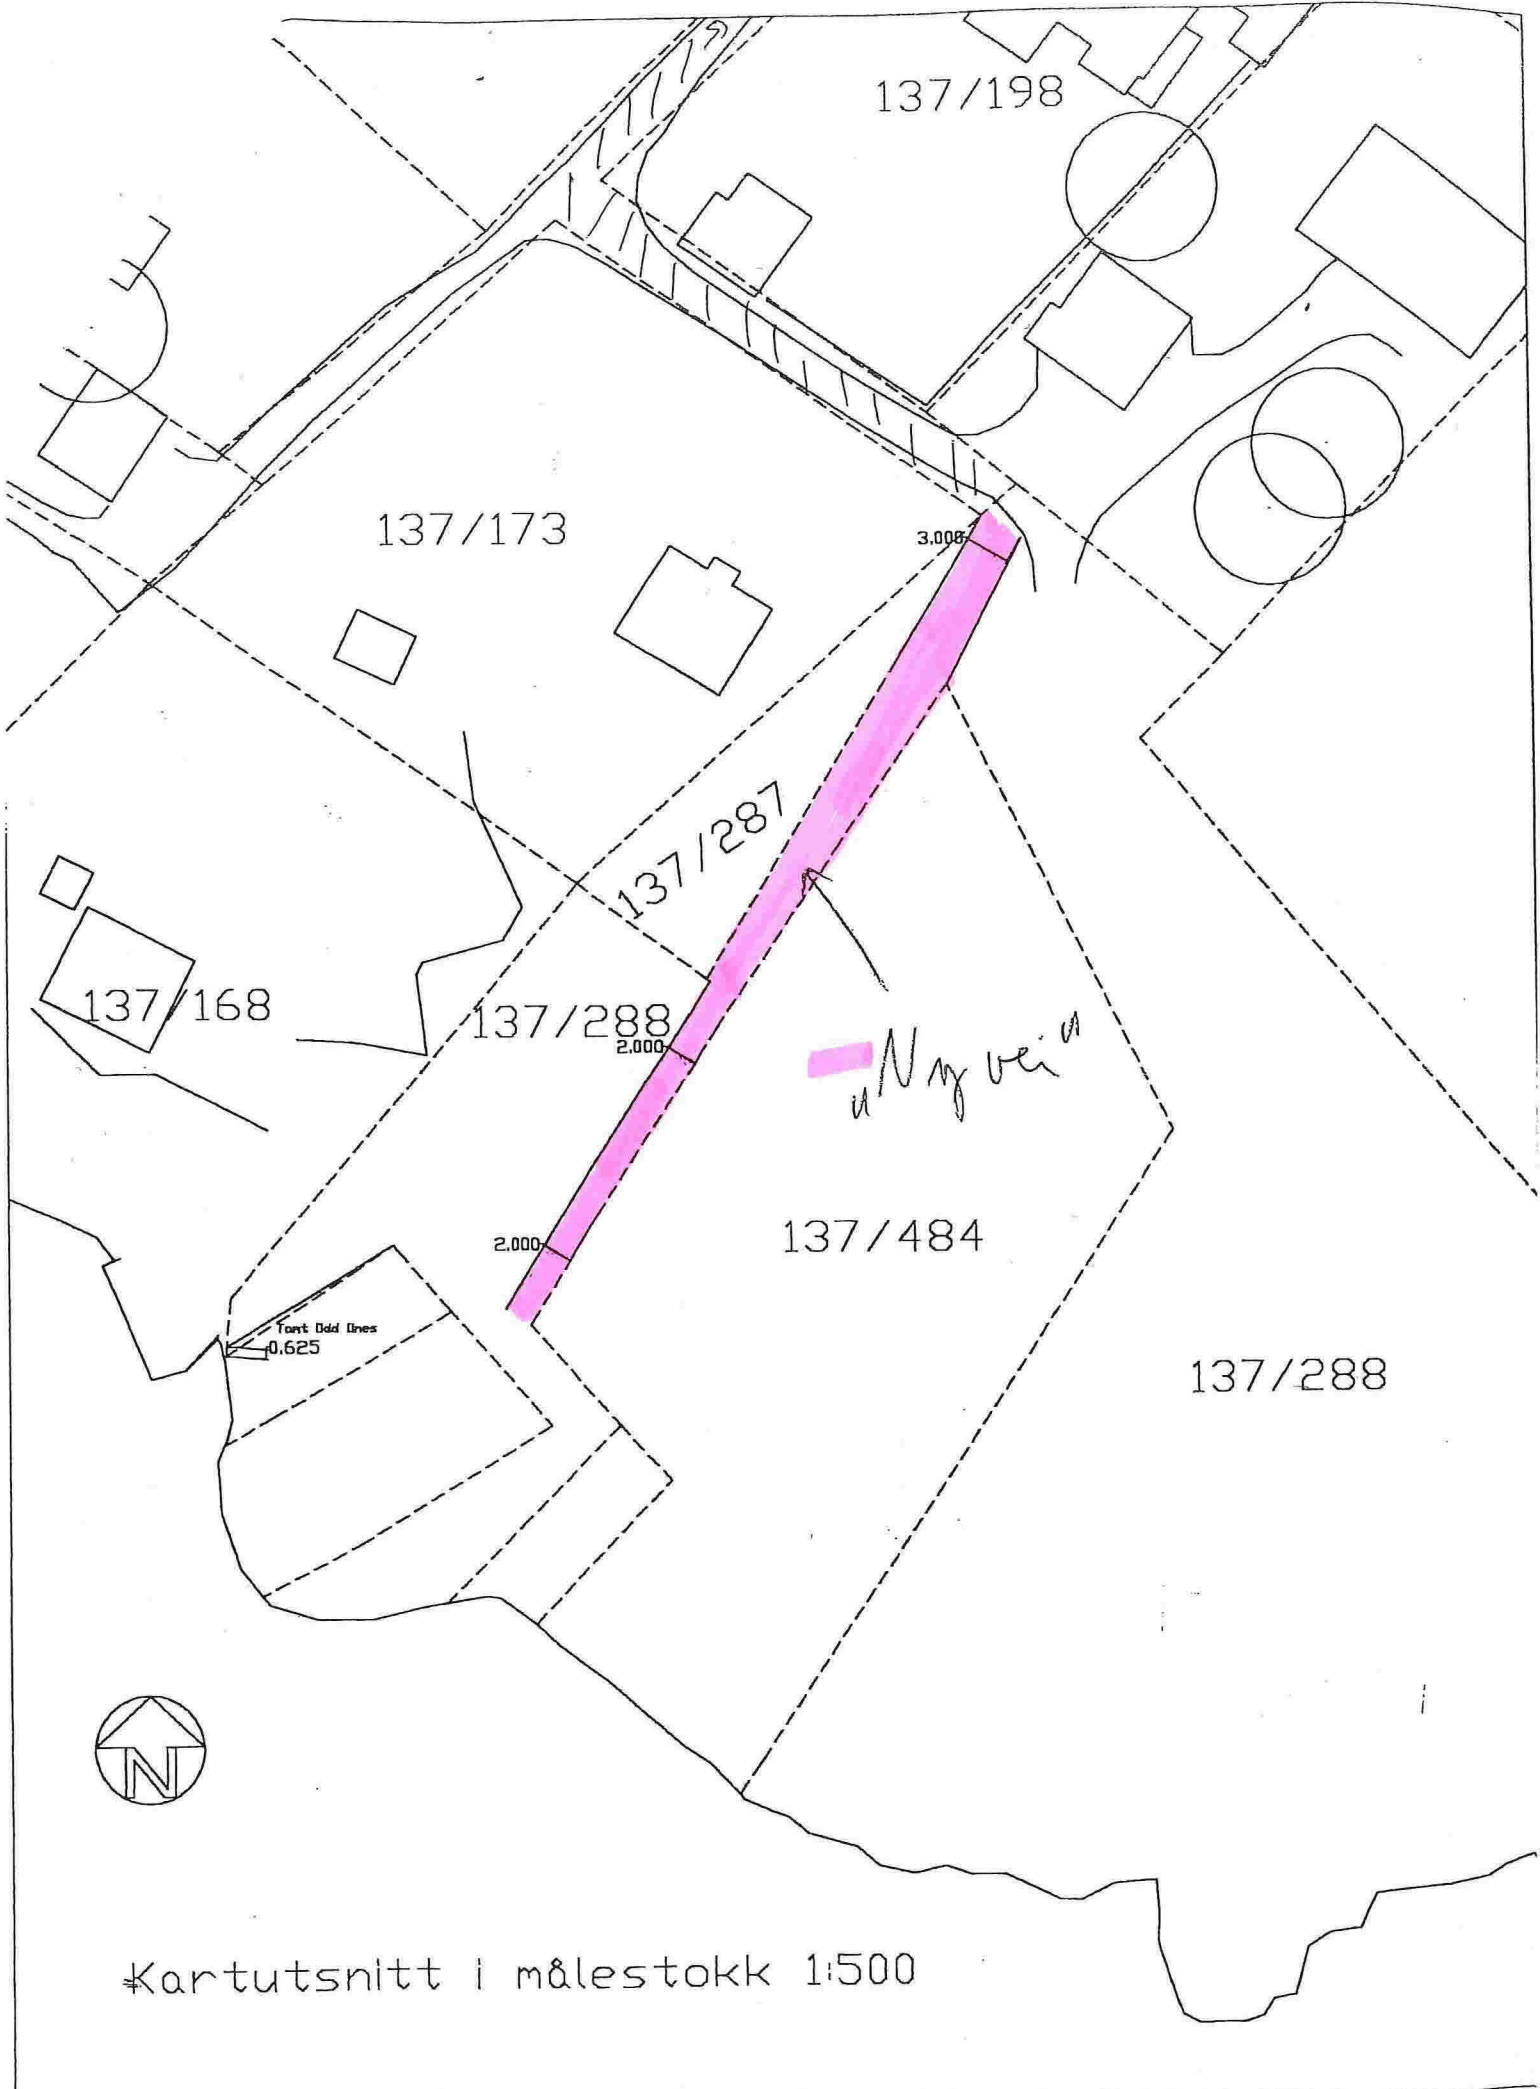

137/198

137/173

3,000

137/287

137/168

137/288
2,000


Nyg vei

2,000

137/484

Fast Odd Lines
0.625

137/288

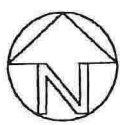

Kartutsnitt i målestokk 1:500