


"Ny vei" til neste område som
beskrevet i skjøte

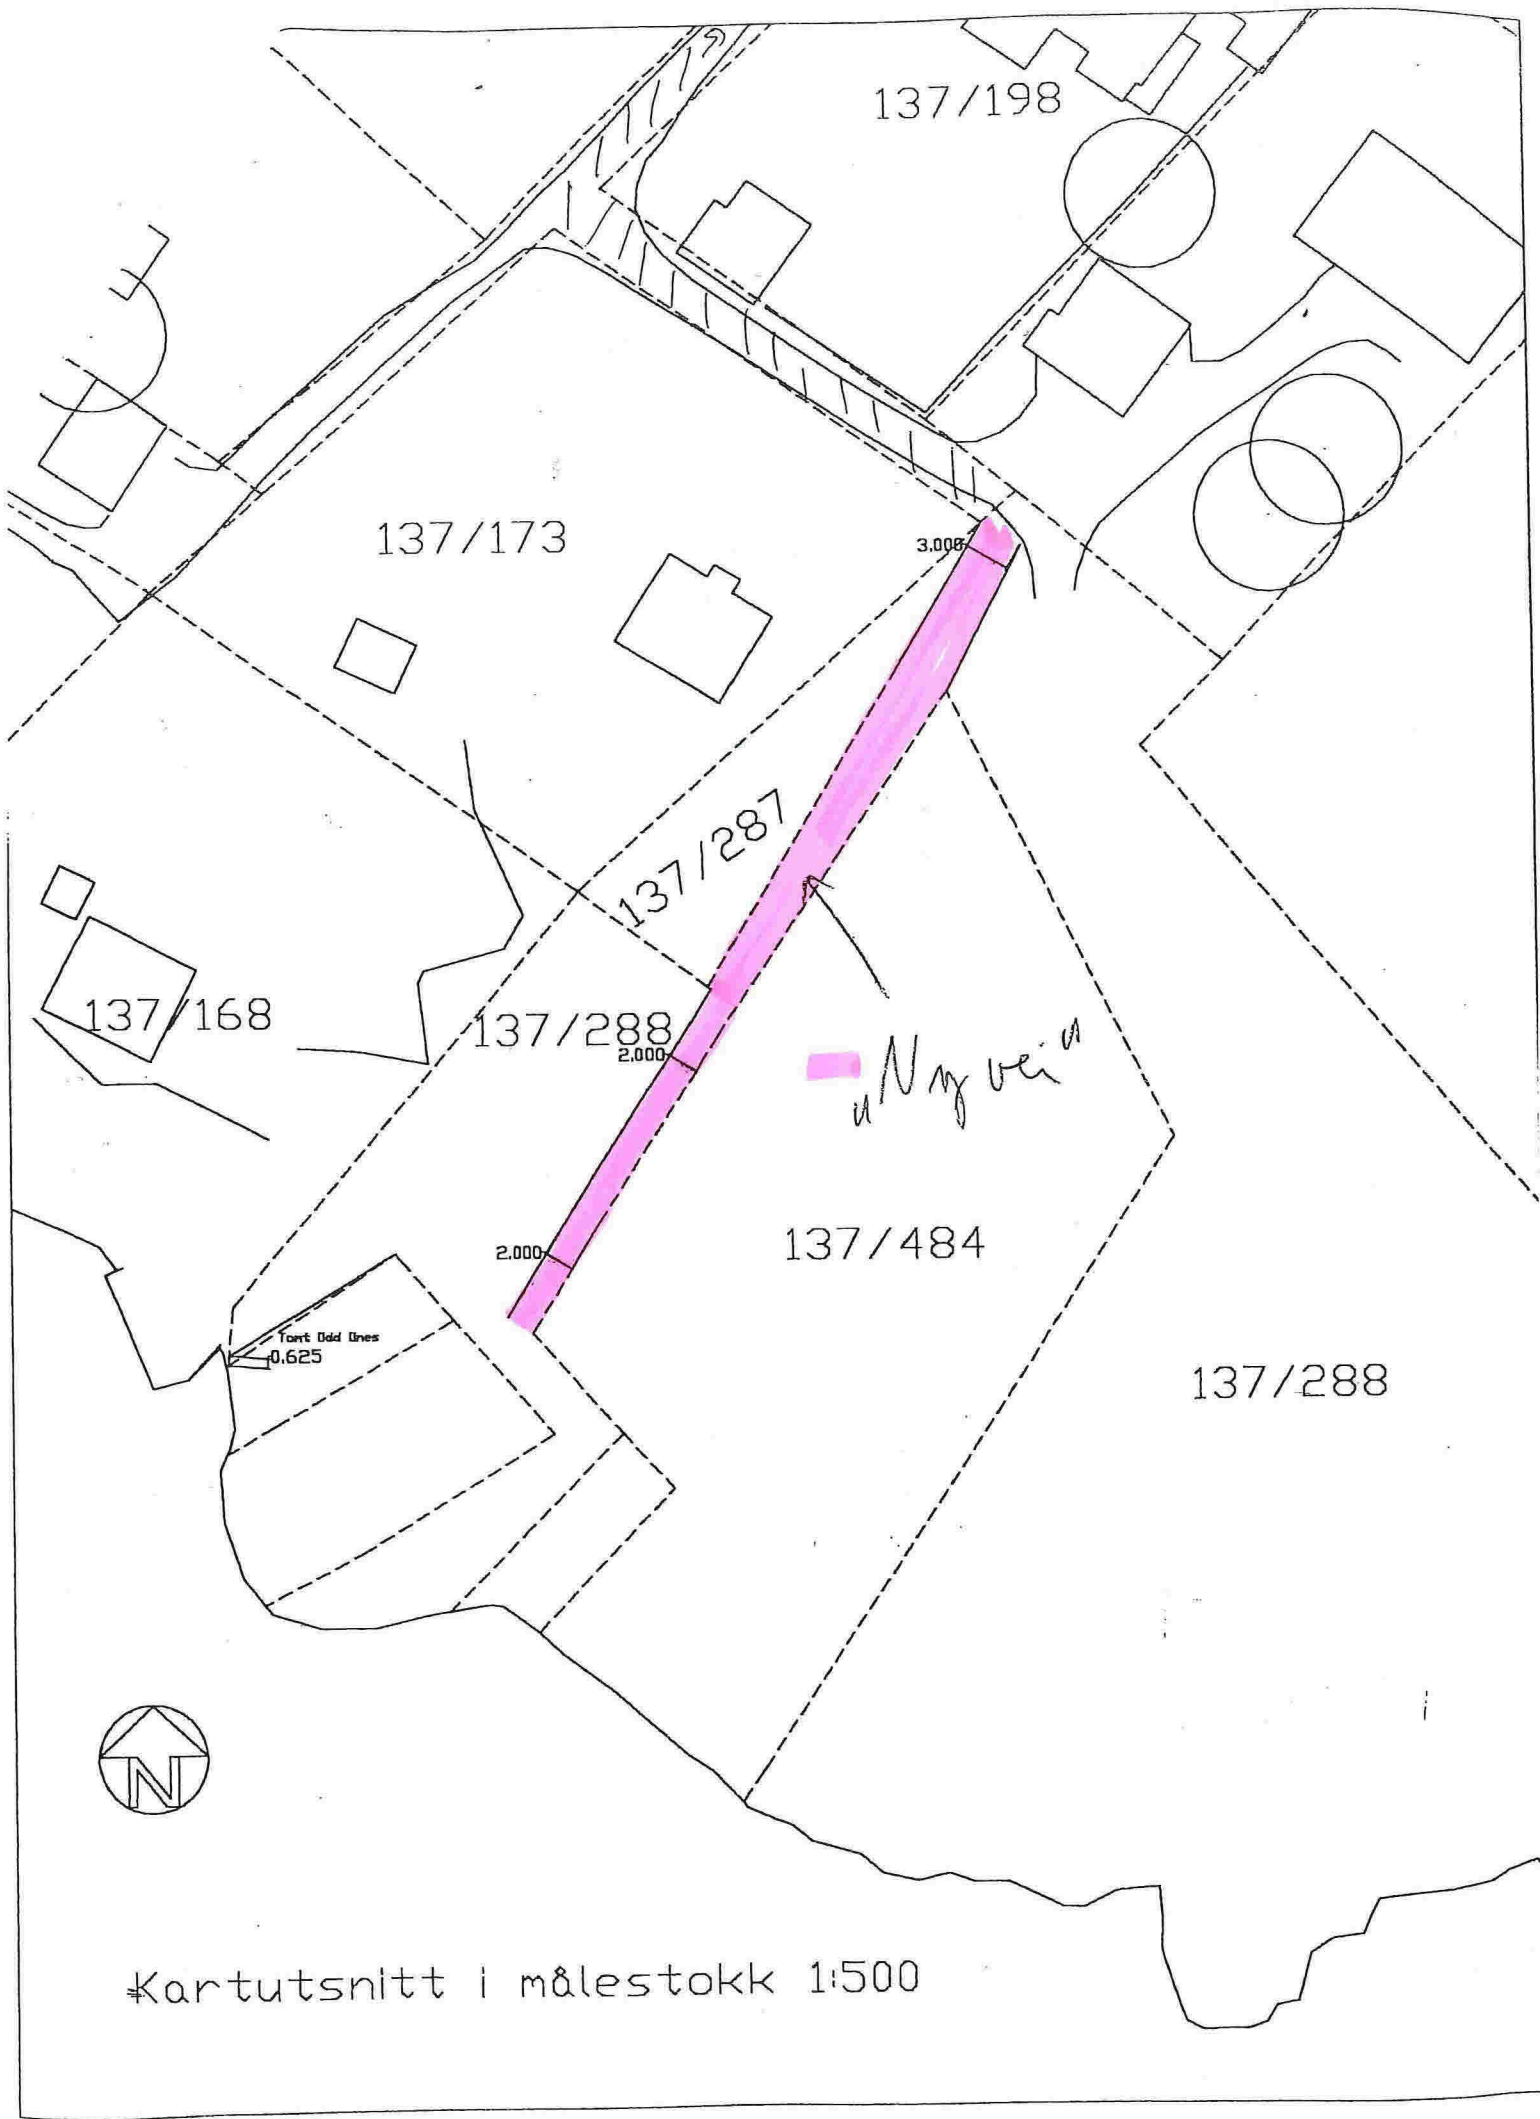

137/198

137/173

3.000

137/287

137/168

137/288

2.000

Nyg vei

2.000

137/484

Tørst Odd lines
0.625

137/288



Kartutsnitt i målestokk 1:500