



SYD - ØST

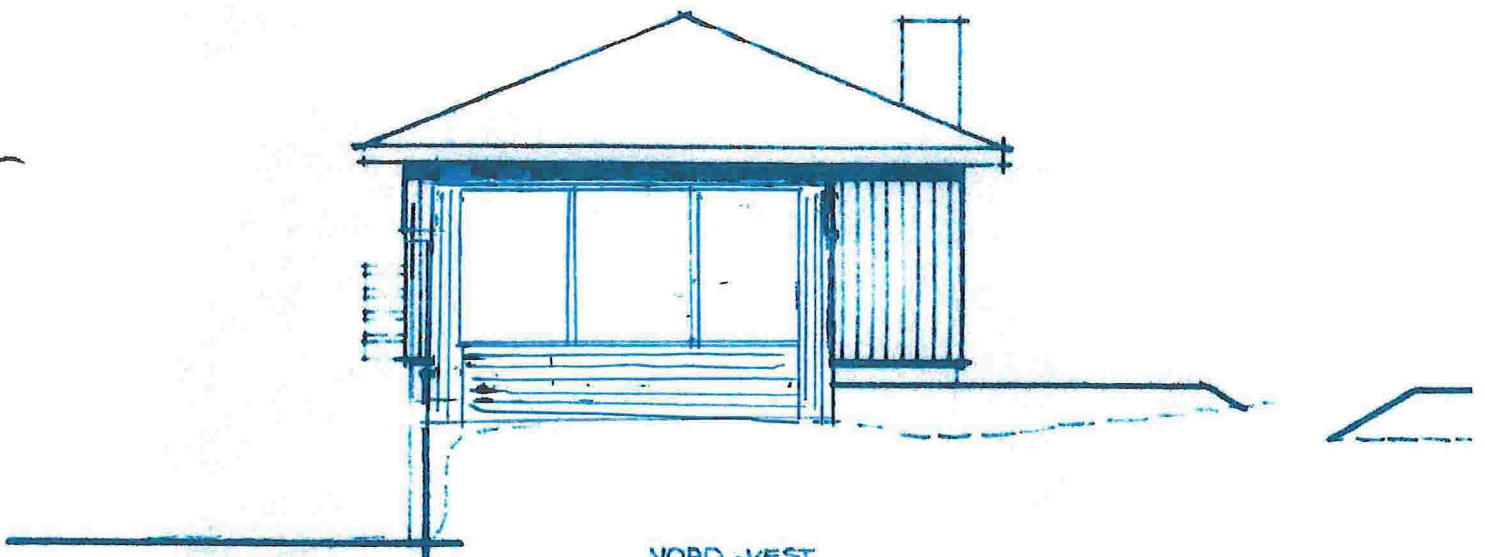


NORD - VEST

BYGNINGS  
INGENIØR F. V. SKAUGE  
02081 14.9.77  
Arkiv nr. 4-9

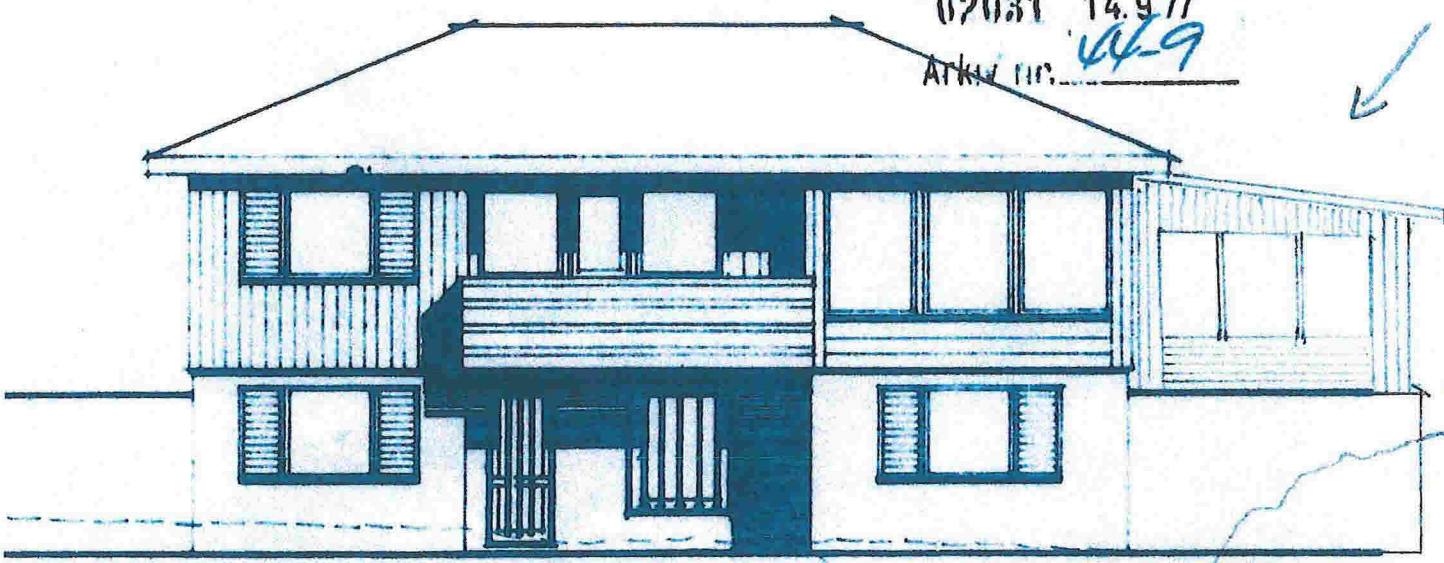

NORD-ØST

BANDSAMMENS  
20. DES. 1977  
LINDÅS BYGNINGSRÅD

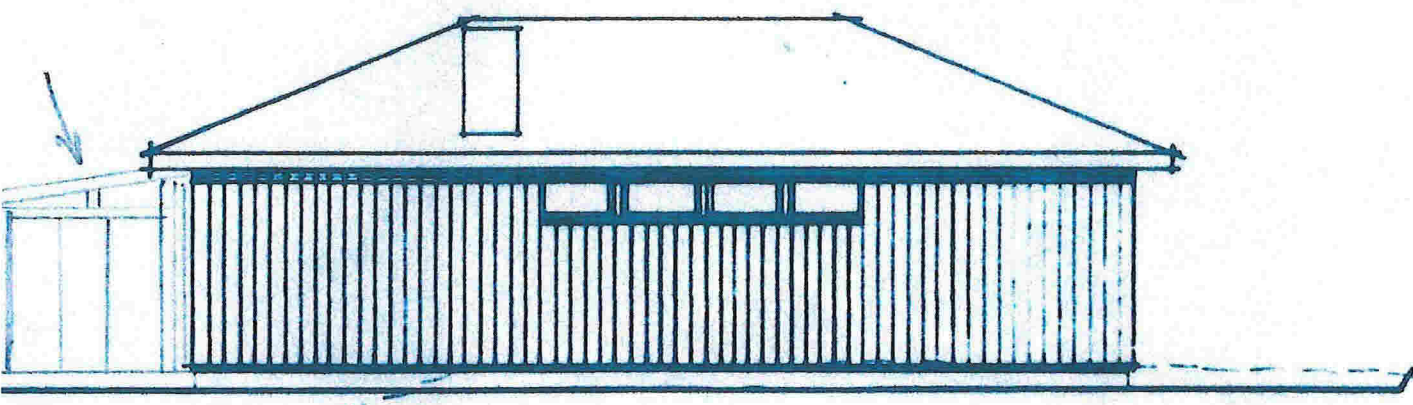


SYD-VEST

<b>BRUVIKHUS</b> TYPE 207 →	TOR A. SKAUGE	FASADER M=1:100
Denne tegning kan kun benyttes i forbindelse med materialleverance fra firma AKSEL BRUVIK		

436  
410  
368

3640 x 1900

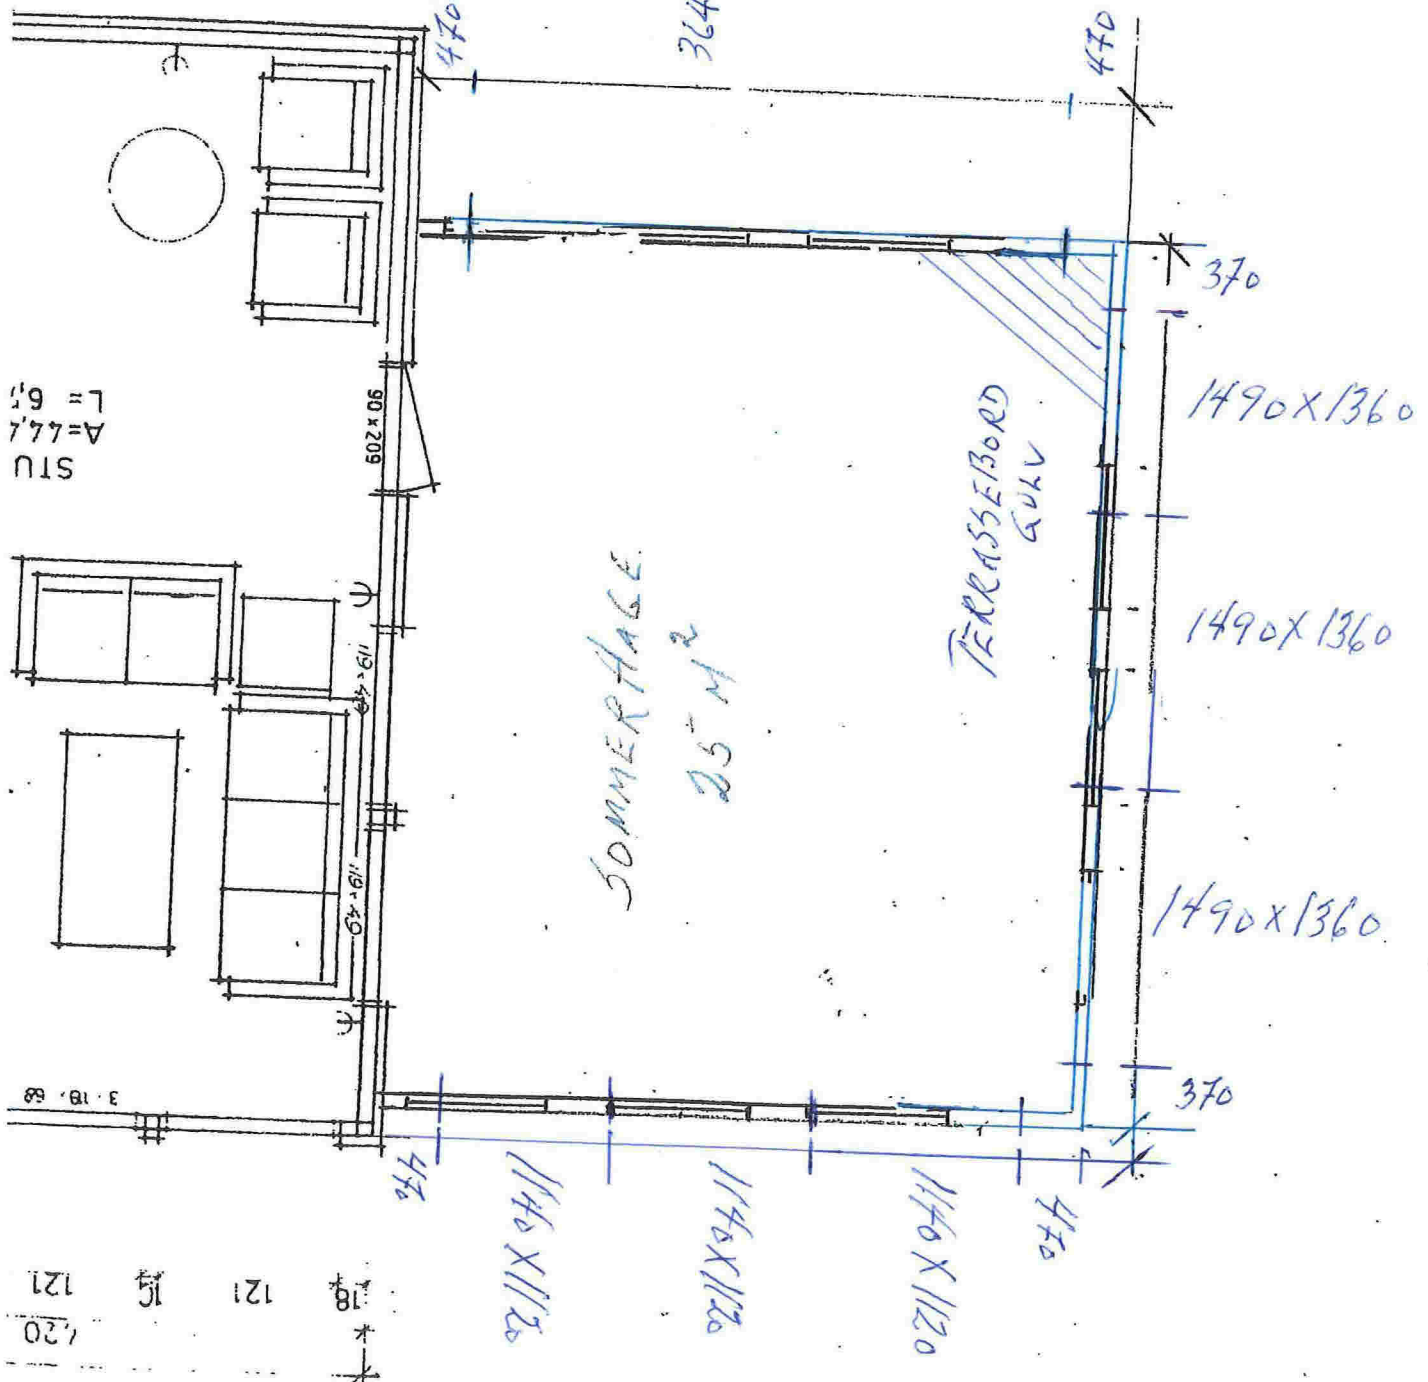

STU  
A = 44,7  
L = 6,5

SOMMERHAGE  
25 M<sup>2</sup>

TERRASSEBORD  
GUV

1490 x 1360

1490 x 1360

1490 x 1360

3.18.68

18  
121  
15  
121  
120

1140 x 1120

1140 x 1120

1140 x 1120

370

470

470

119 x 40

119 x 40

90 x 205

470

470

370

370

18

121

15

121  
120