




Snitt A-A

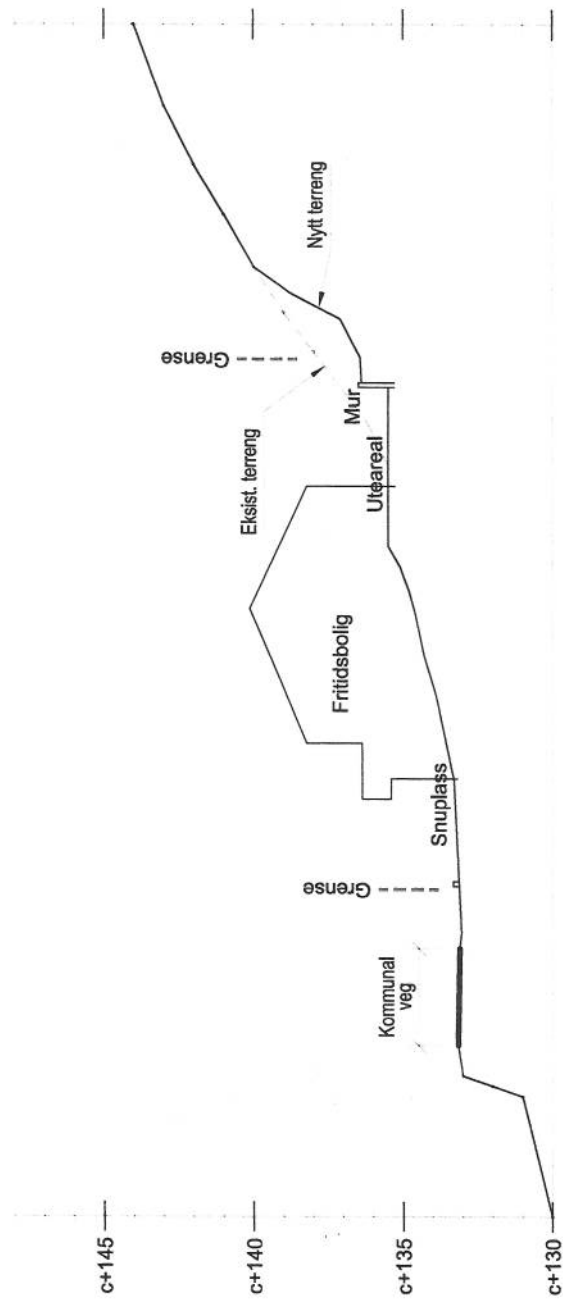


Snitt B-B

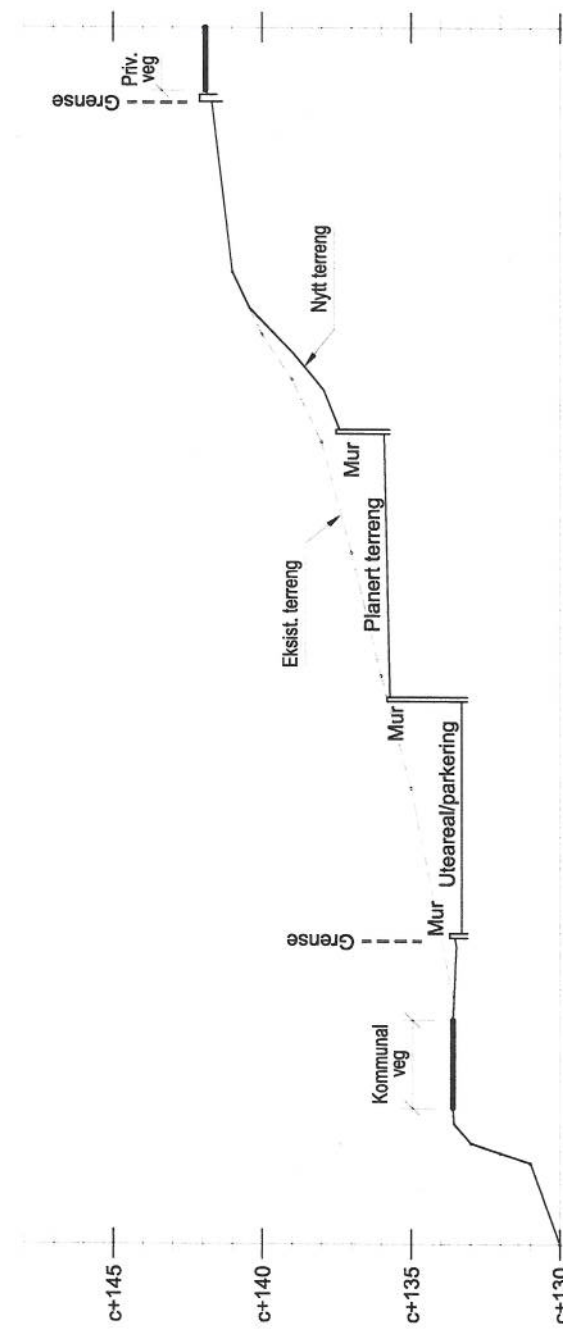

Snitt C-C

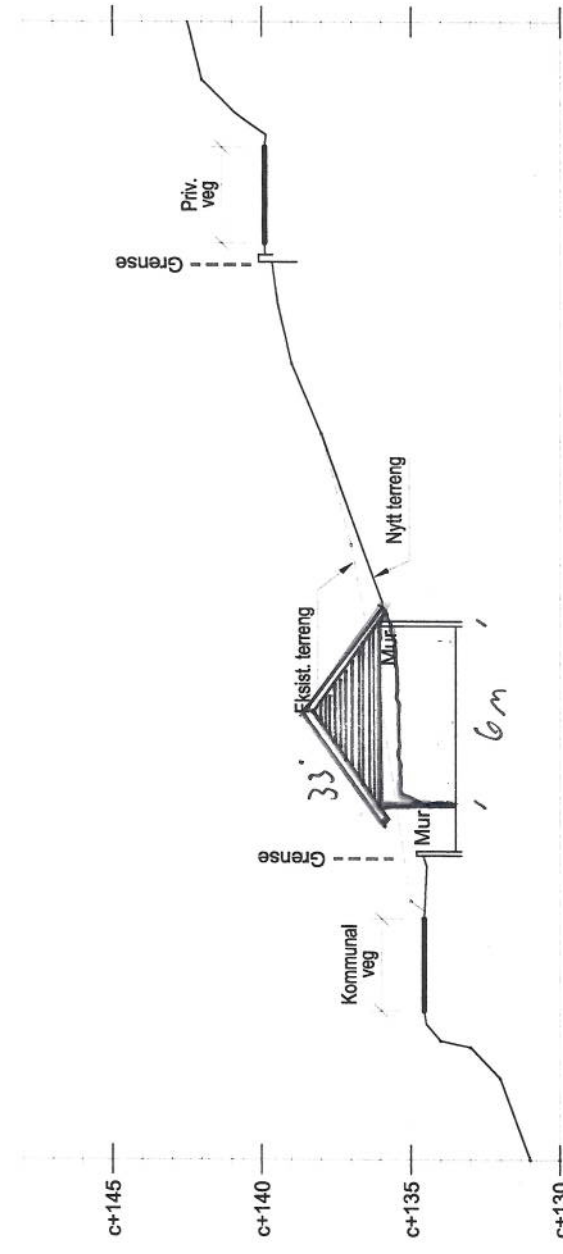

Snitt D-D

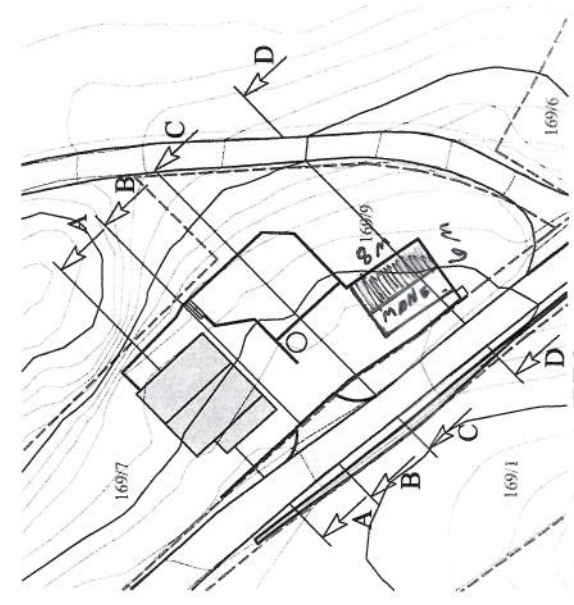

Plan M=1:750

Dato	09.01.2013	DKK	R.Sætre	Målestokk	A3	Leif Arne Risa Skjersundsvegen 21, 4250 Kopervik Tlf 52 83 62 02 Mob 477 55 743
Filnavn		Underlog:		Målestokk	1:250	
<p>Fritidsbolig Ikeland 90, Seim. Gnr 169. Bnr 7. Lindås kommune Terrengprofil</p>						
				<p>Nesbrekka 28, 5912 Seim</p>		