



62

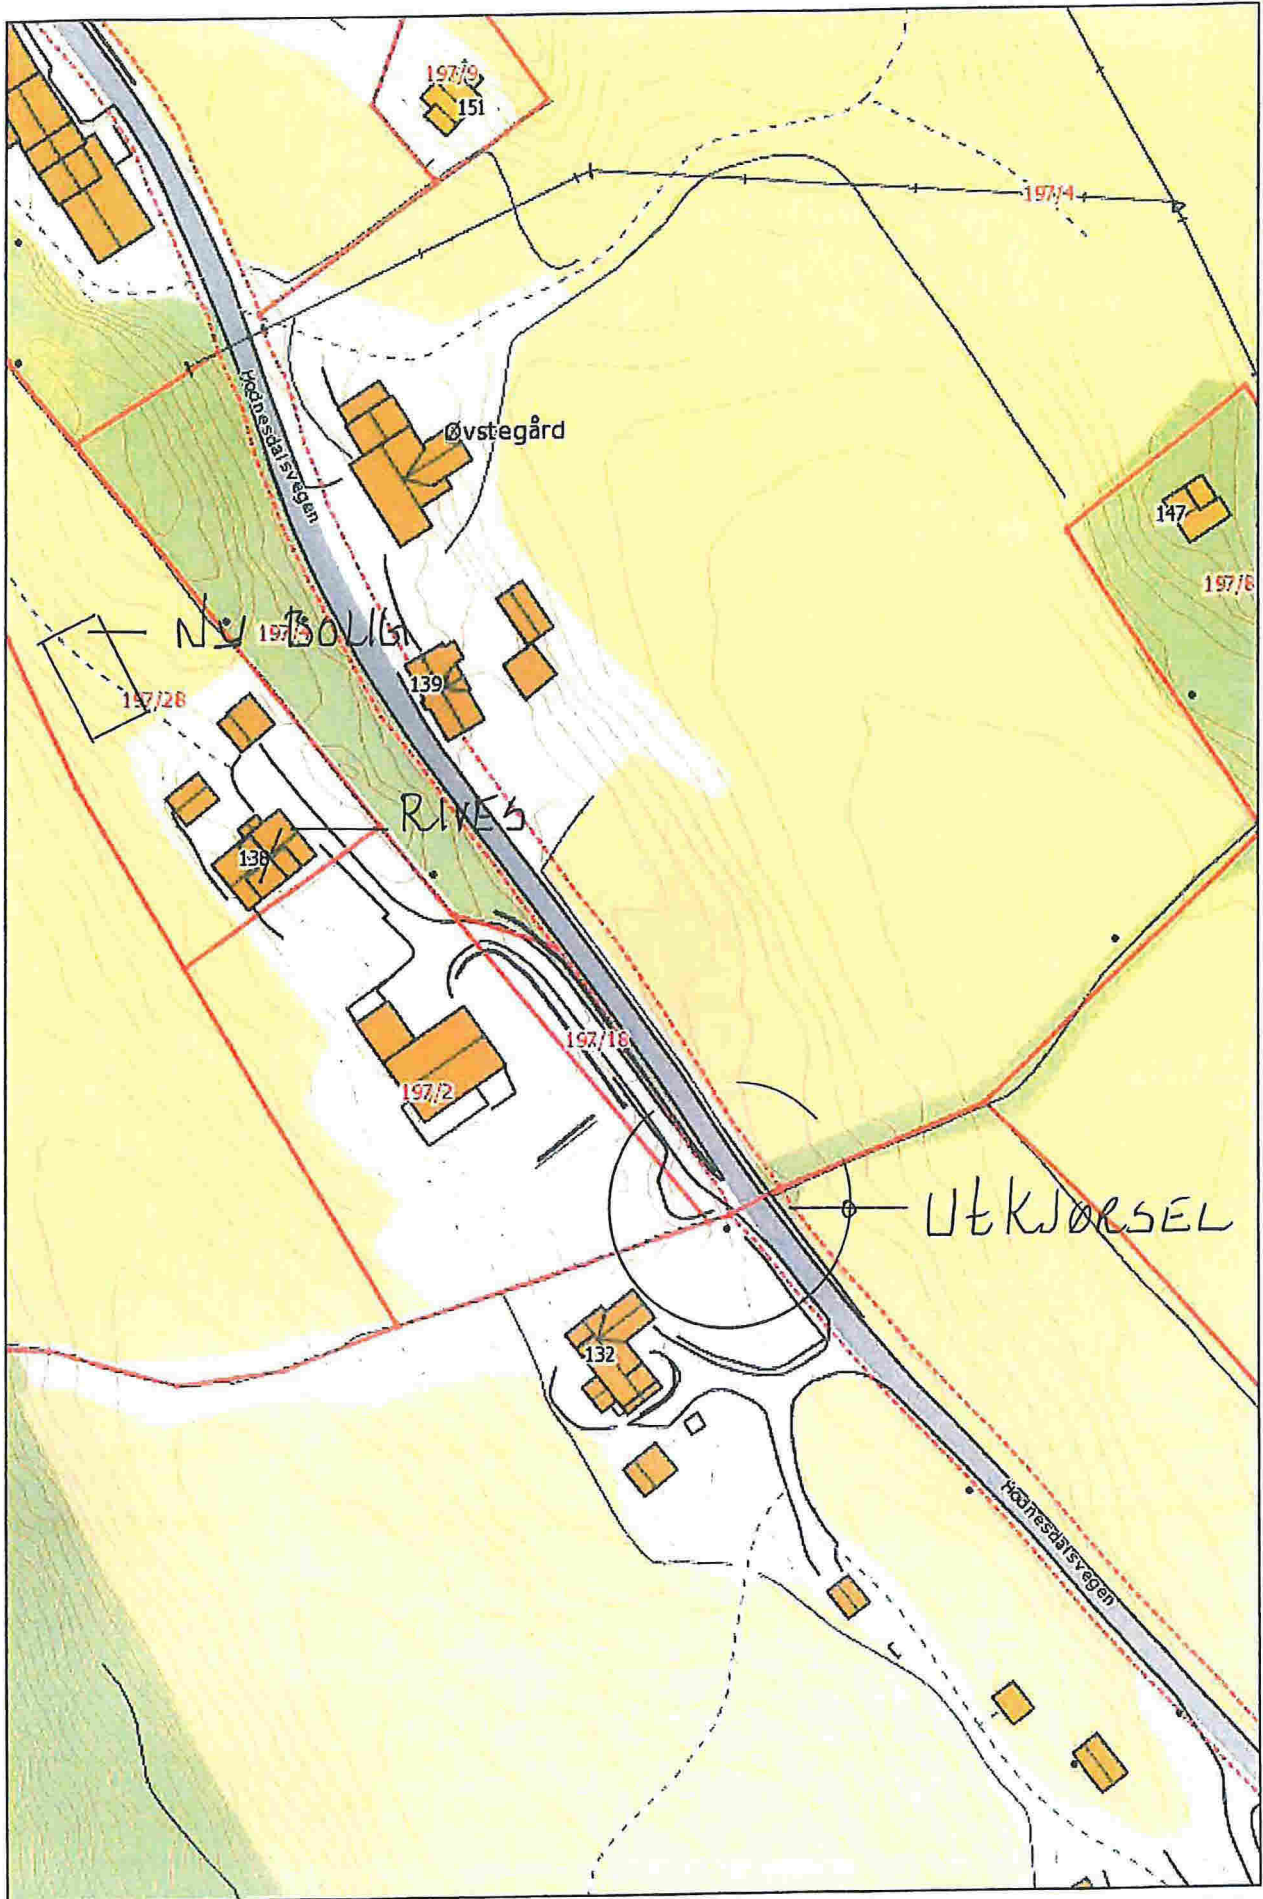

Målestokk: 1:1 000

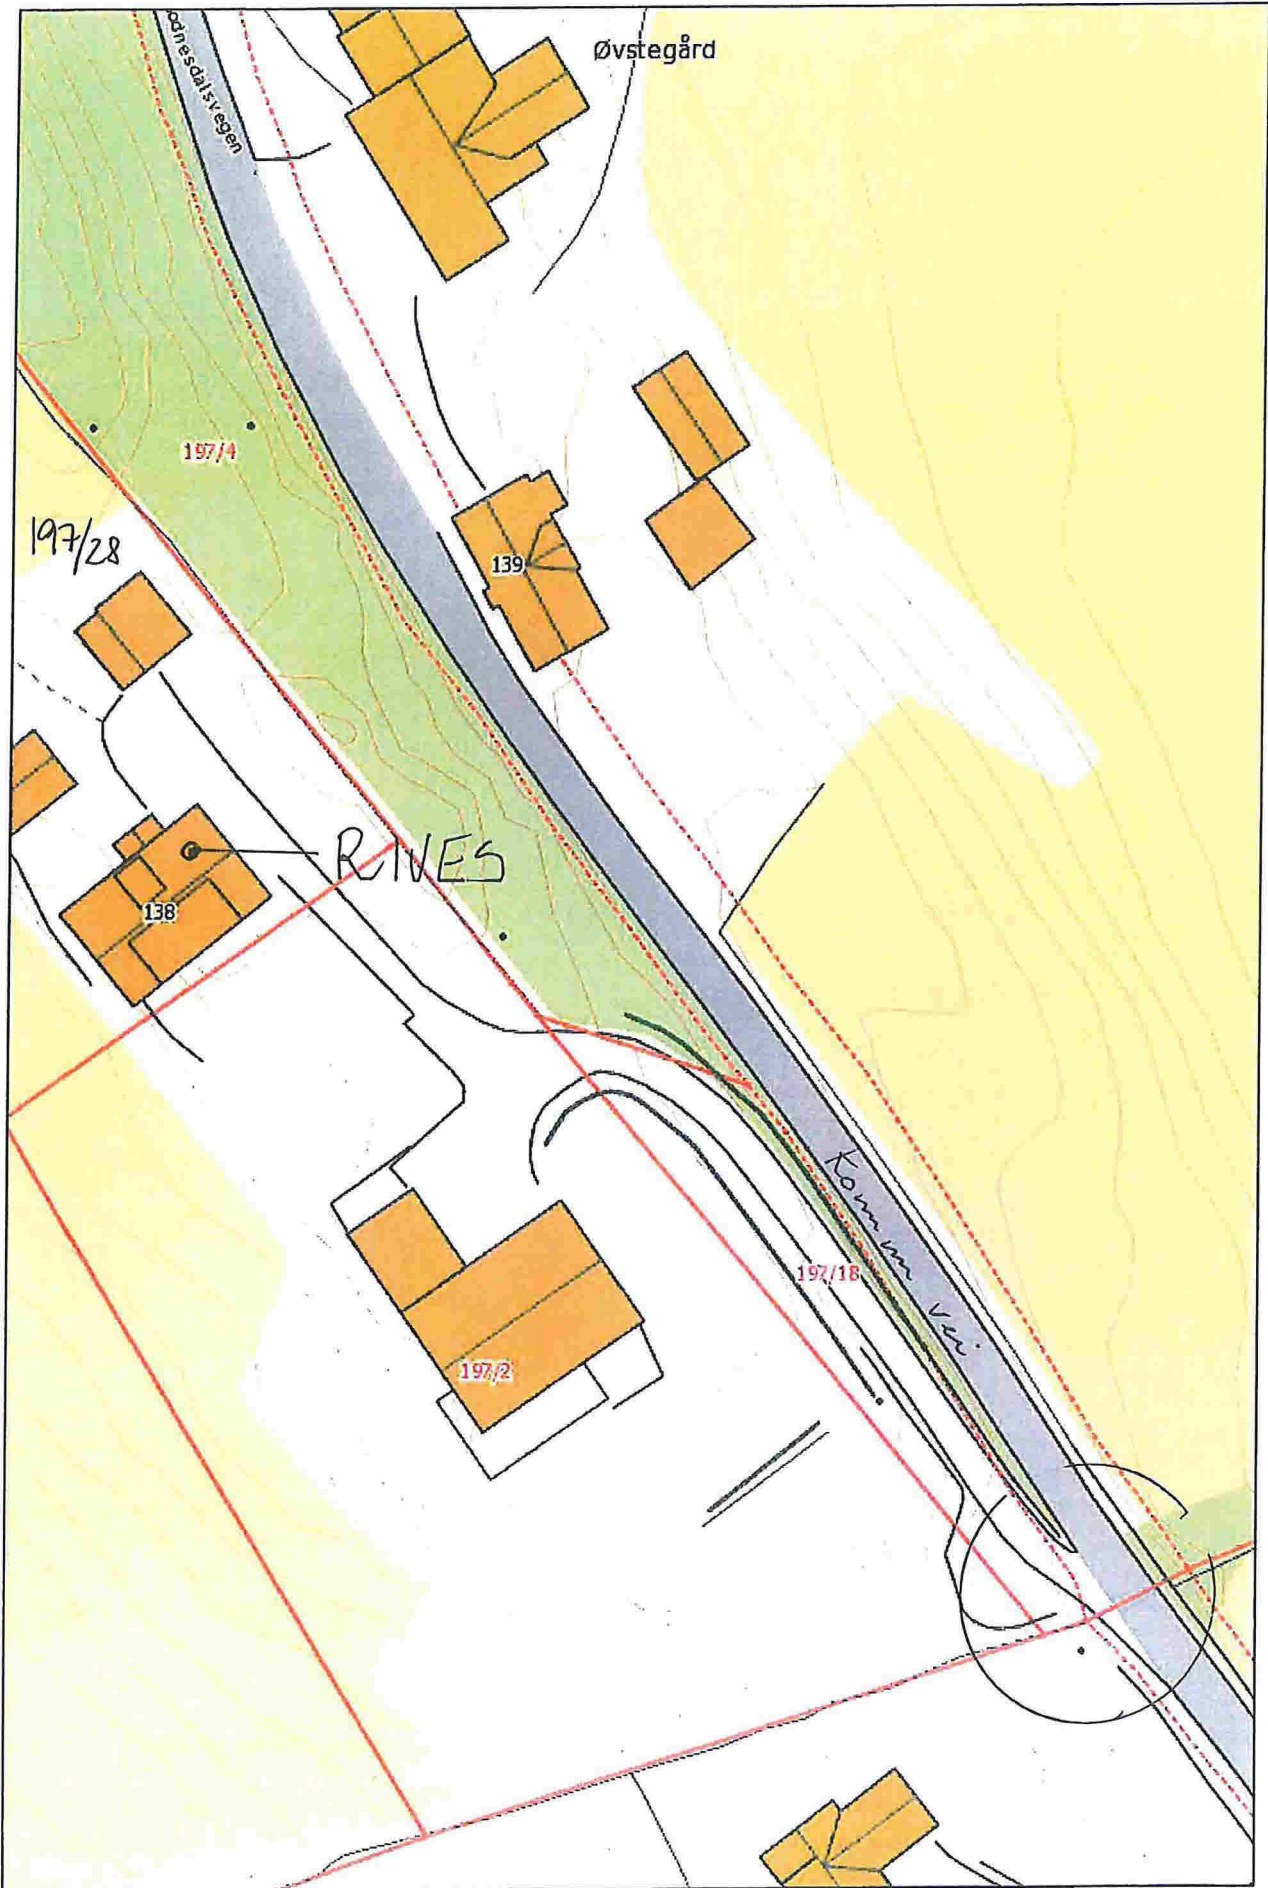

Målestokk: 1:500